



DD 56-169

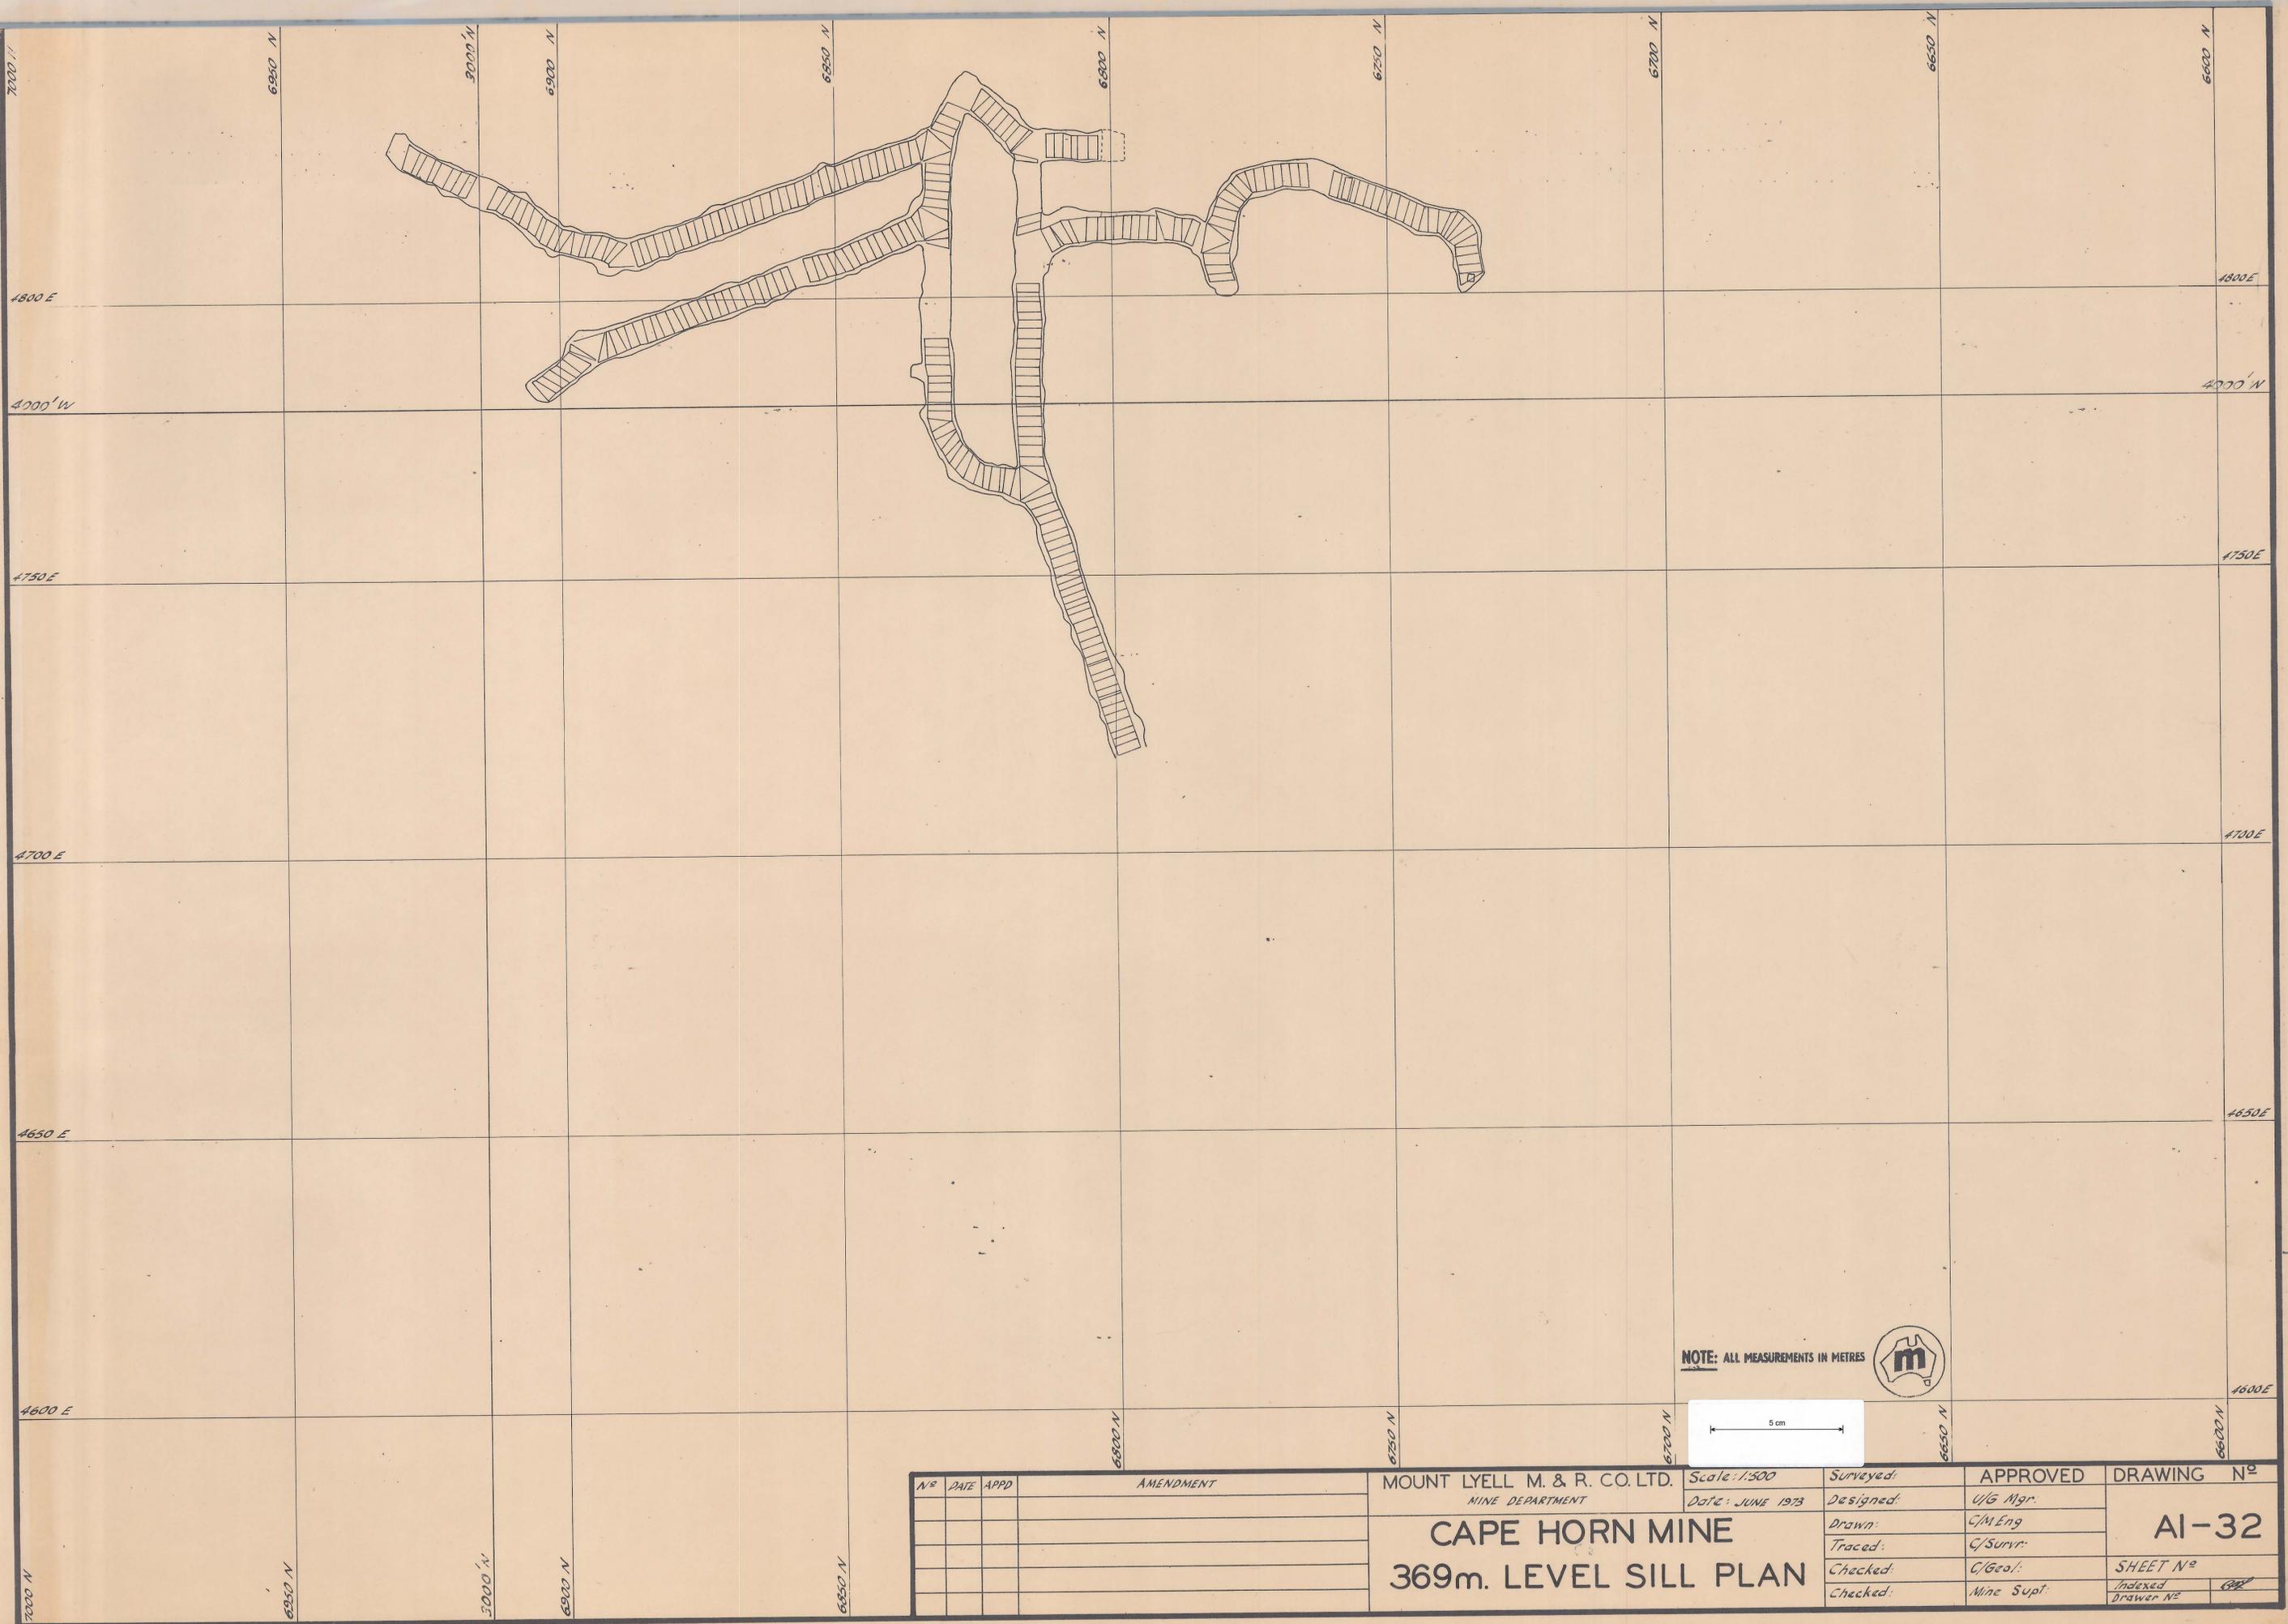

NOTE: ALL MEASUREMENTS IN METRES

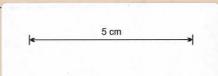

N <sup>o</sup>	DATE	APPD	AMENDMENT

MOUNT LYELL M. & R. CO. LTD.  
MINE DEPARTMENT

**CAPE HORN MINE**  
**369m. LEVEL SILL PLAN**

Scale: 1:500  
Date: JUNE 1973

Surveyed:	APPROVED
Designed:	U/G Mgr.
Drawn:	C/M Eng
Traced:	C/Surr.
Checked:	C/Geol.
Checked:	Mine Supt.

DRAWING N <sup>o</sup>	AI-32
SHEET N <sup>o</sup>	
Indexed	
Drawer N <sup>o</sup>	