



0056-171

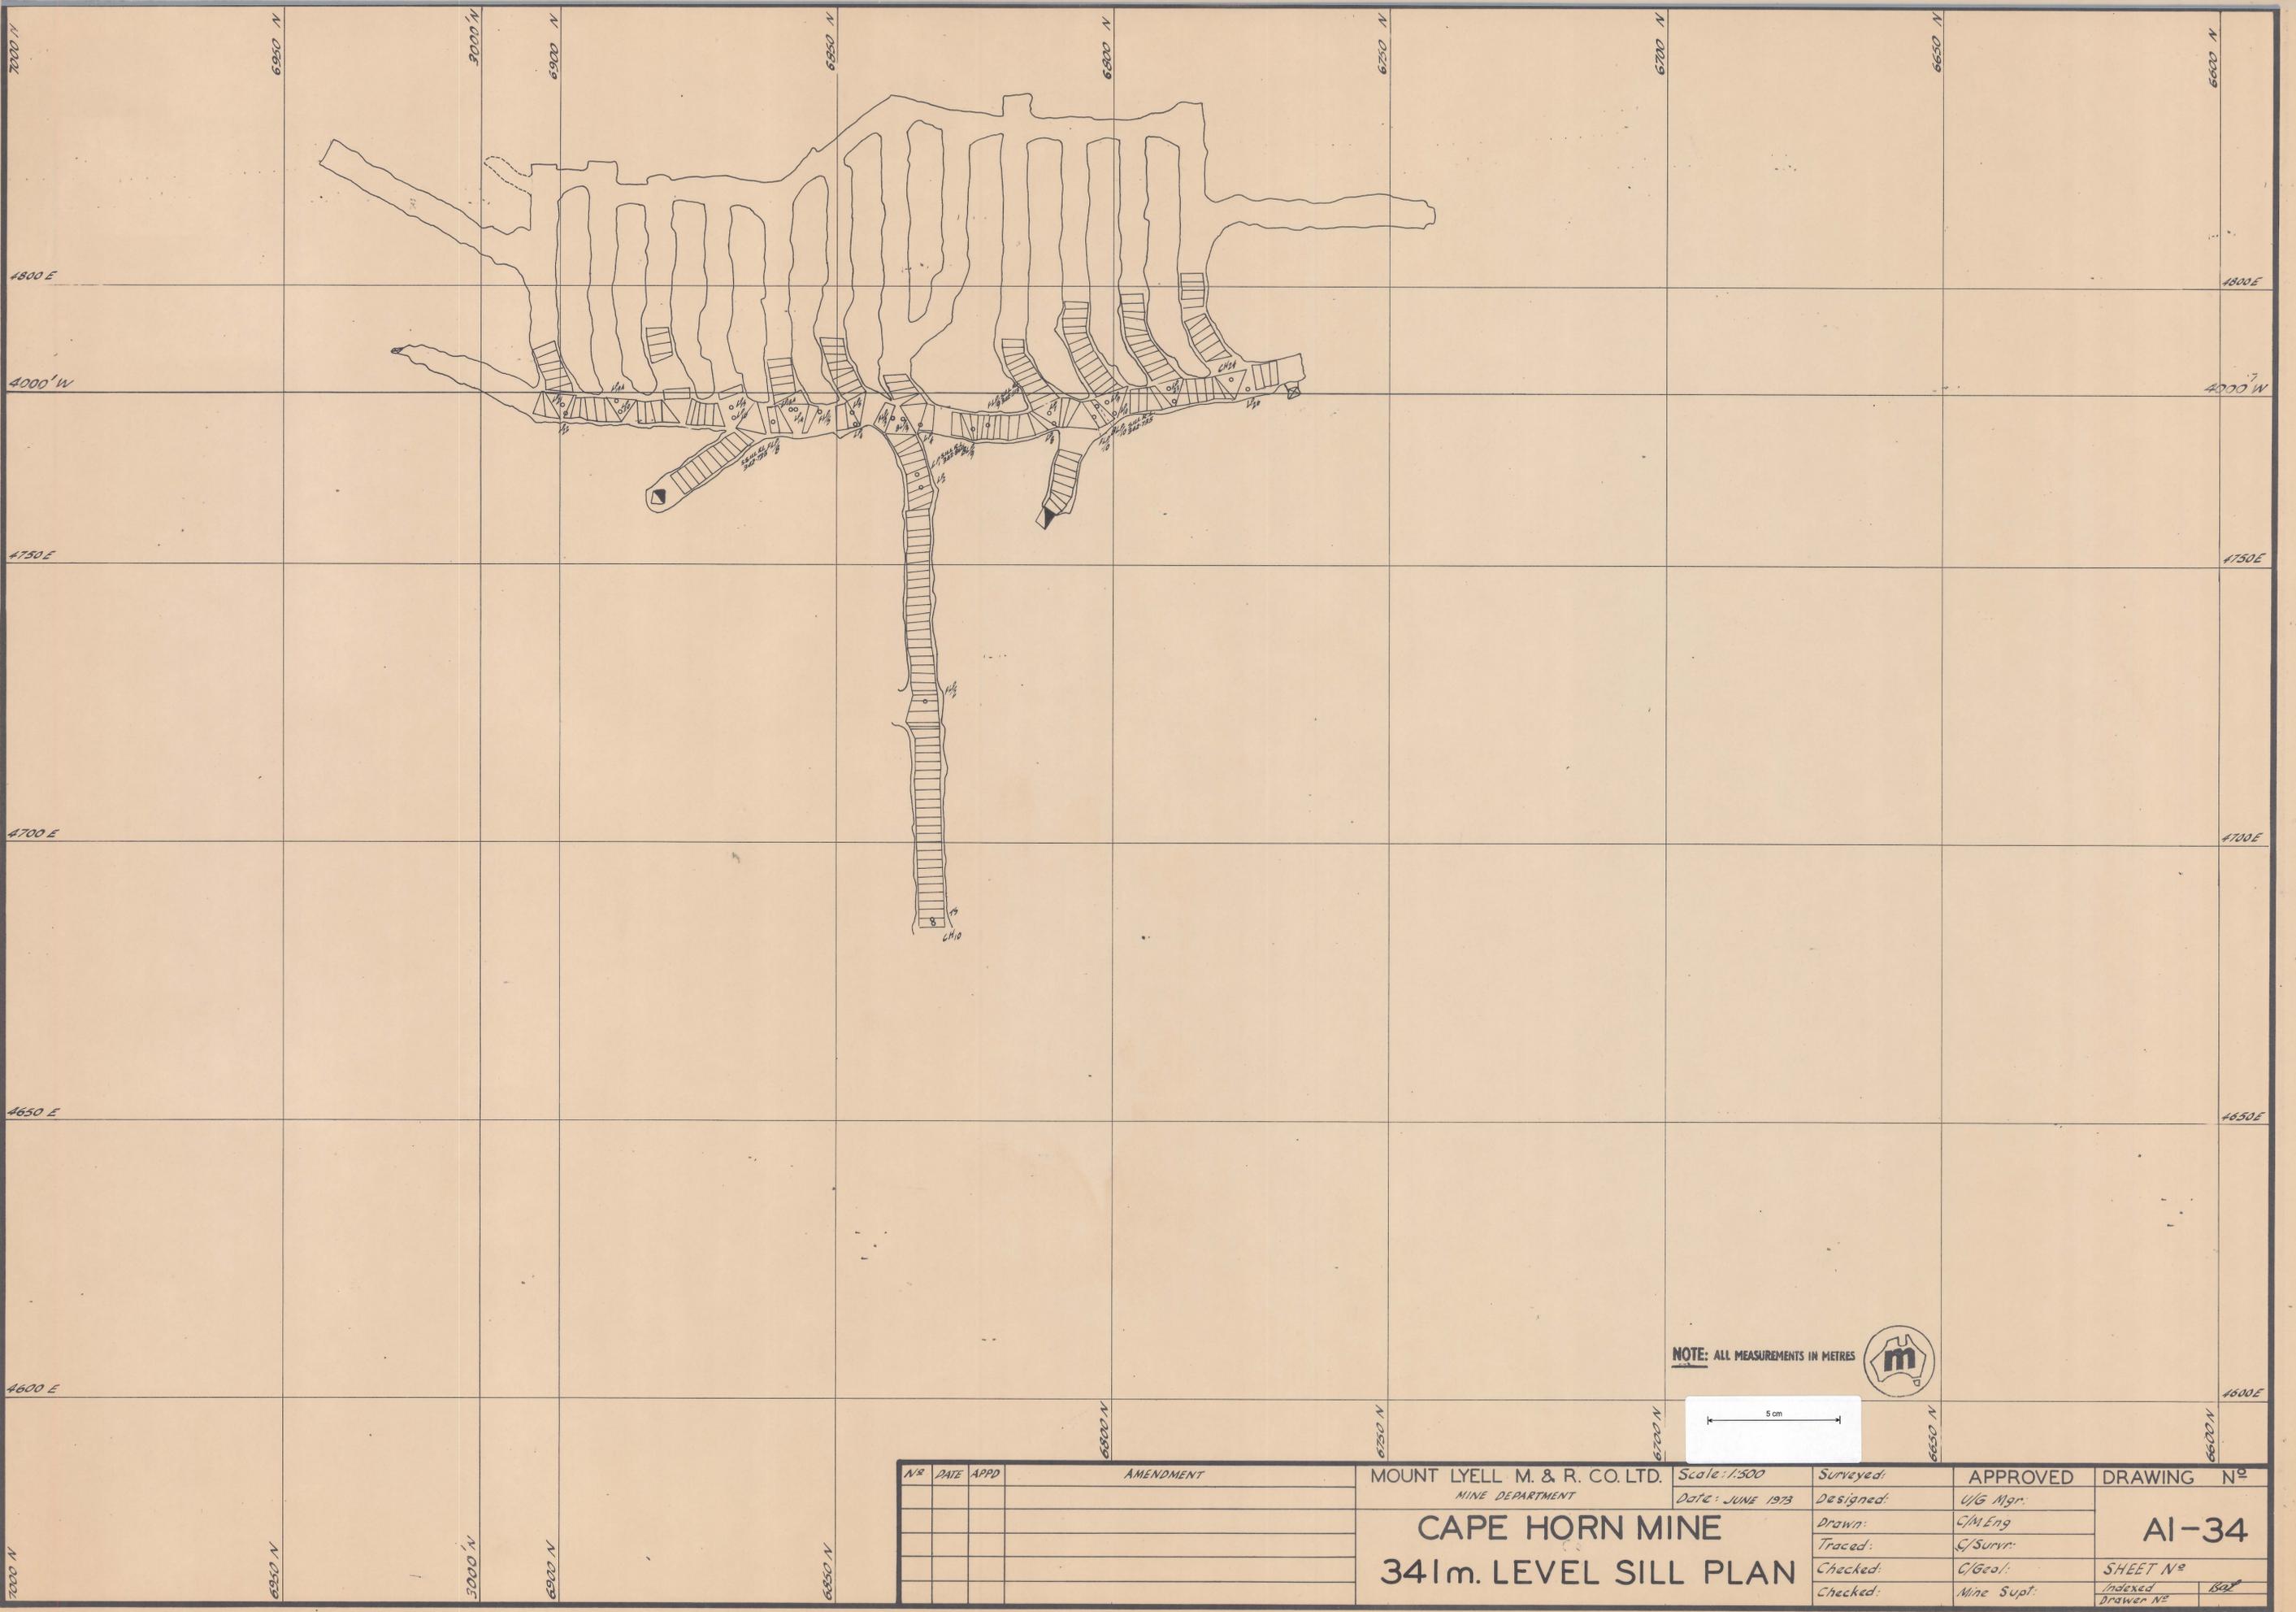

NOTE: ALL MEASUREMENTS IN METRES

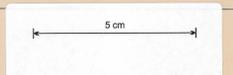

Nº	DATE	APPD	AMENDMENT

MOUNT LYELL M. & R. CO. LTD.
MINE DEPARTMENT

CAPE HORN MINE
341m. LEVEL SILL PLAN

Scale: 1:500
Date: JUNE 1973

Surveyed:
Designed:
Drawn:
Traced:
Checked:
Checked:

APPROVED
U/G Mgr.
C/M Eng
G/Surv.
C/Geol.
Mine Supt.

DRAWING Nº
AI-34
SHEET Nº
Indexed
Drawn Nº