


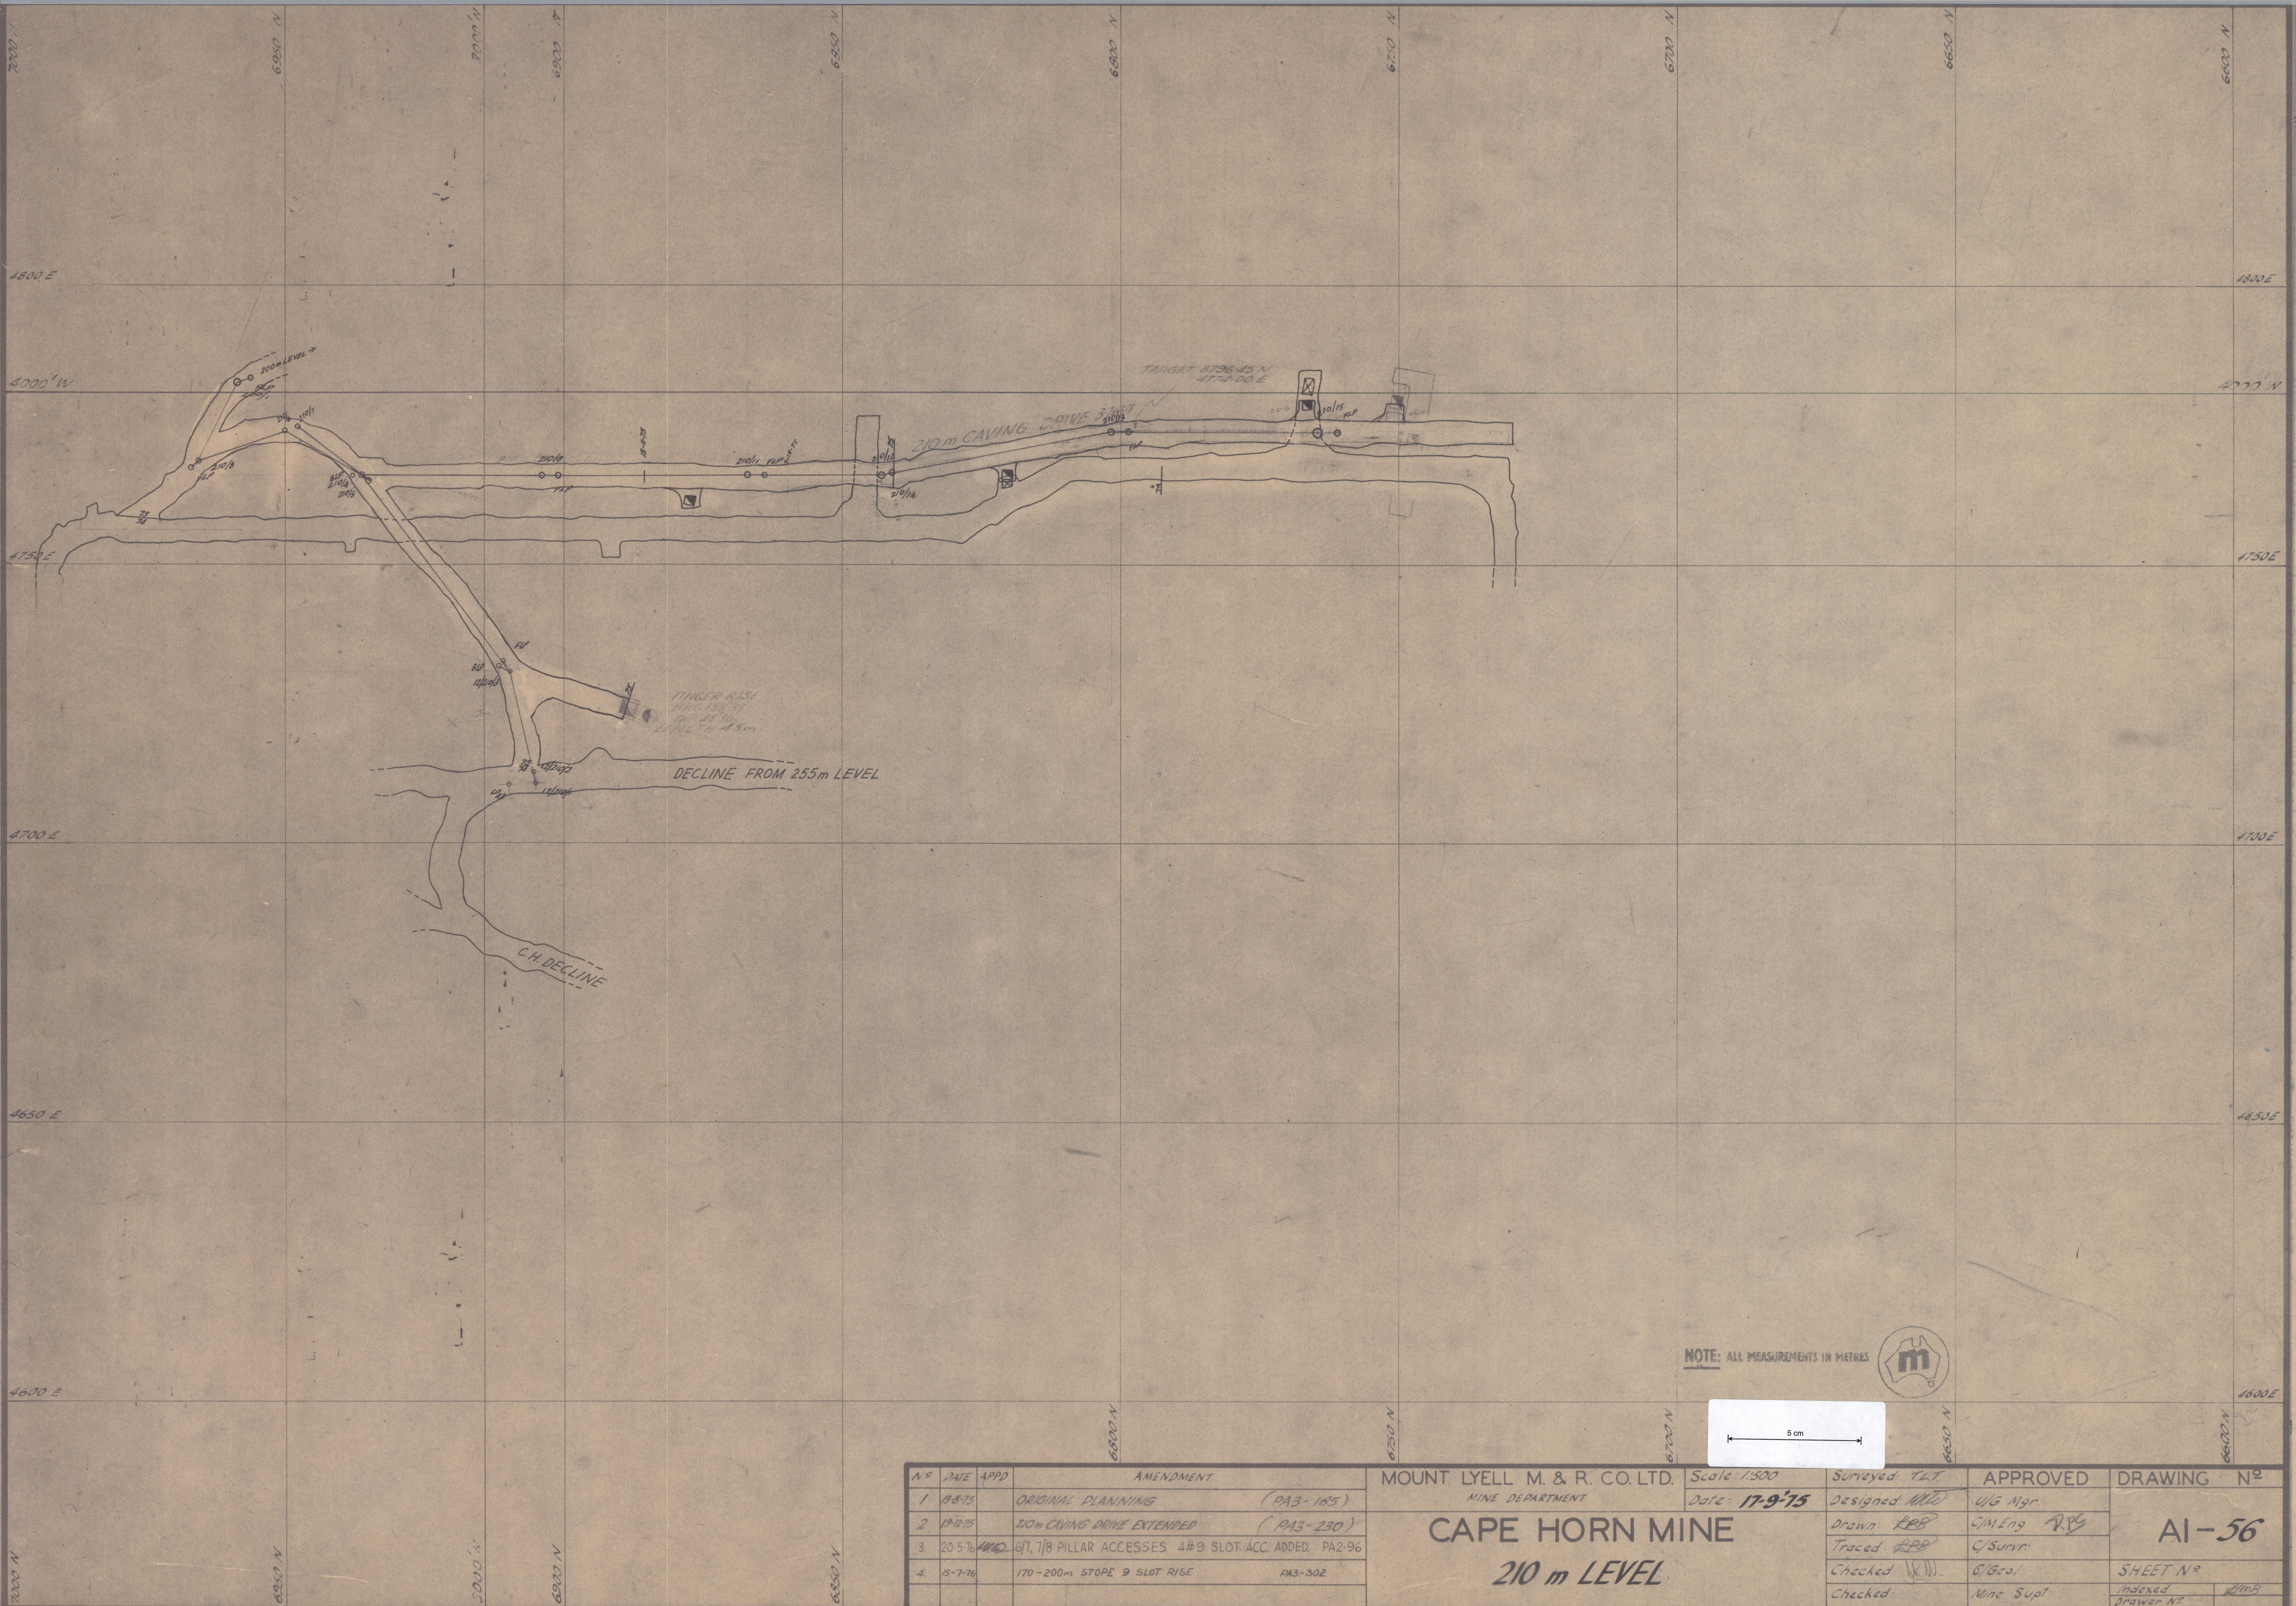

N ^o		DATE	APPD	AMENDMENT		MOUNT LYELL M. & R. CO. LTD.		Scale: 1:500	Surveyed: T.L.T.	APPROVED		DRAWING N ^o
1		18-8-75		ORIGINAL PLANNING (PA3-185)		MINE DEPARTMENT		Date: 17-9-75	Designed: MLD	U/G Mgr.		AI-56
2		19-12-75		210m CAVING DRIVE EXTENDED (PA3-230)		CAPE HORN MINE 210 m LEVEL			Drawn: LPP	C/M Eng. RPS		
3		20-5-76	MLD	6/7, 7/8 PILLAR ACCESSSES 4#9 SLOT ACC. ADDED. PA2-96					Traced: LPP	C/Surv.		
4		15-7-76		170-200m STOPE 9 SLOT RISE PA3-302					Checked: K.W.	C/Geo.		
									Checked:	Mine Supt.		SHEET N ^o
												Indexed
												Drawer N ^o