


0056-179

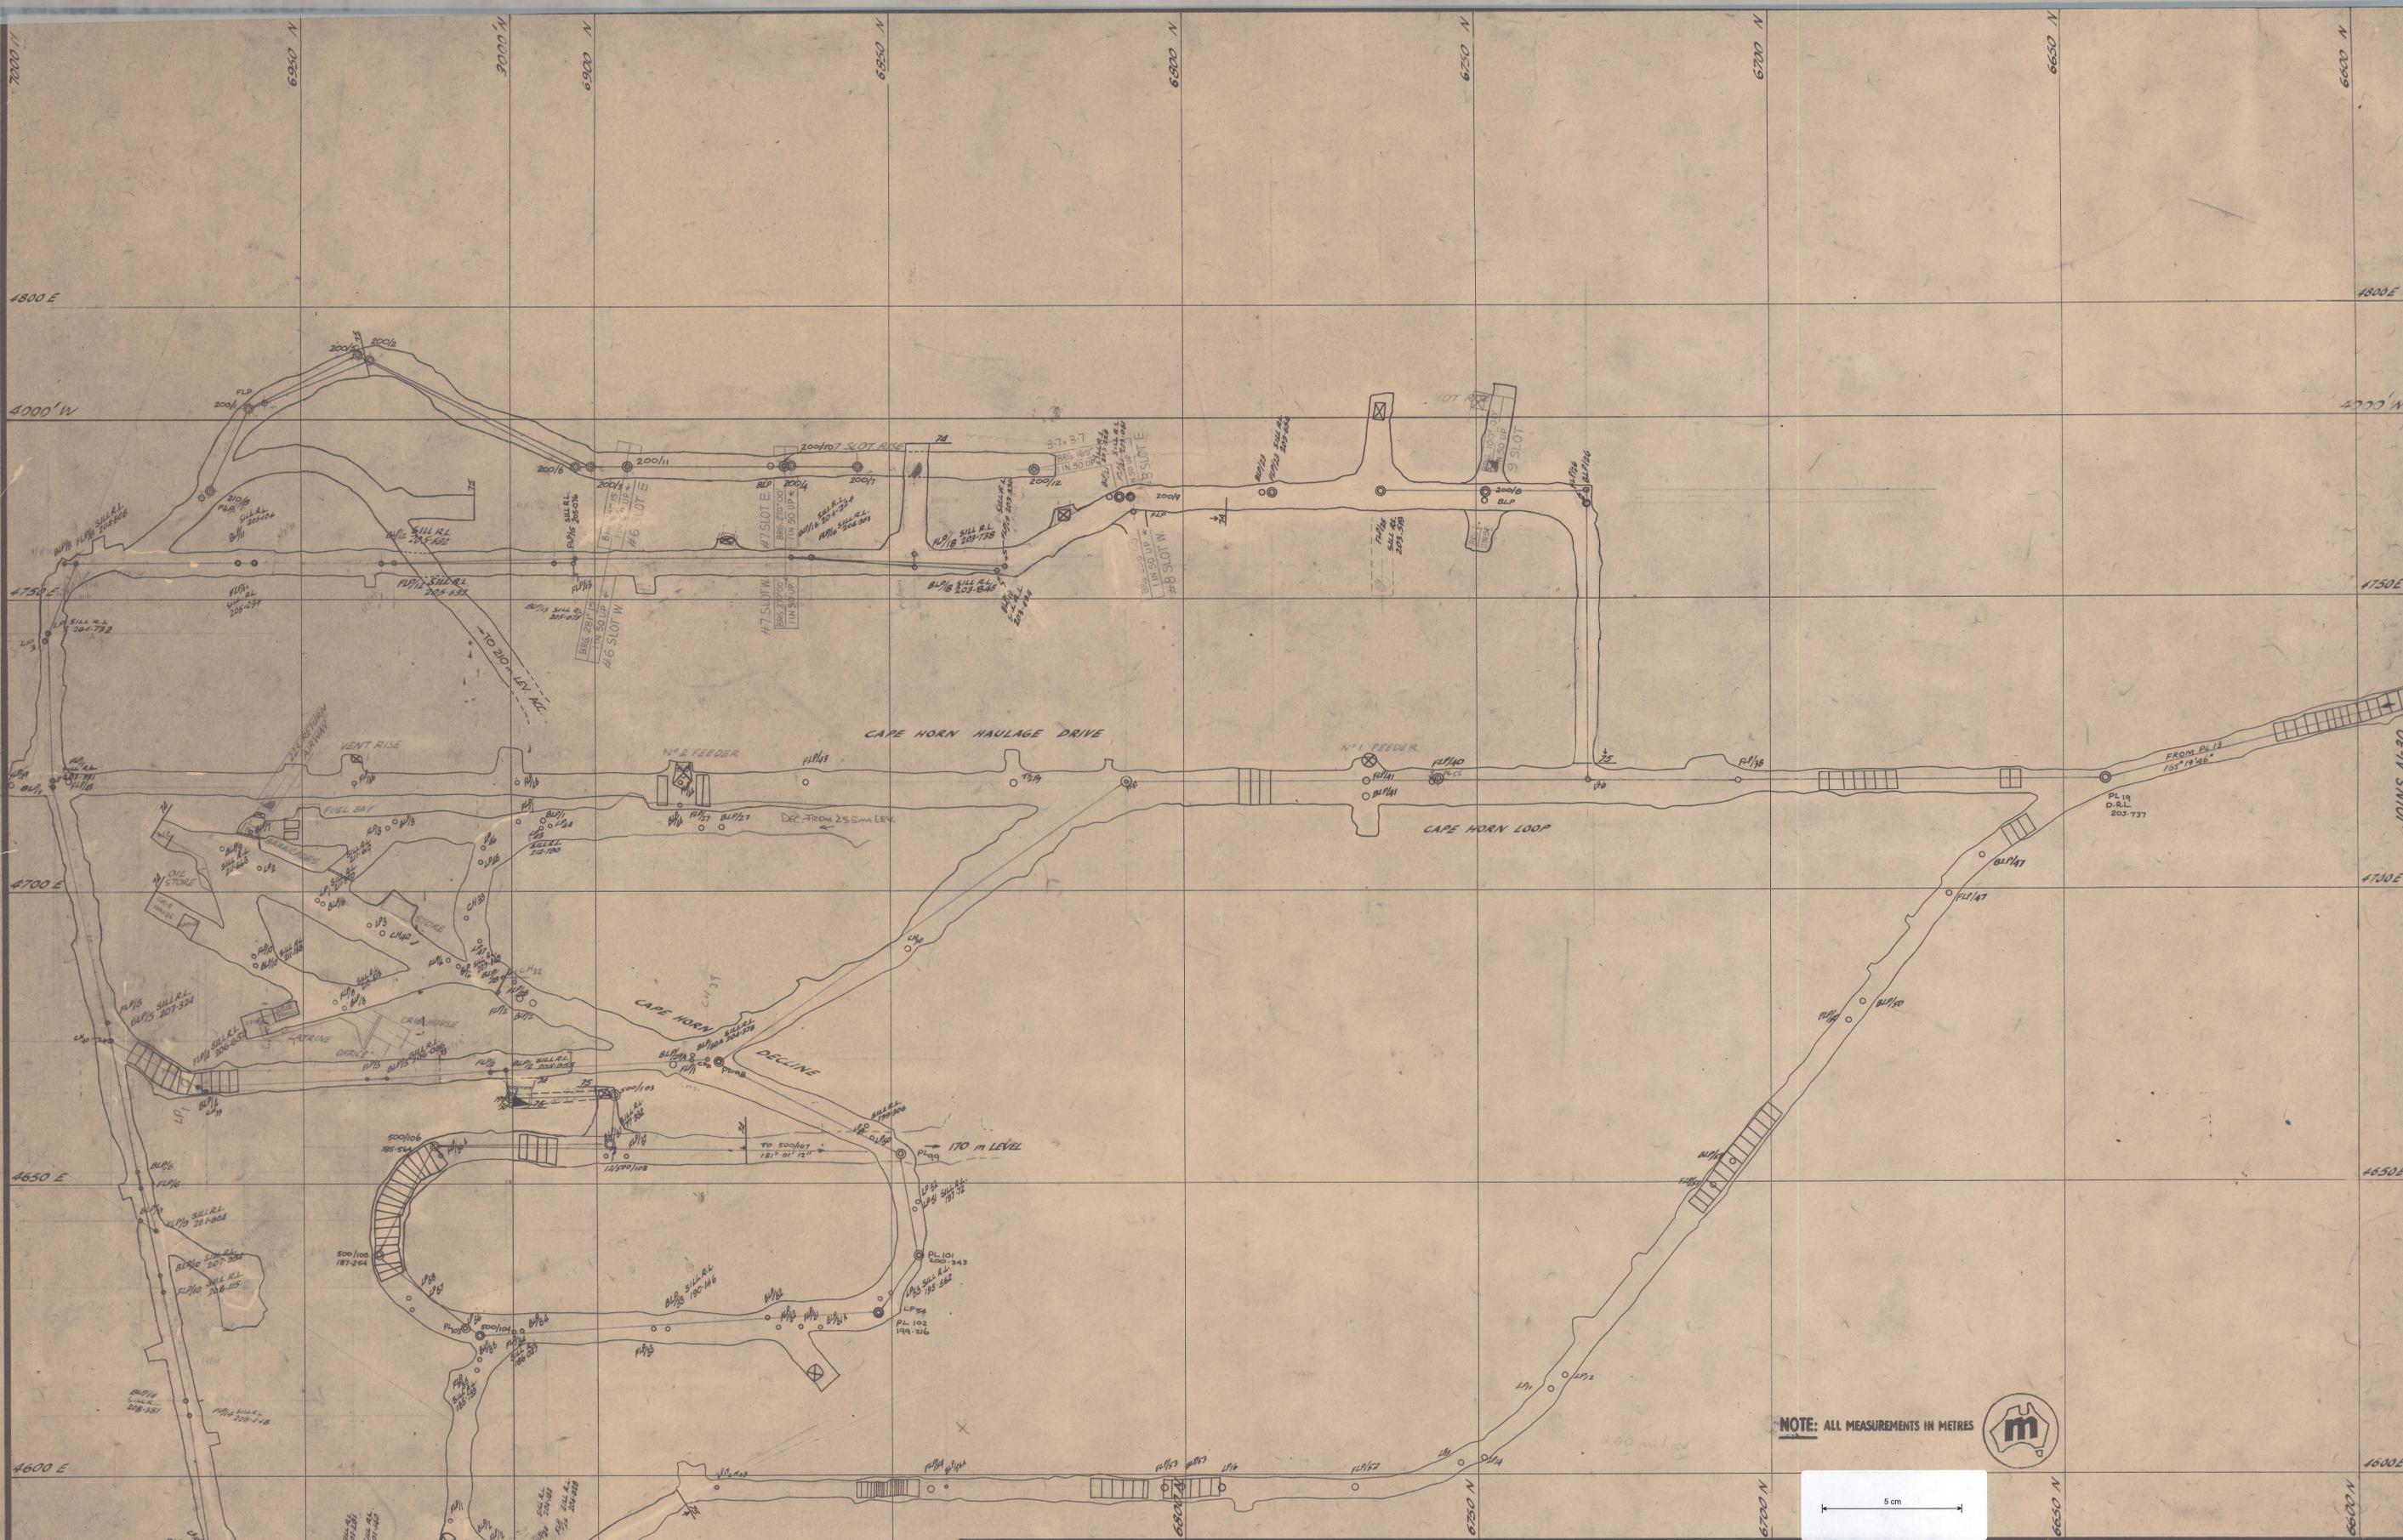

NOTE: ALL MEASUREMENTS IN METRES



NO	DATE	APPD	AMENDMENT
1.	19-5-76	MURP	STOPE 6,7,8 & 9 SLOT DEVELOPMENT ADDED. PA2-95
2.	15-7-76		170-200m STOPE 9 SLOT RISE PA3-302

MOUNT LYELL M. & R. CO. LTD.
MINE DEPARTMENT
CAPE HORN MINE
RETURN AIRWAY -
200m LEVEL

Scale: 1:500
Date: OCTOBER 1973

Surveyed:	APPROVED
Designed:	U/G Mgr.
Drawn:	C/M Eng.
Traced:	C/Surv.
Checked:	C/Geo.
Checked:	Mine Supt.

DRAWING N^o
AI-43
SHEET N^o
Indexed
Drawer N^o