


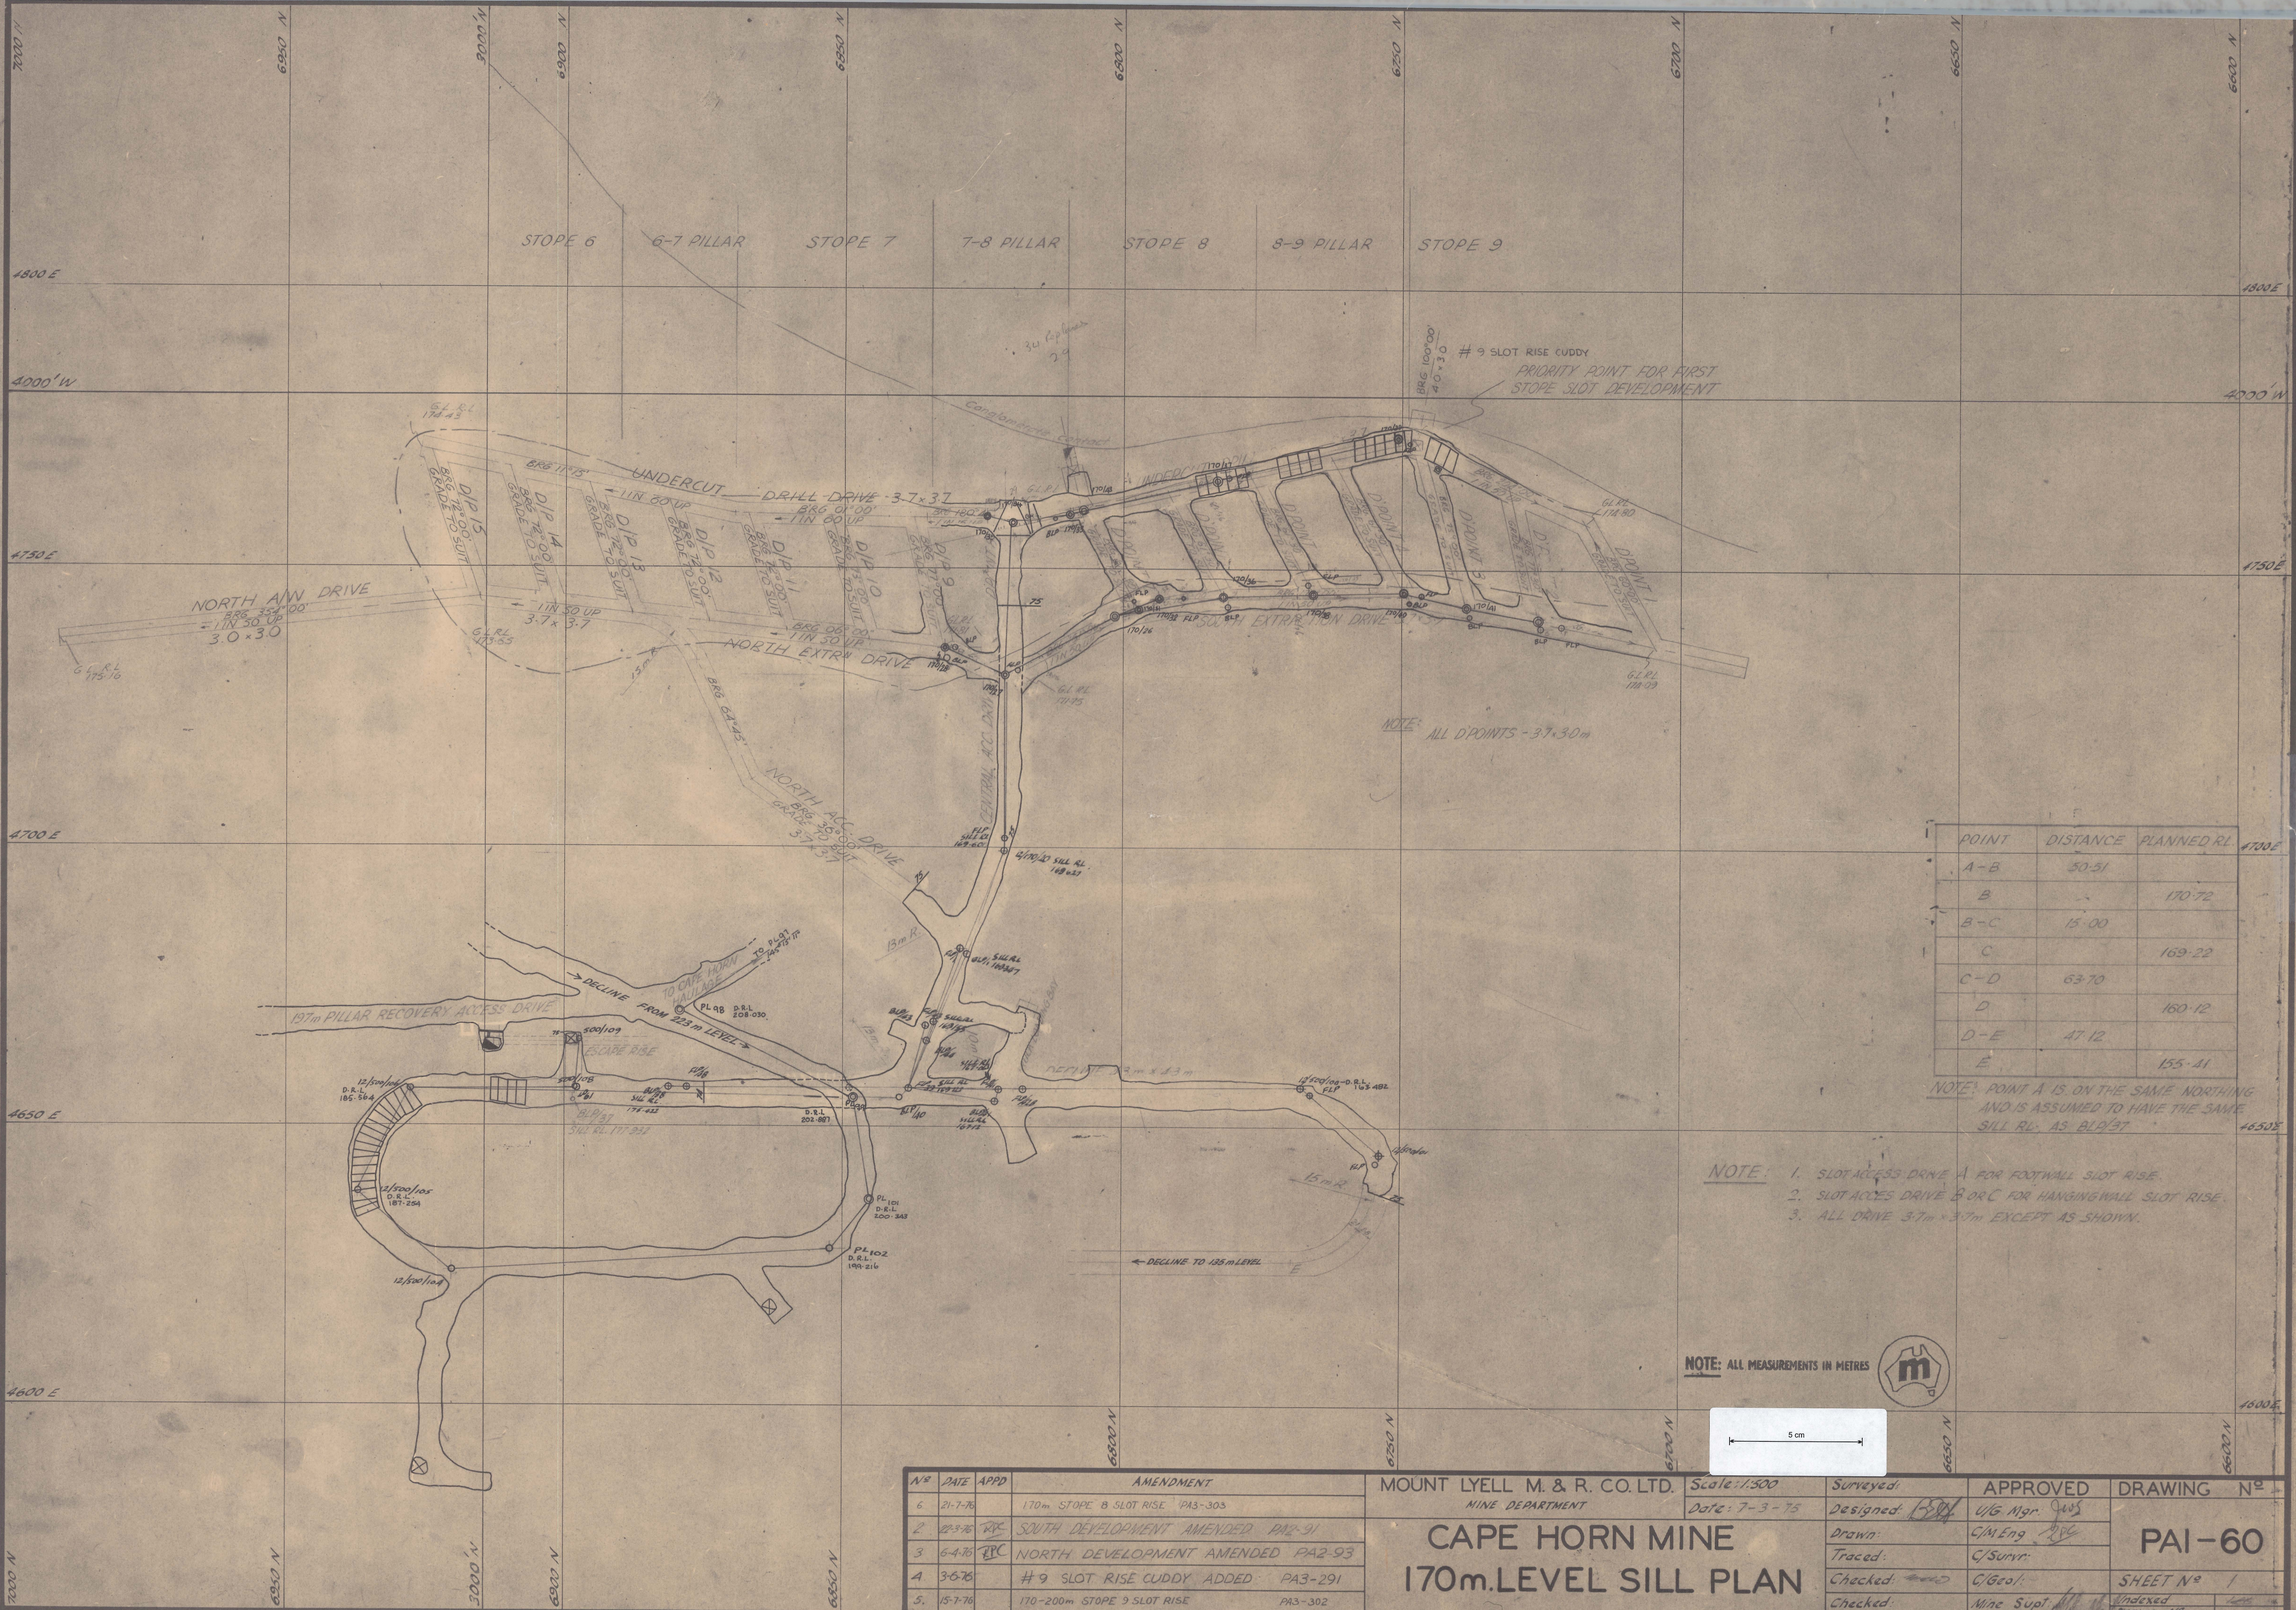

POINT	DISTANCE	PLANNED RL
A-B	50.51	170.72
B		170.72
B-C	15.00	169.22
C		169.22
C-D	63.70	160.12
D		160.12
D-E	47.12	155.41
E		155.41

NOTE: POINT A IS ON THE SAME NORTHING AND IS ASSUMED TO HAVE THE SAME SILL RL. AS BLD/37

- NOTE:
1. SLOT ACCESS DRIVE A FOR FOOTWALL SLOT RISE.
 2. SLOT ACCESS DRIVE B OR C FOR HANGINGWALL SLOT RISE.
 3. ALL DRIVE 3.7m x 3.7m EXCEPT AS SHOWN.

NOTE: ALL MEASUREMENTS IN METRES



5m

Nº	DATE	APPD	AMENDMENT	MOUNT LYELL M. & R. CO. LTD. MINE DEPARTMENT	Scale: 1:500 Date: 7-3-75	Surveyed: Designed: [Signature] Drawn: Traced: Checked: [Signature] Checked:	APPROVED U/G Mgr. [Signature] C/Eng. [Signature] C/Supv. C/Geo. Mine Supt. [Signature]	DRAWING Nº PAI-60 SHEET Nº 1 Indexed Drawn Nº
6	21-7-76		170m STOPE 8 SLOT RISE PA3-303					
2	22-3-76	EC	SOUTH DEVELOPMENT AMENDED PA2-91					
3	6-4-76	EC	NORTH DEVELOPMENT AMENDED PA2-93					
4	3-6-76		#9 SLOT RISE CUDDY ADDED PA3-291					
5	15-7-76		170-200m STOPE 9 SLOT RISE PA3-302					

CAPE HORN MINE 170m LEVEL SILL PLAN