


57-02

5 cm

Hand marking 140

# ZEEHAN SOUTH COMSTOCK MINE

SCALE 25 FEET TO 1 INCH

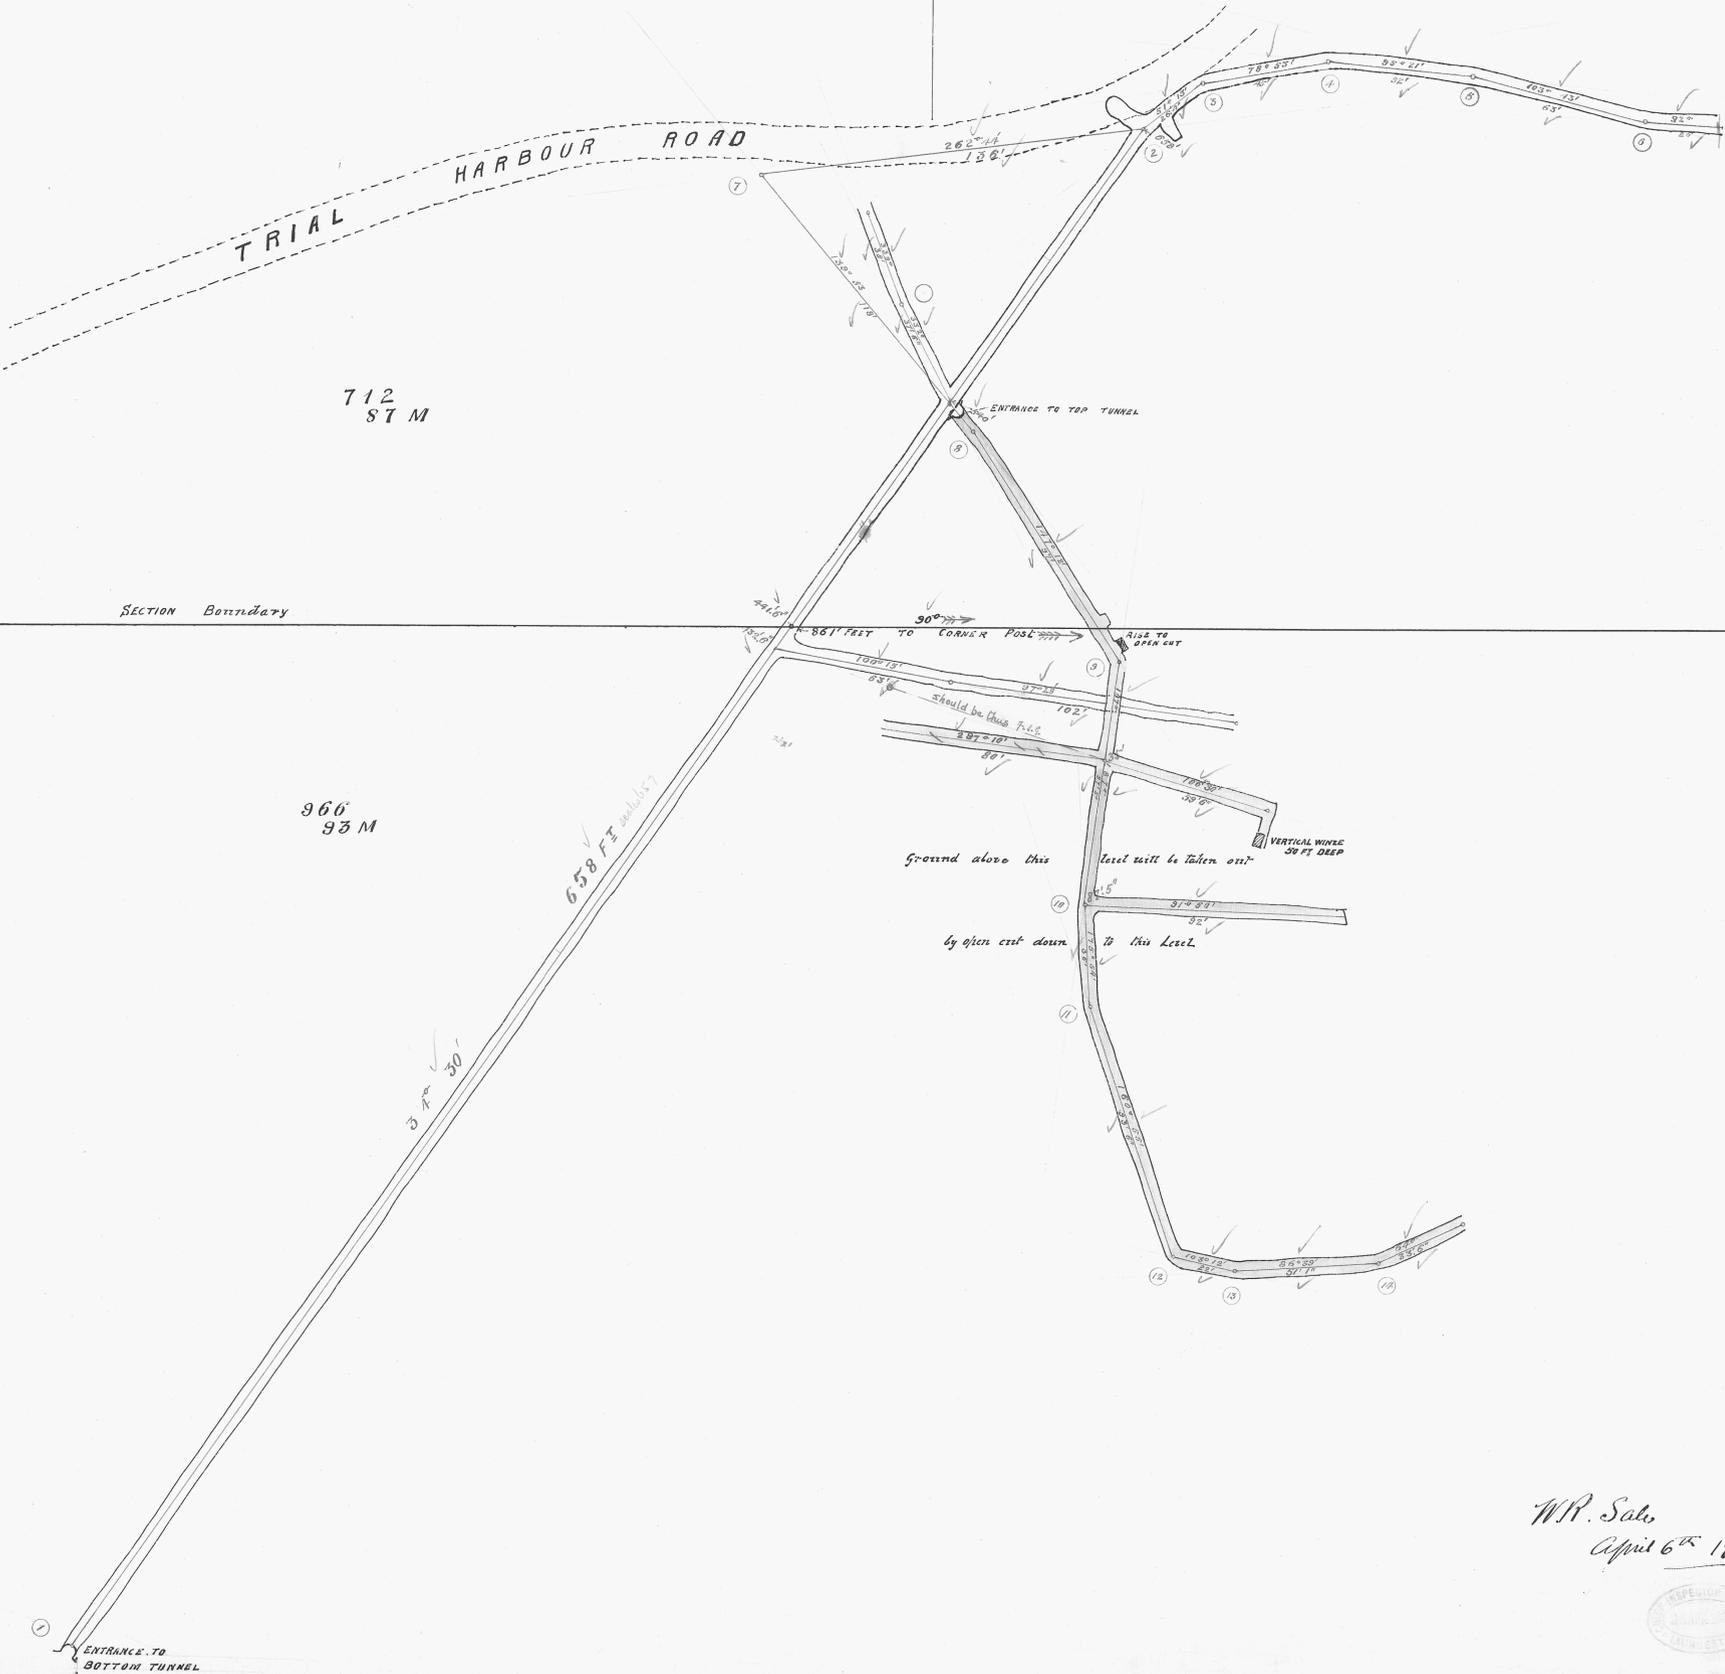

W.P. Sato  
April 6<sup>th</sup> 1903

