


87

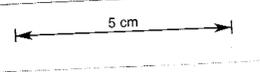


57-03

J. H. Sawyer
 Certified office of surveyor
 Quebec 30/3/03

Wm. H. Johnston
 1901

COMSTOCK S. M. CO. N. L.
 — Scale 25 Ft. to 1 in. —

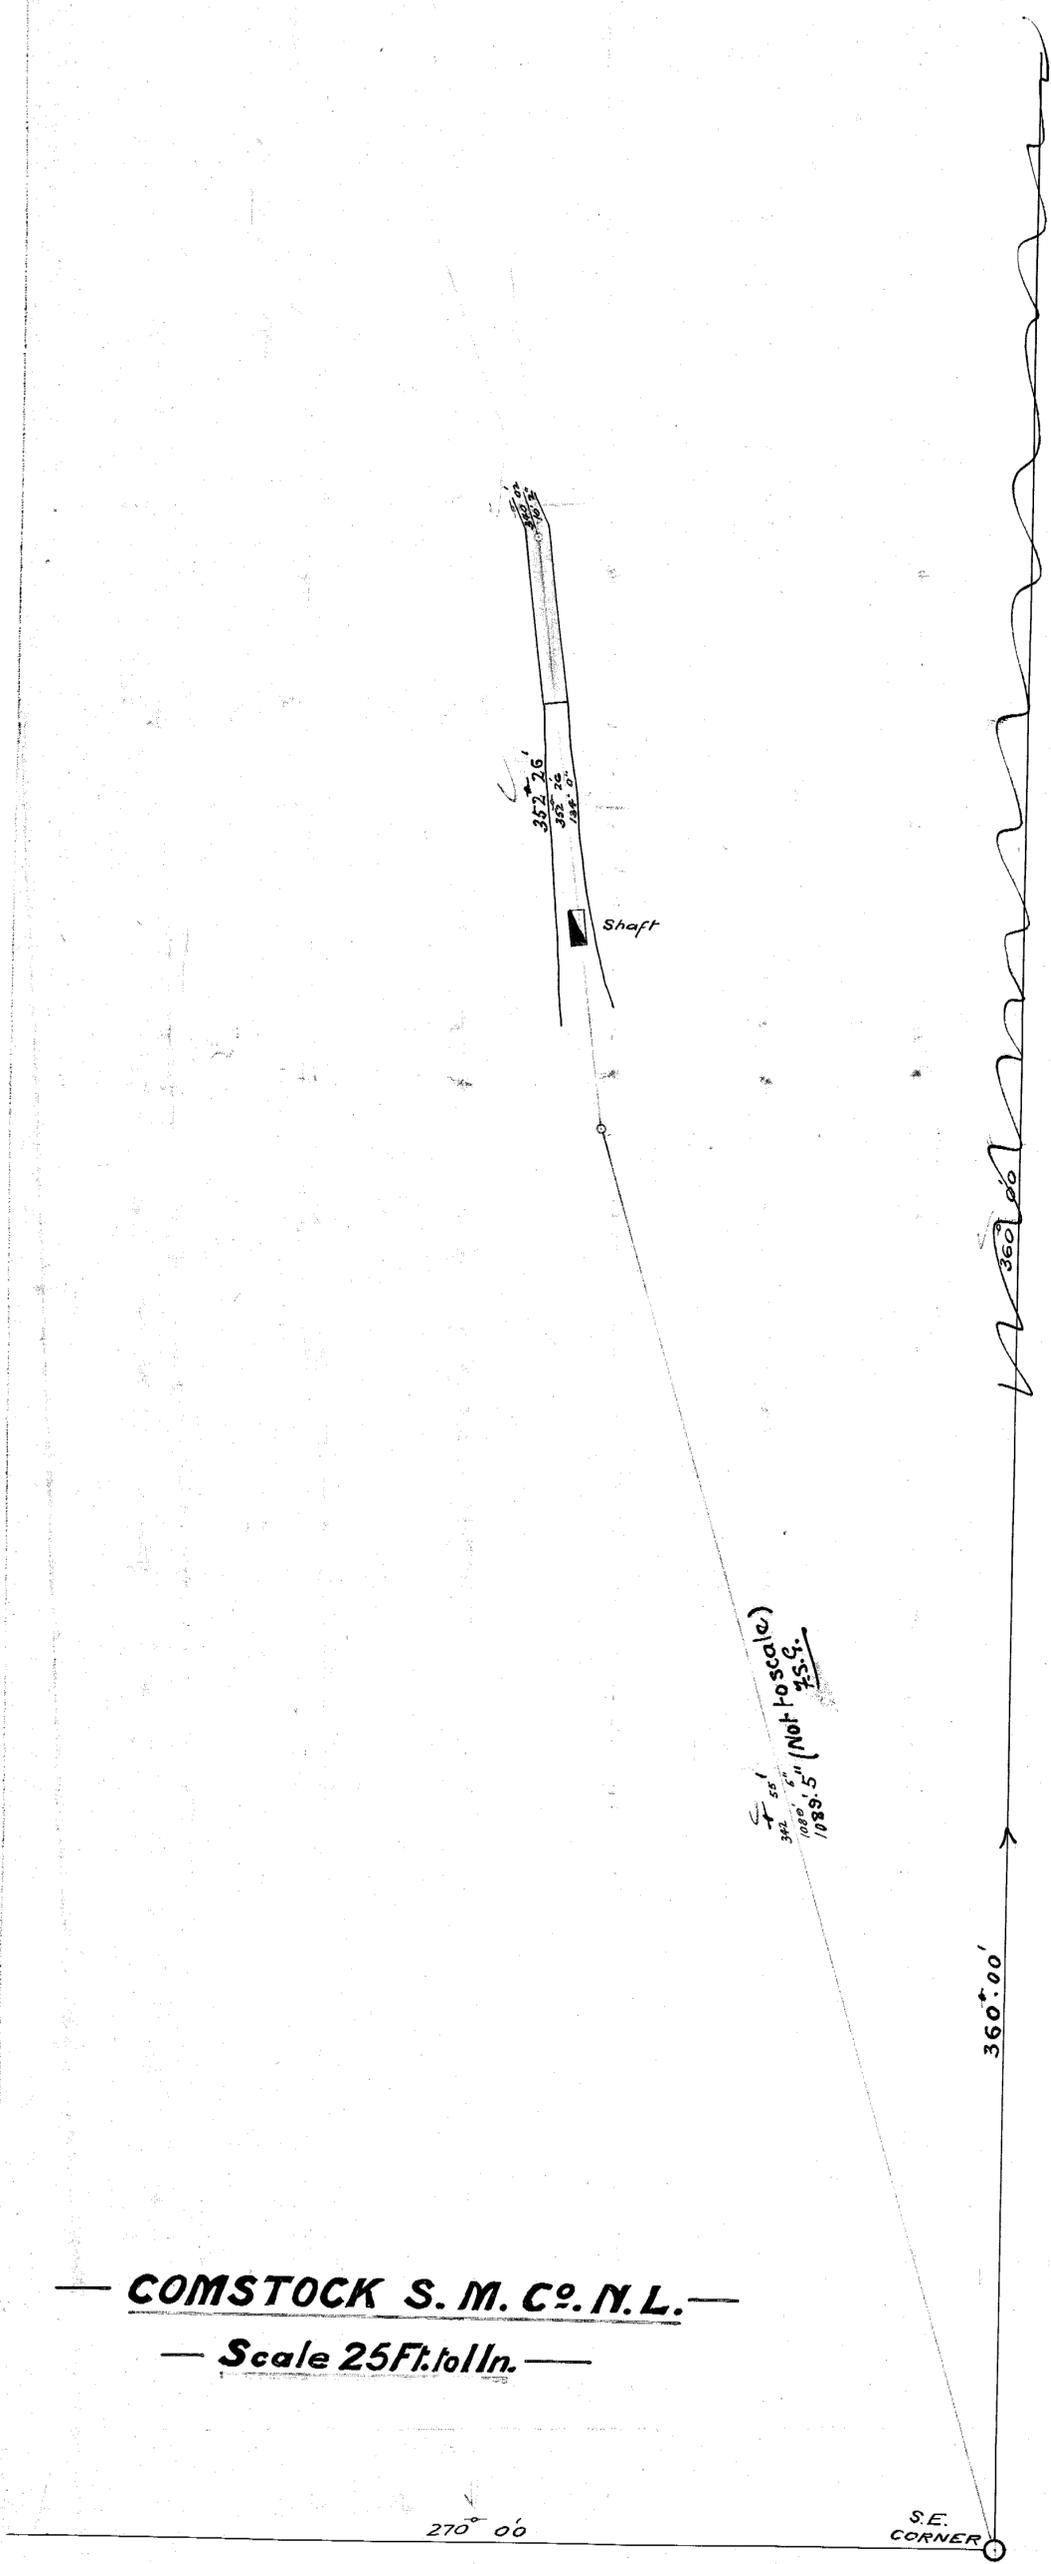

88

1170