



Block 10 Comstock Mine. Zeehan.
Gross Section.


Showing behaviour of Watson's Formation.

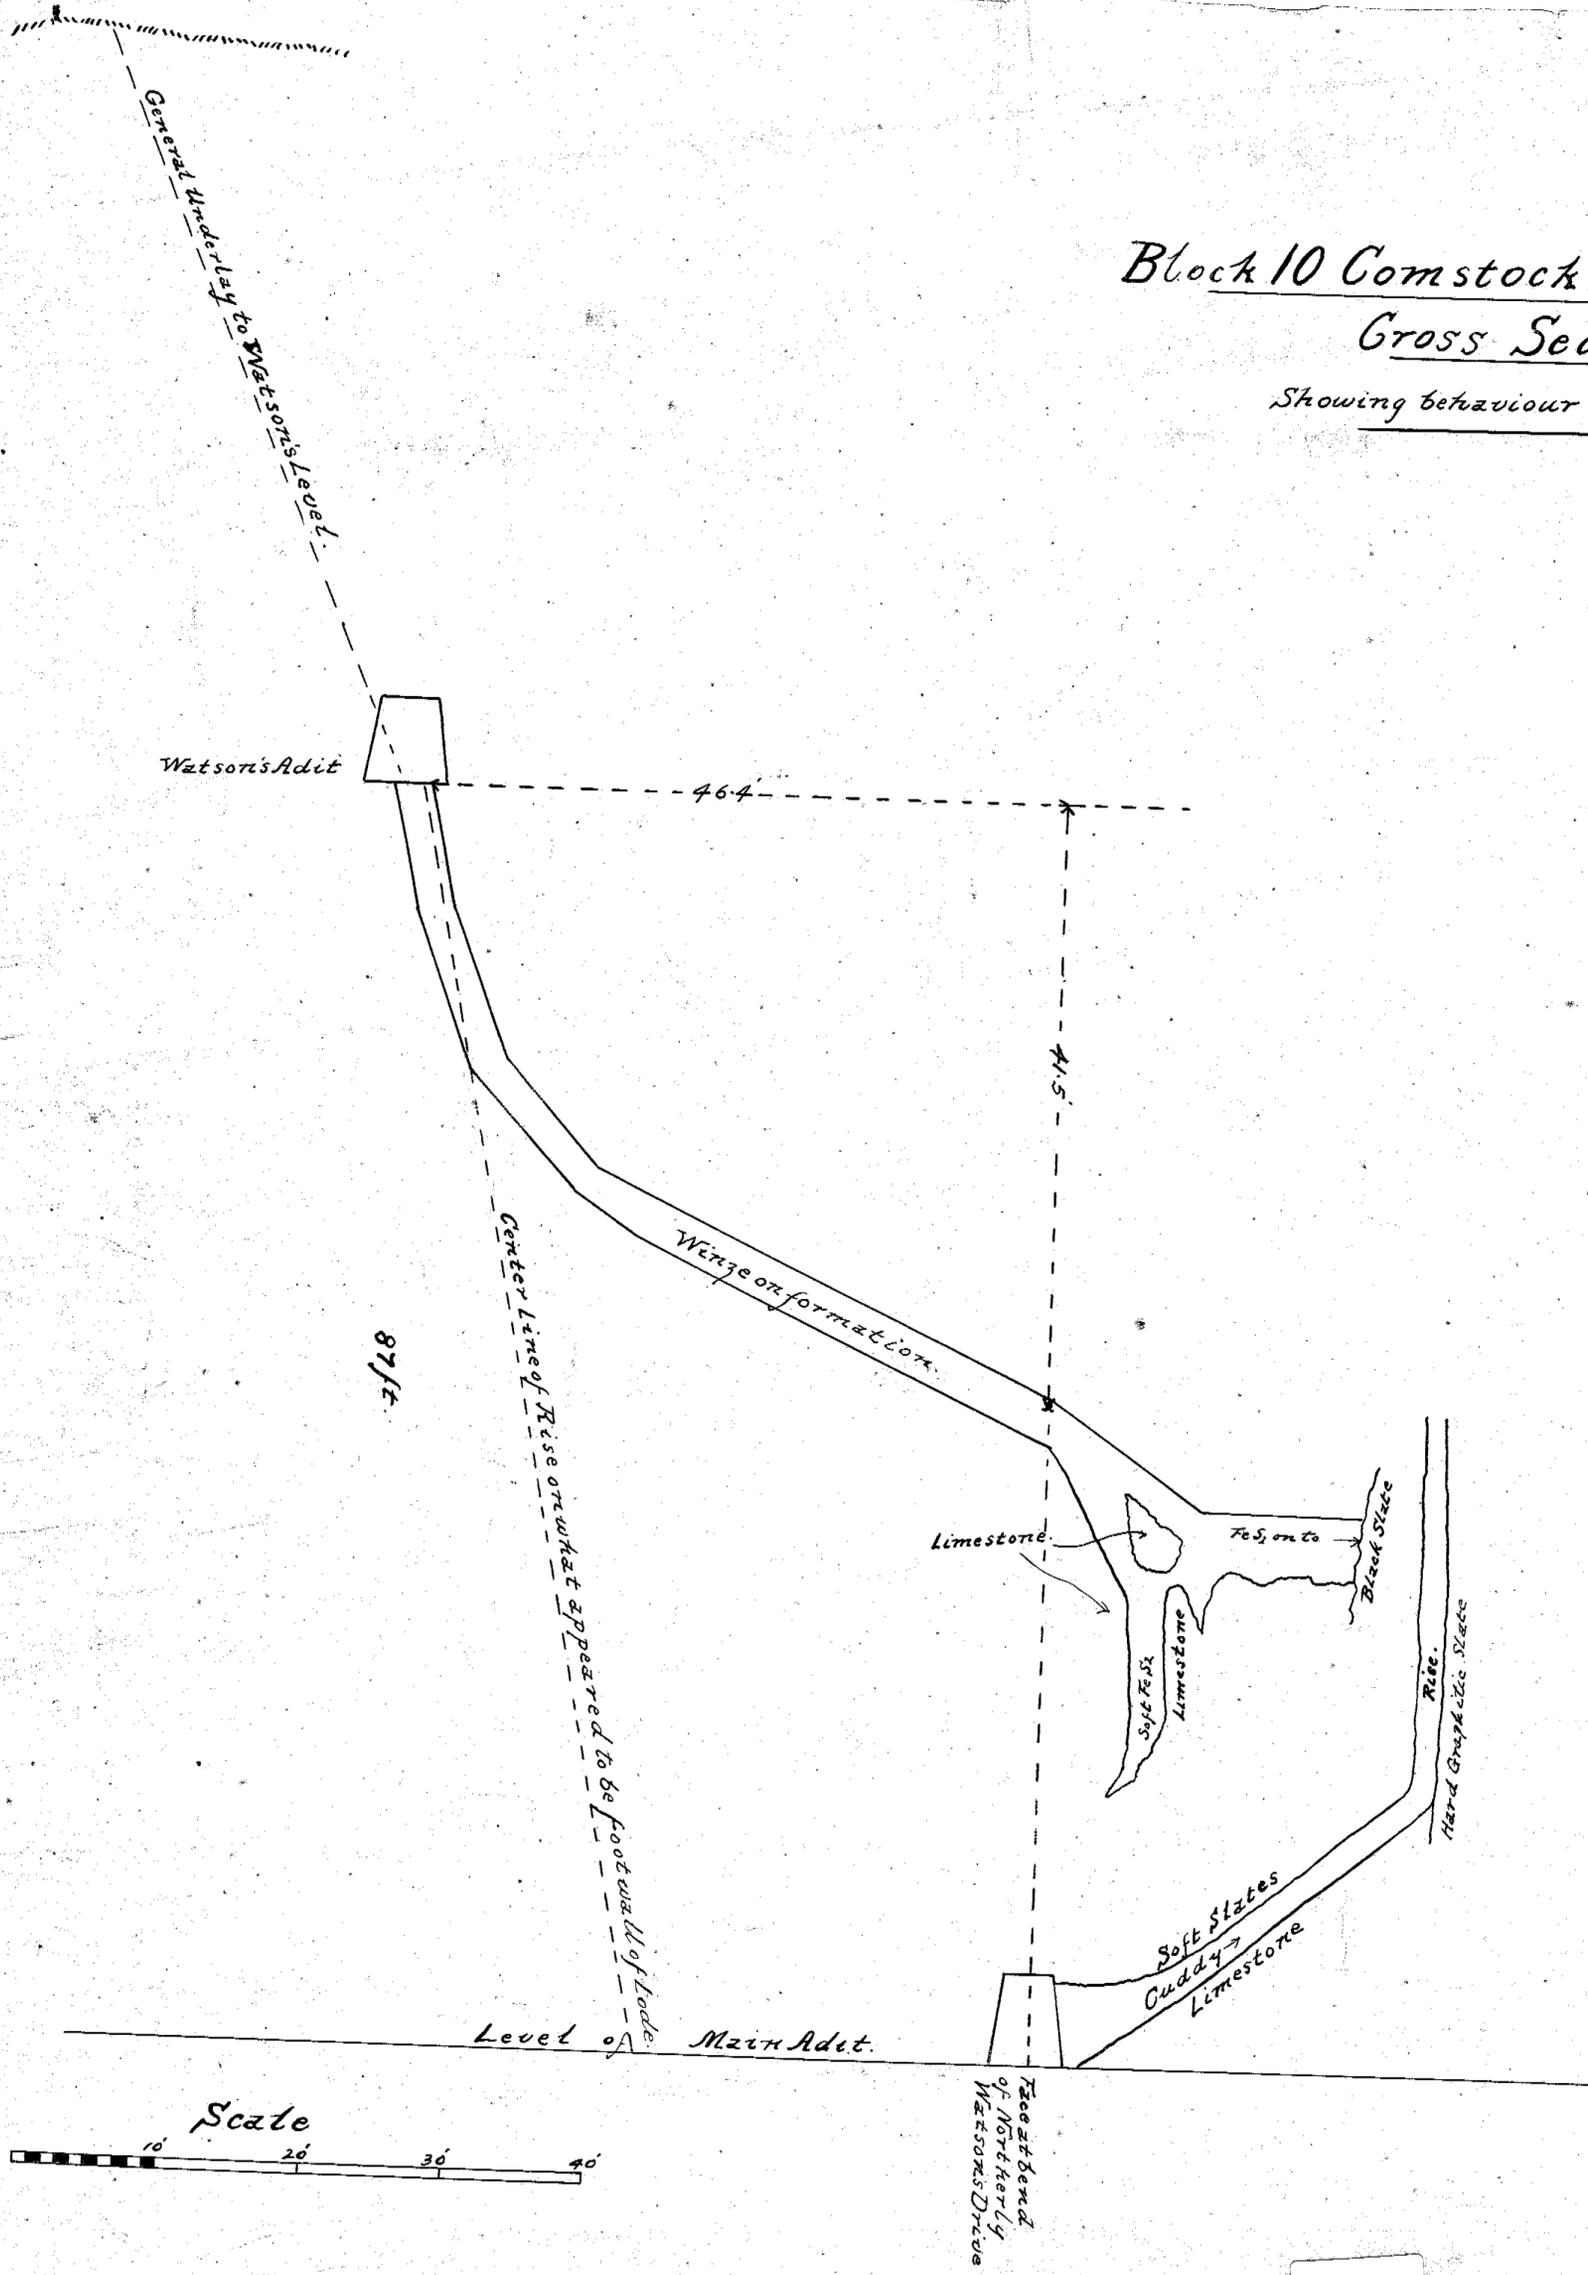

Scale

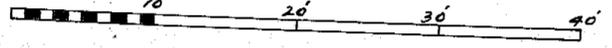

57-06

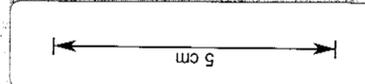

H. J. Fairbank
 6.12.10

57-06