

57-09

5 cm


57-09

# THE BLOCK IO MINE


## LONGITUDINAL SECTIONS

*des. W. I. Reid,  
June, 1913.*

— SCALE 20 FT TO 1 IN —

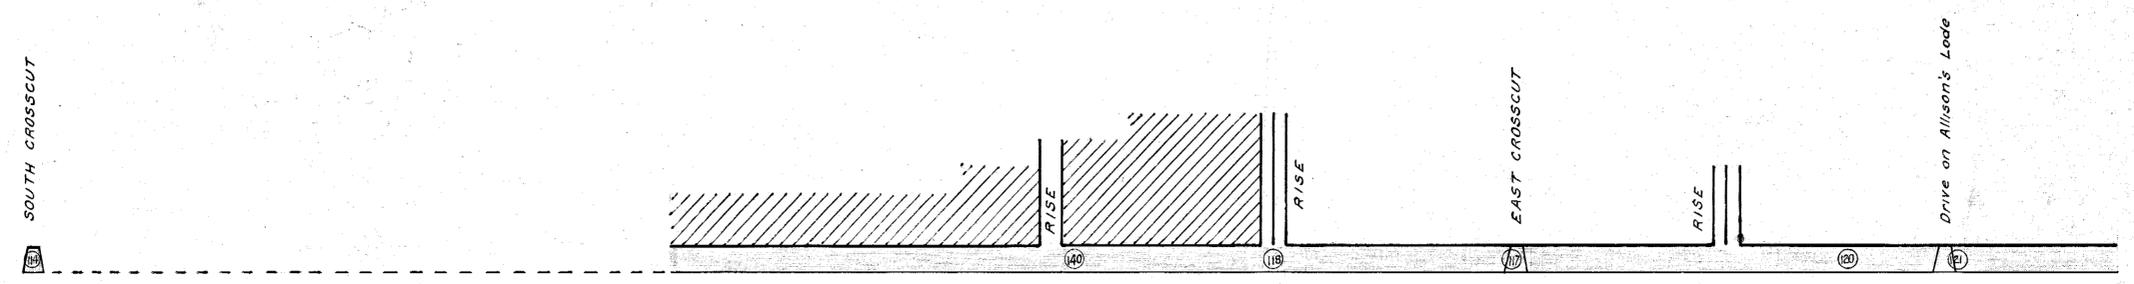

MATHIESON'S LODE

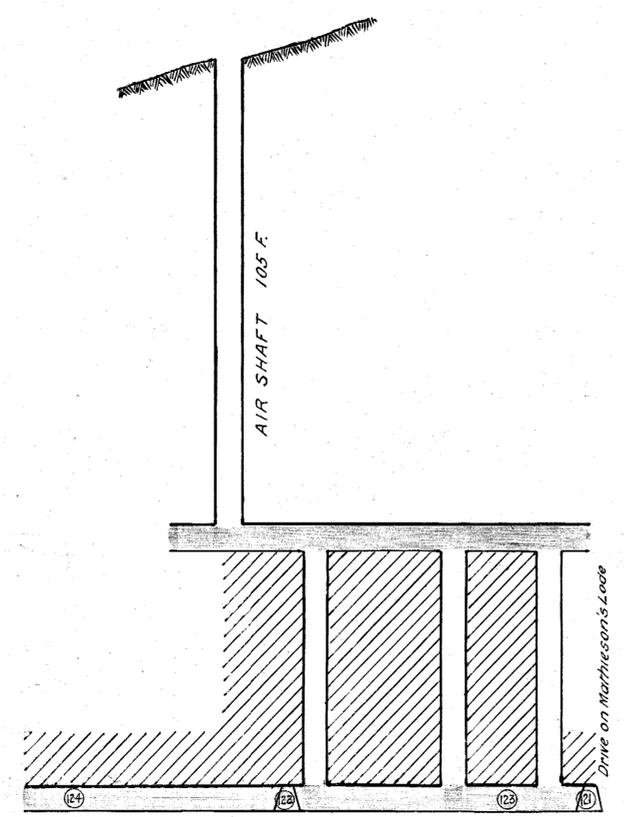

ALLISON'S LODE

East  
X-cut