

58-01




10-89

EP1

PLAN OF SANDFLY COAL MINE

Underground Workings - Scale - 20 feet - 1 inch

Surveyor

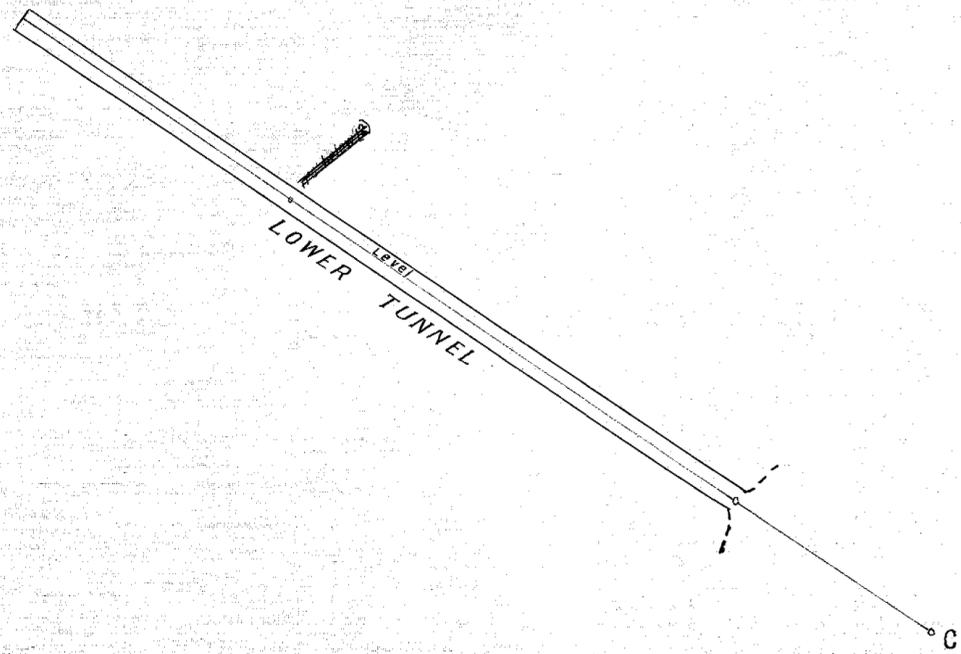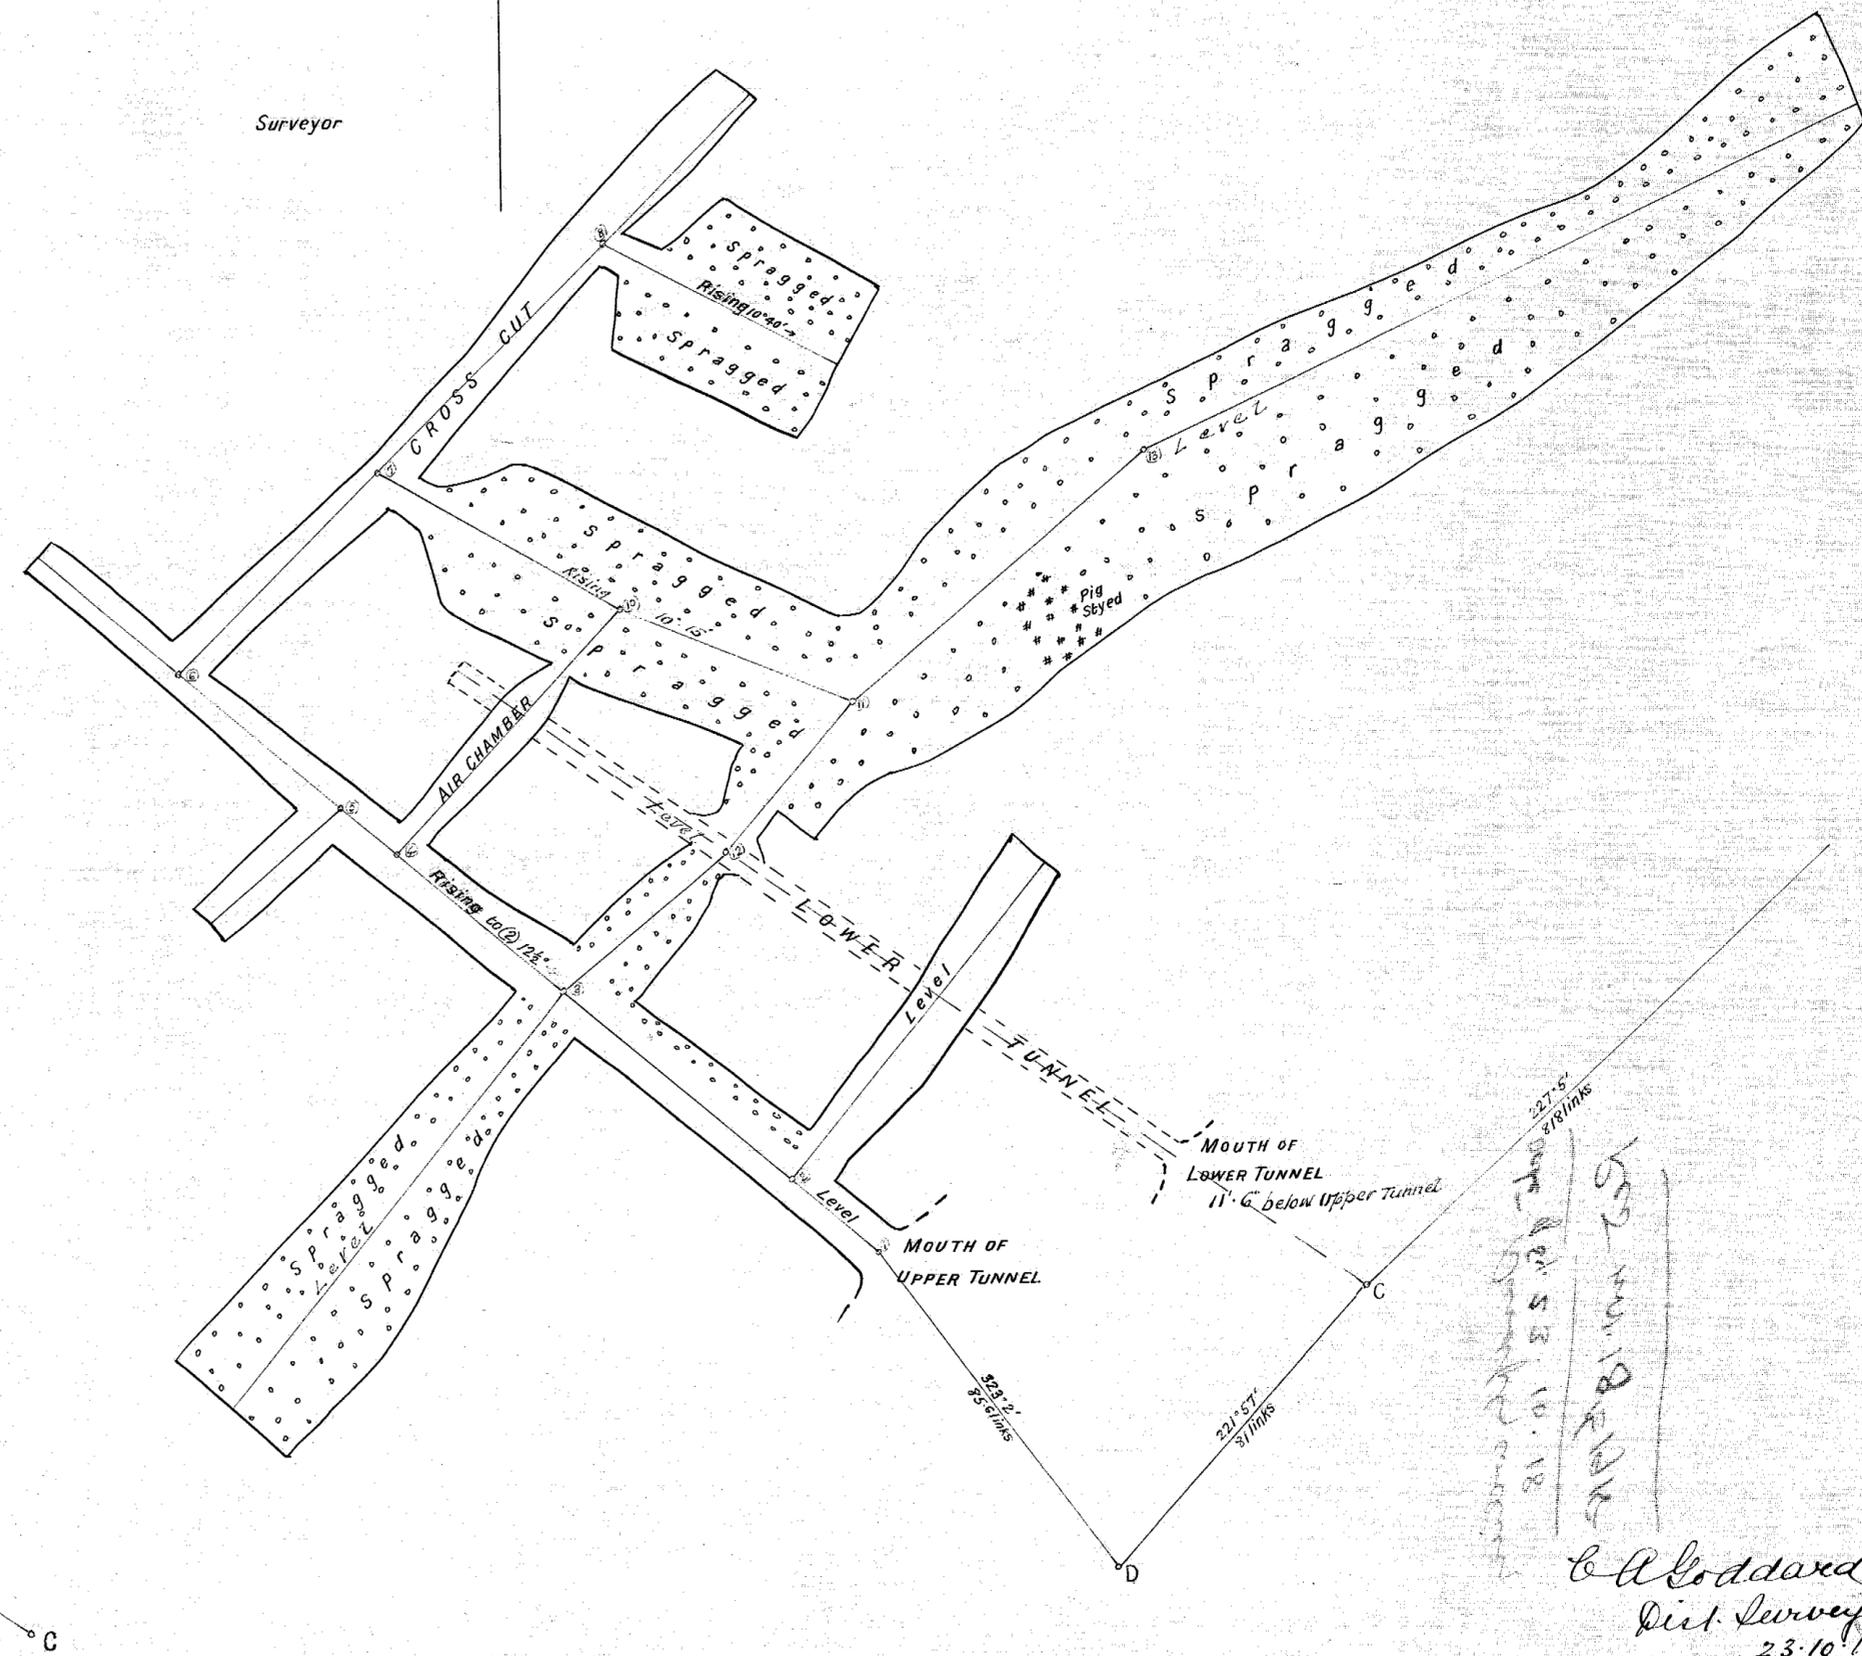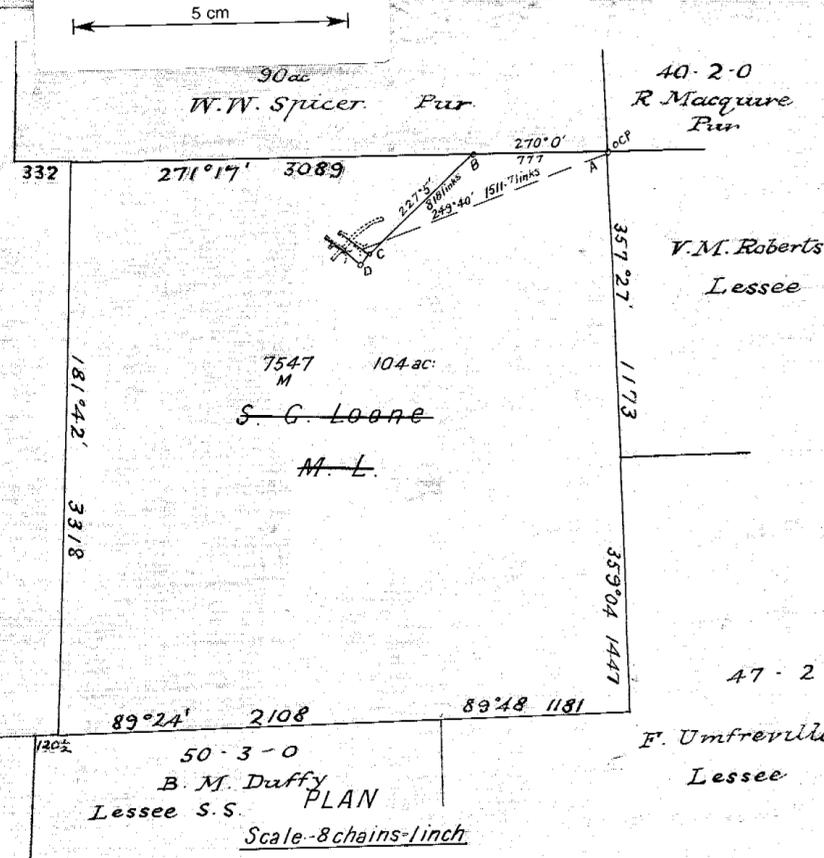

221°5' 28 Links

152 m 18 ft 10.18

C. A. Goddard
Dist. Surveyor
23-10-18