

Sandfly colliery

Section C-E (see plan)


Scale 66 feet = 1 inch (vertical and horizontal)

*W. Wallace*

58-04

58-04

5 cm

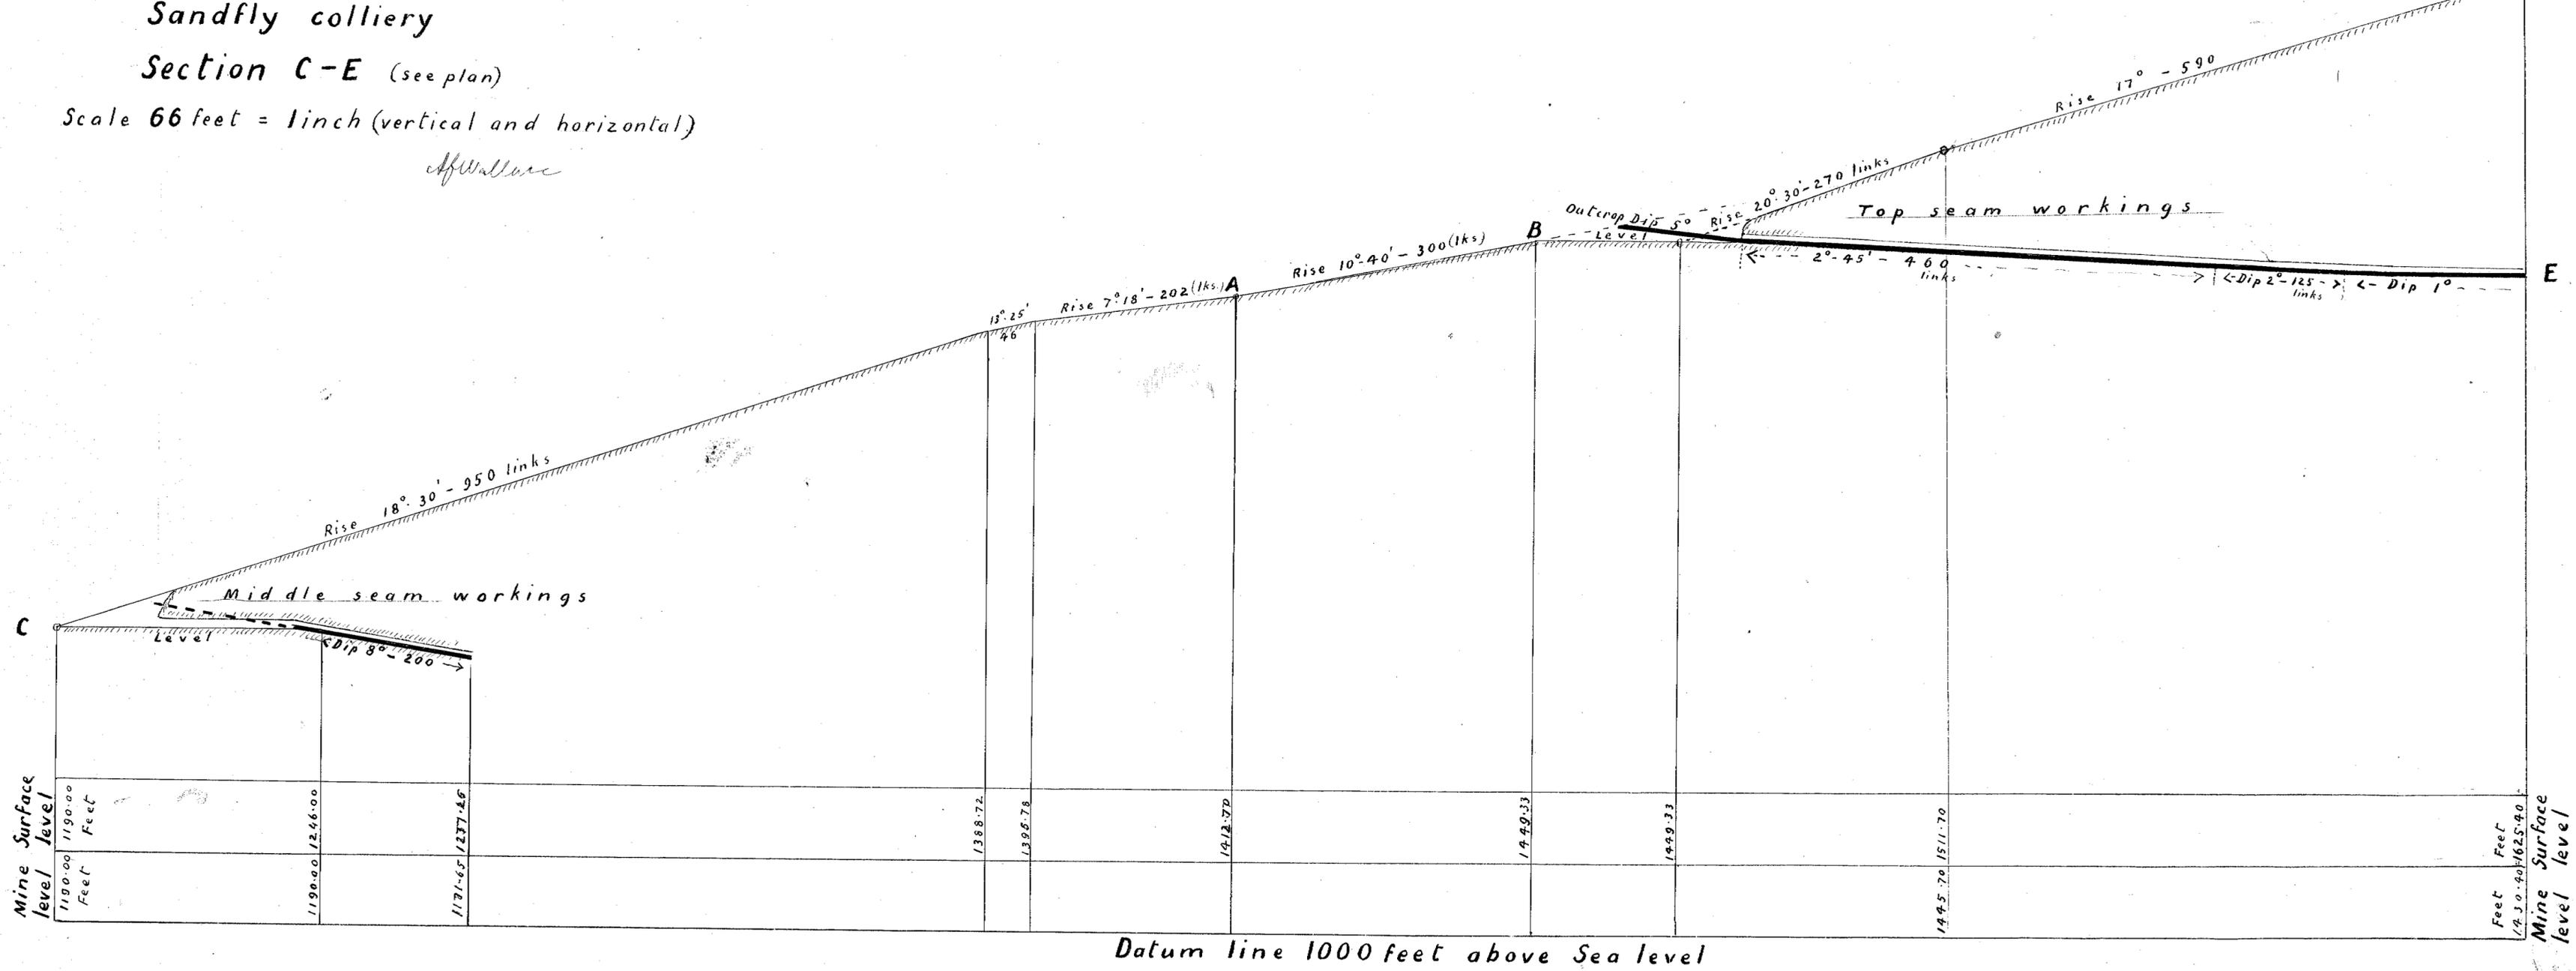

Mine Surface level

