

PLAN



OF THE

WALLSEND COLLIERY

SCALE:— ONE CHAIN TO AN INCH

Faults:—  $\frac{1}{2}$ "
 Pillars Extracted:— 

Note:— Tracing from Plan supplied by
 T. A. Tabart, Hobart 10.9.17

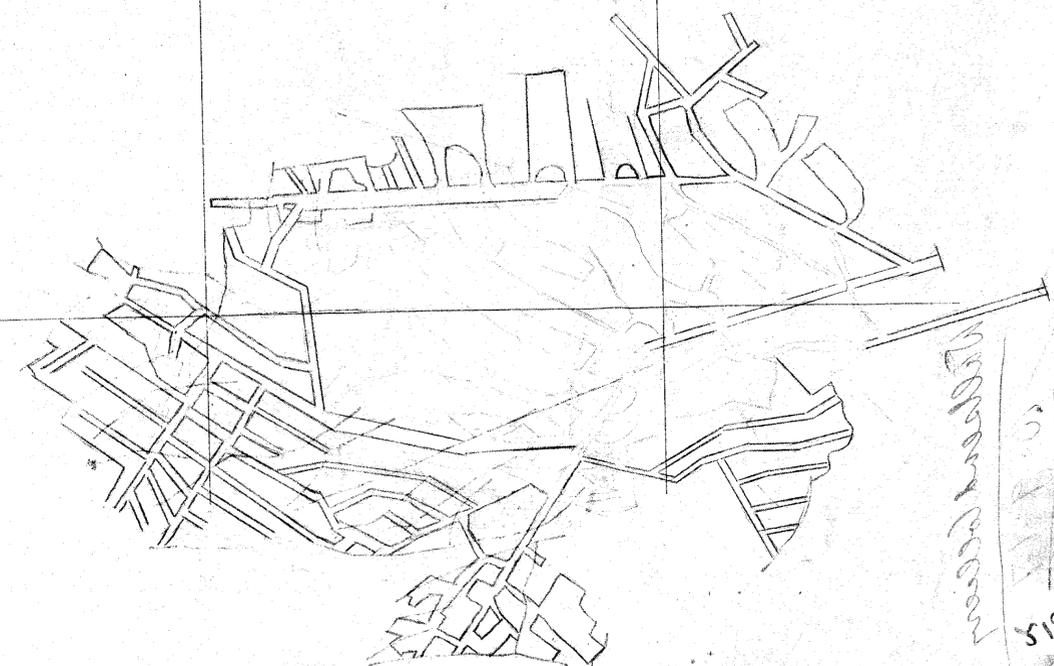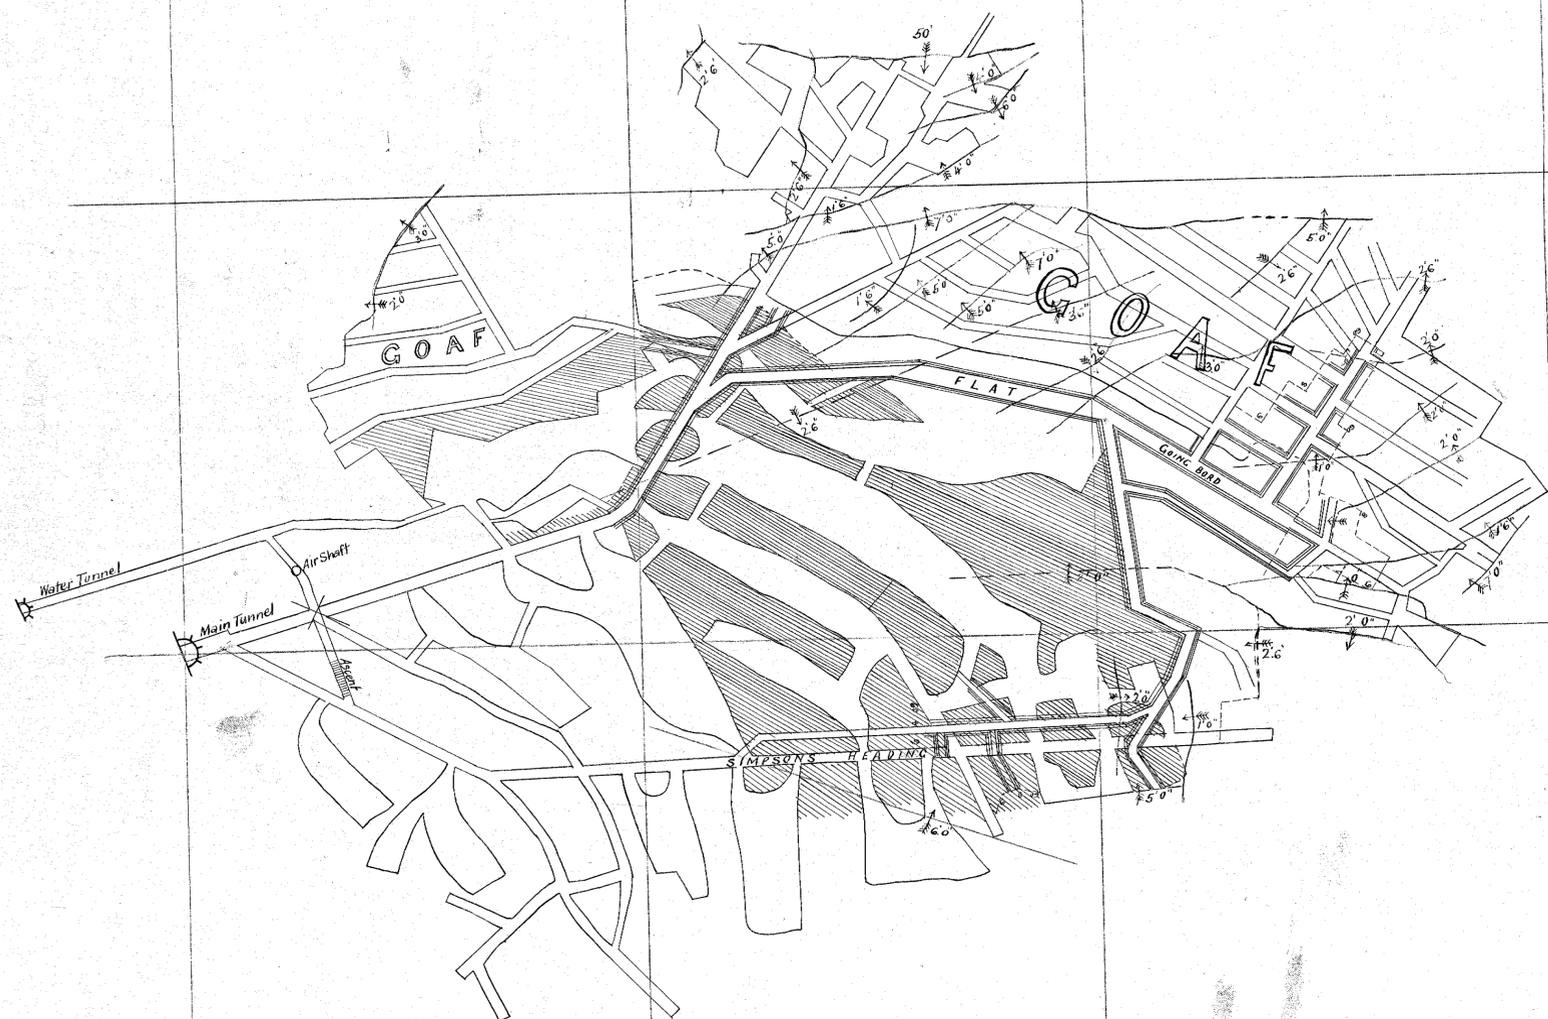

RECEIVED 6th AUGUST 1901
 R.M.S.

5 m

58-10

58-10

815