


395 P
M

88 ac.

O. L. & O. T. ROBERTS

M. L.

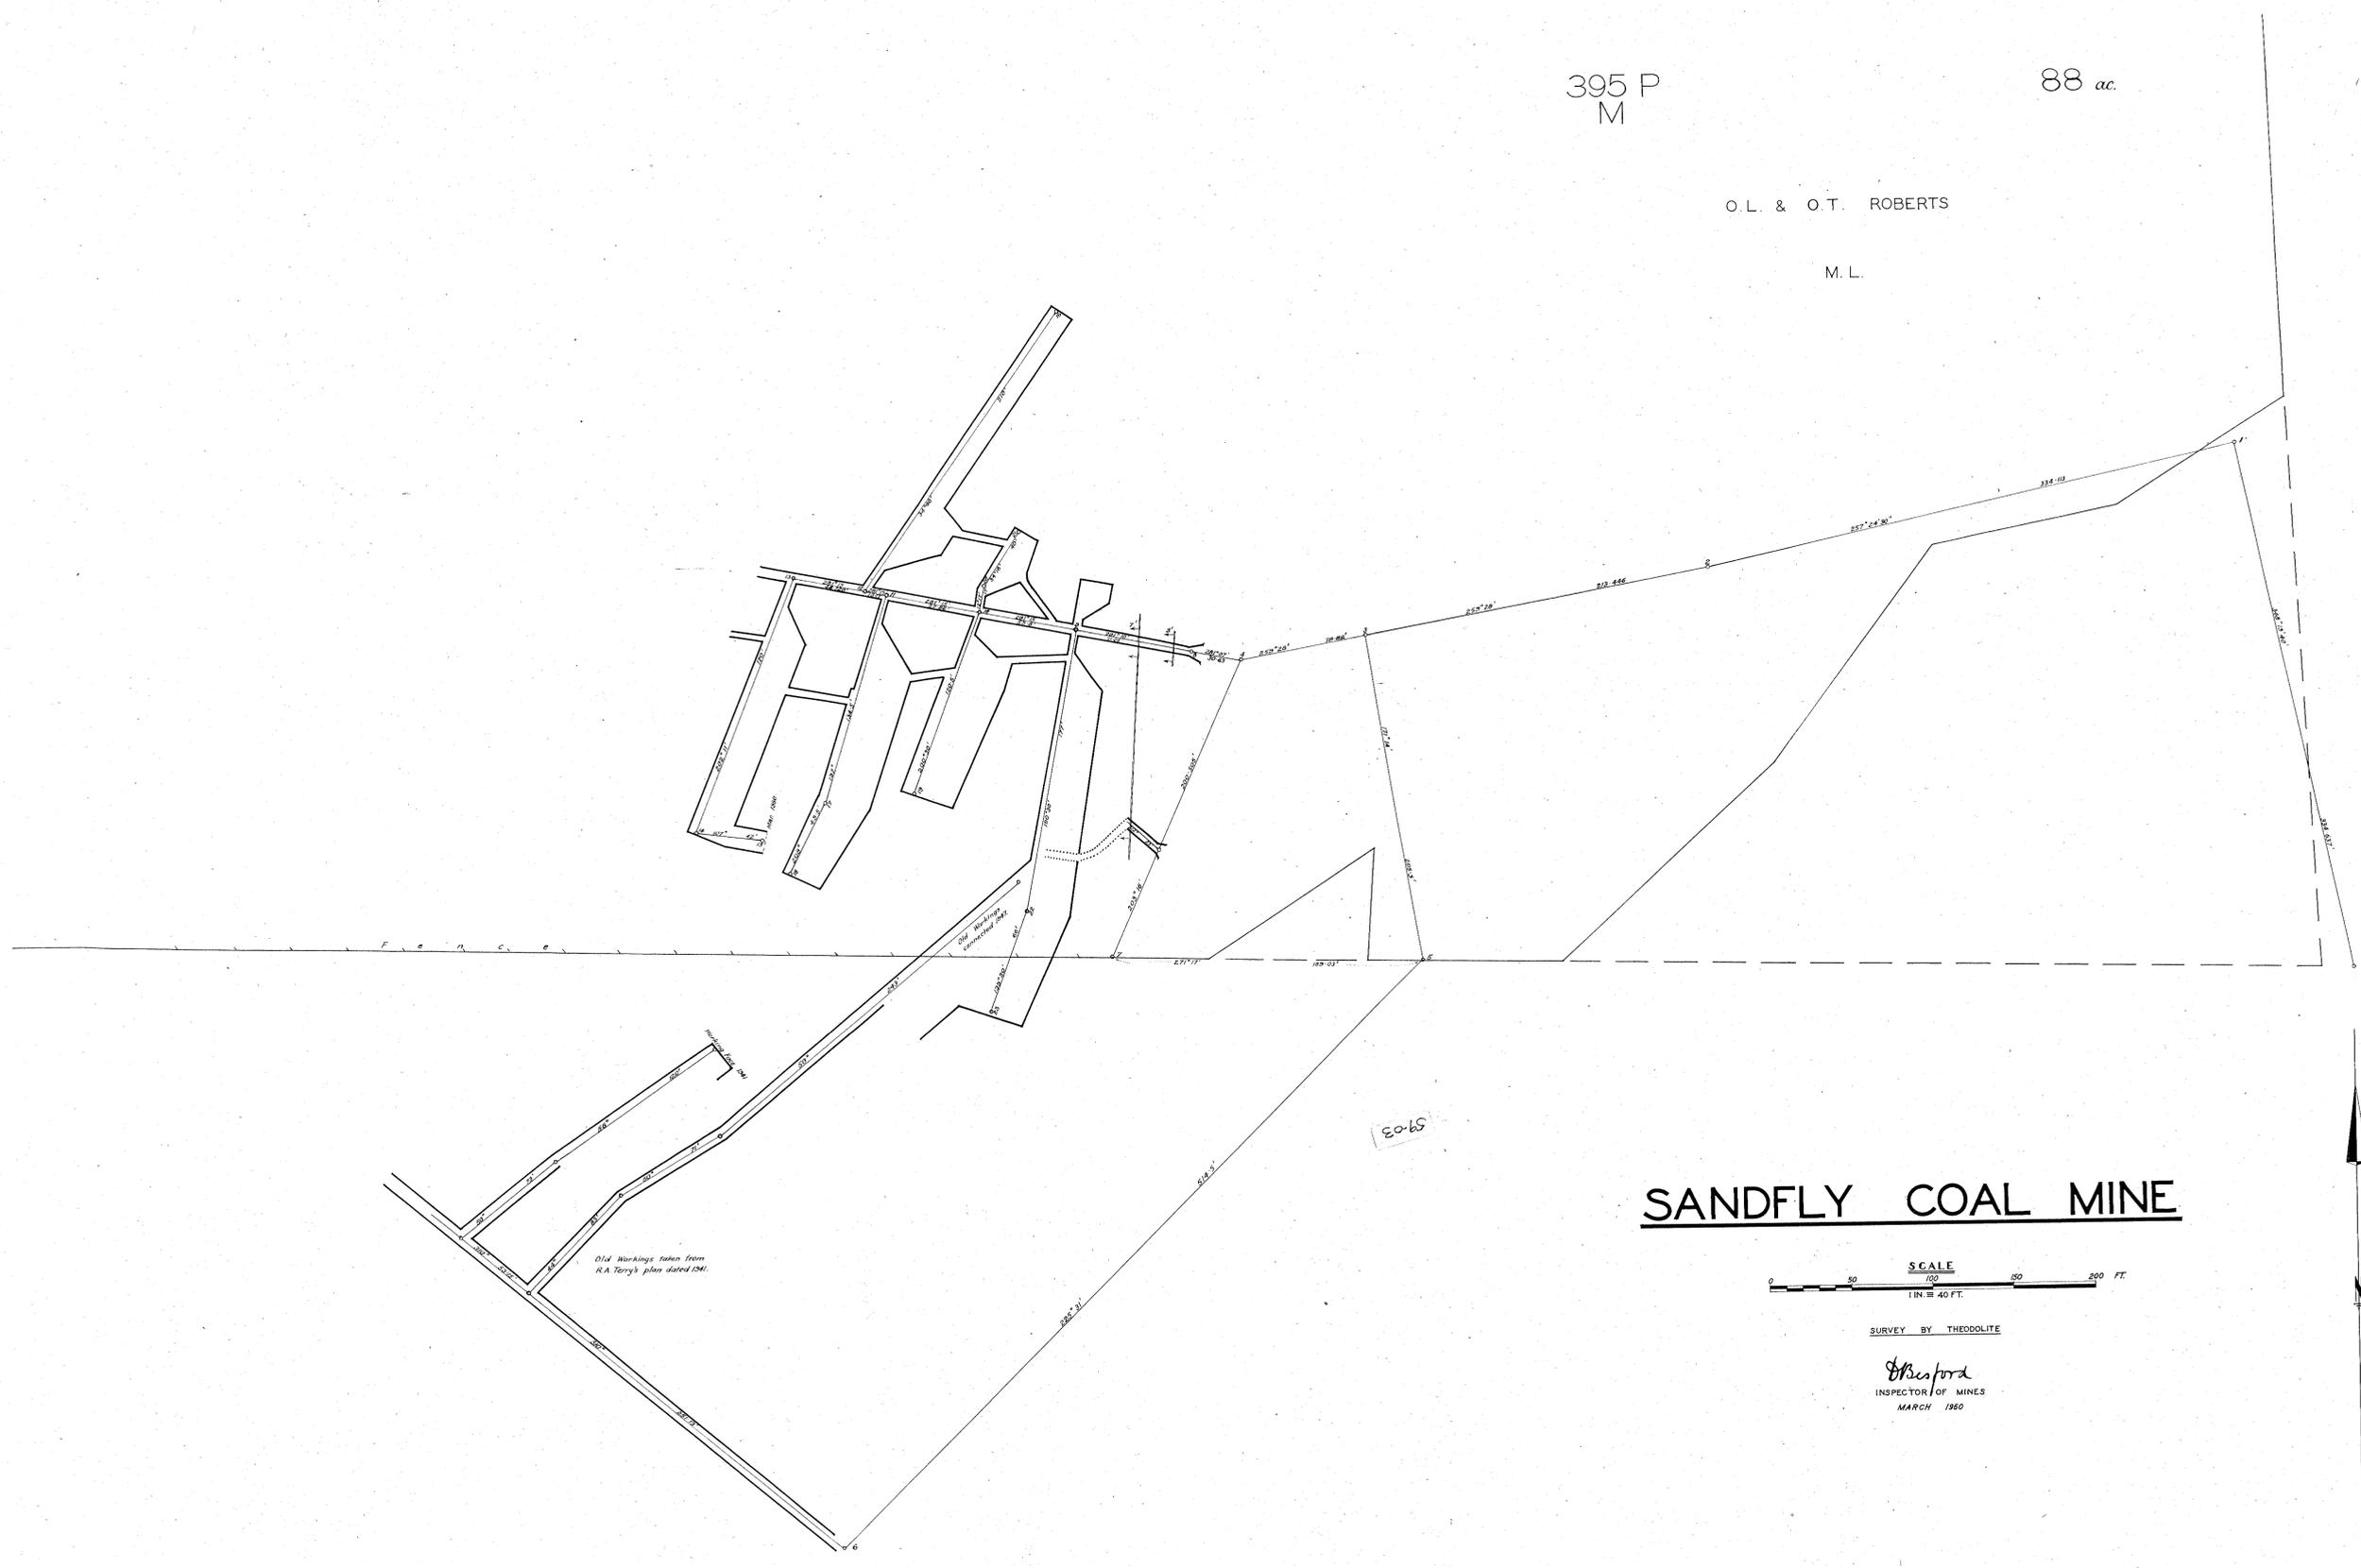

80-65

Old Workings taken from
R.A. Terry's plan dated 1941.

SANDFLY COAL MINE



SURVEY BY THEODOLITE

Blusford
INSPECTOR OF MINES
MARCH 1950