


59-02

N^o 8 Farrell Mine Workings
W J Doran Surveyor
Survey made with 5" theodolite
March 1921
New York
Geo. W. Brown

Extension of N^o 8 LEVEL

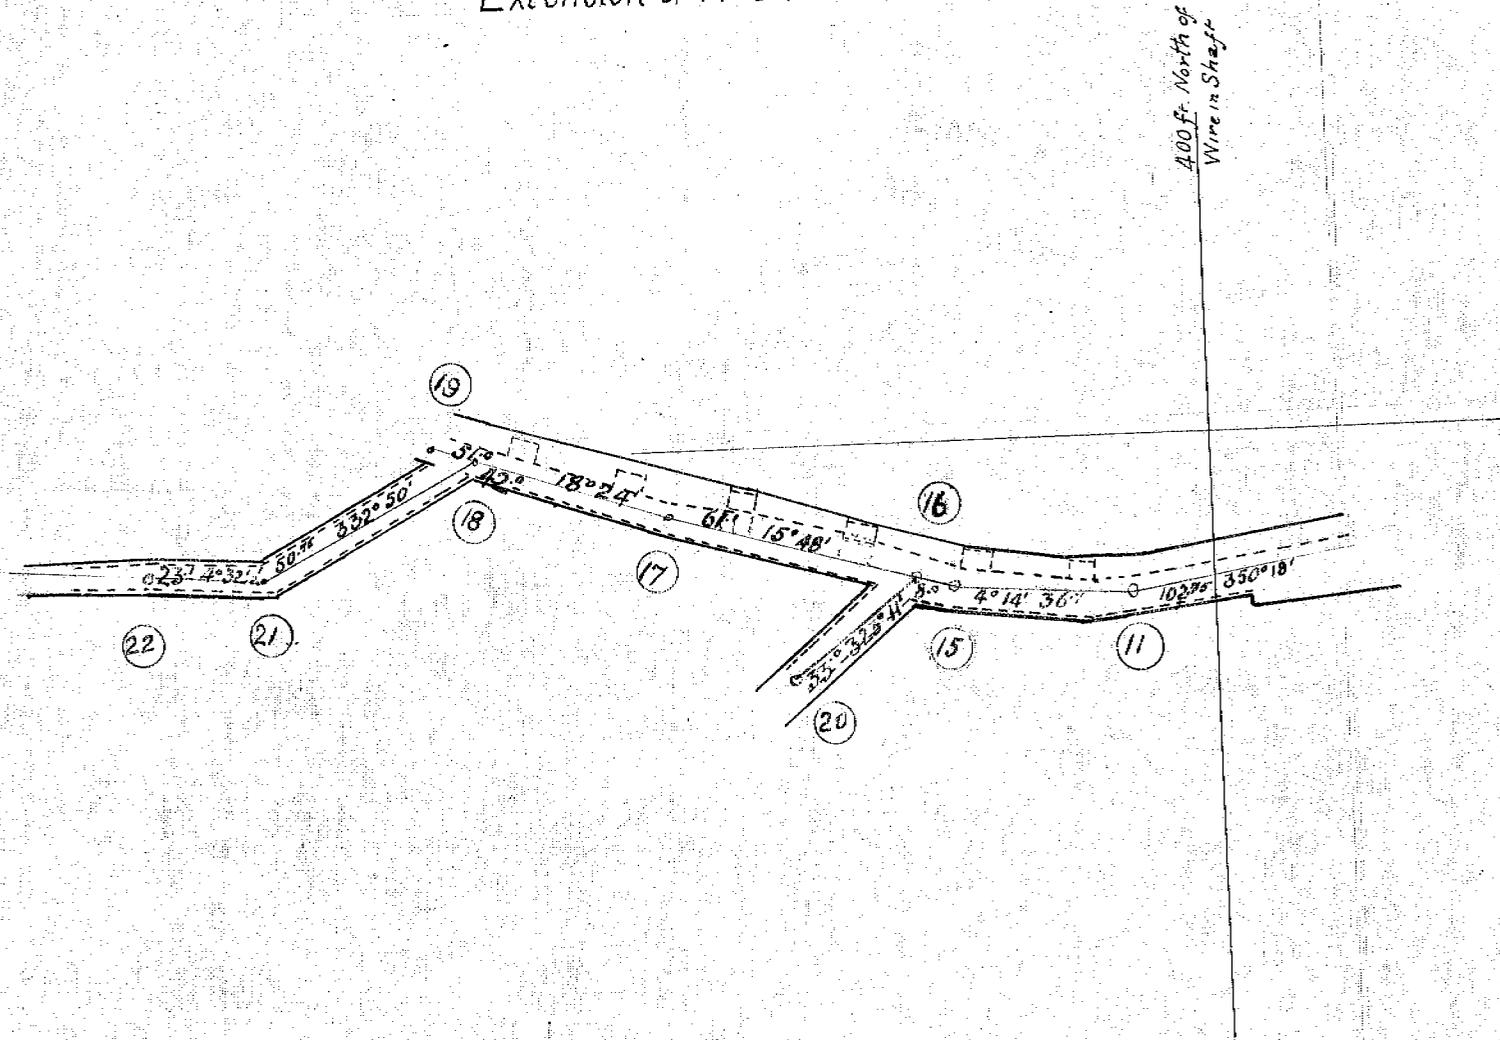

1-01

LONGITUDINAL SECTION