

400 ft. North of
Wire in Shaft

Extension of N° 8 LEVEL


Mr. McFarrell, Mine Workings
W. J. Doran, Surveyor
March, 1921
Survey made with 5" theodolite
W. J. Doran, Surveyor

59-02

LONGITUDINAL SECTION

N° 2 LODE

N° 2 McFarrell Mine Workings
W. J. Doran, Surveyor
March, 1921
W. J. Doran, Surveyor
General Manager

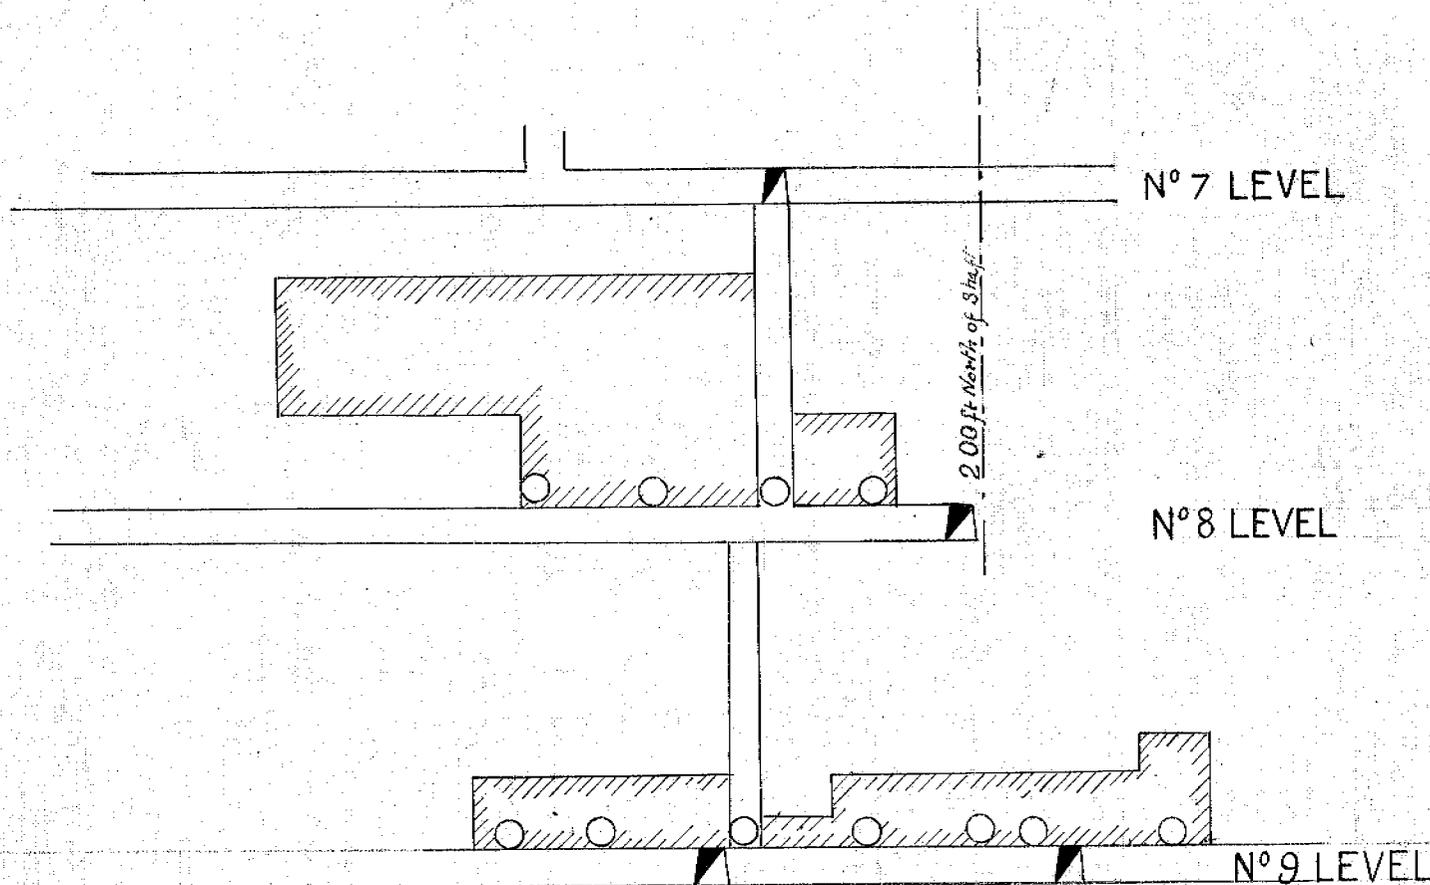

59-02

59-03