
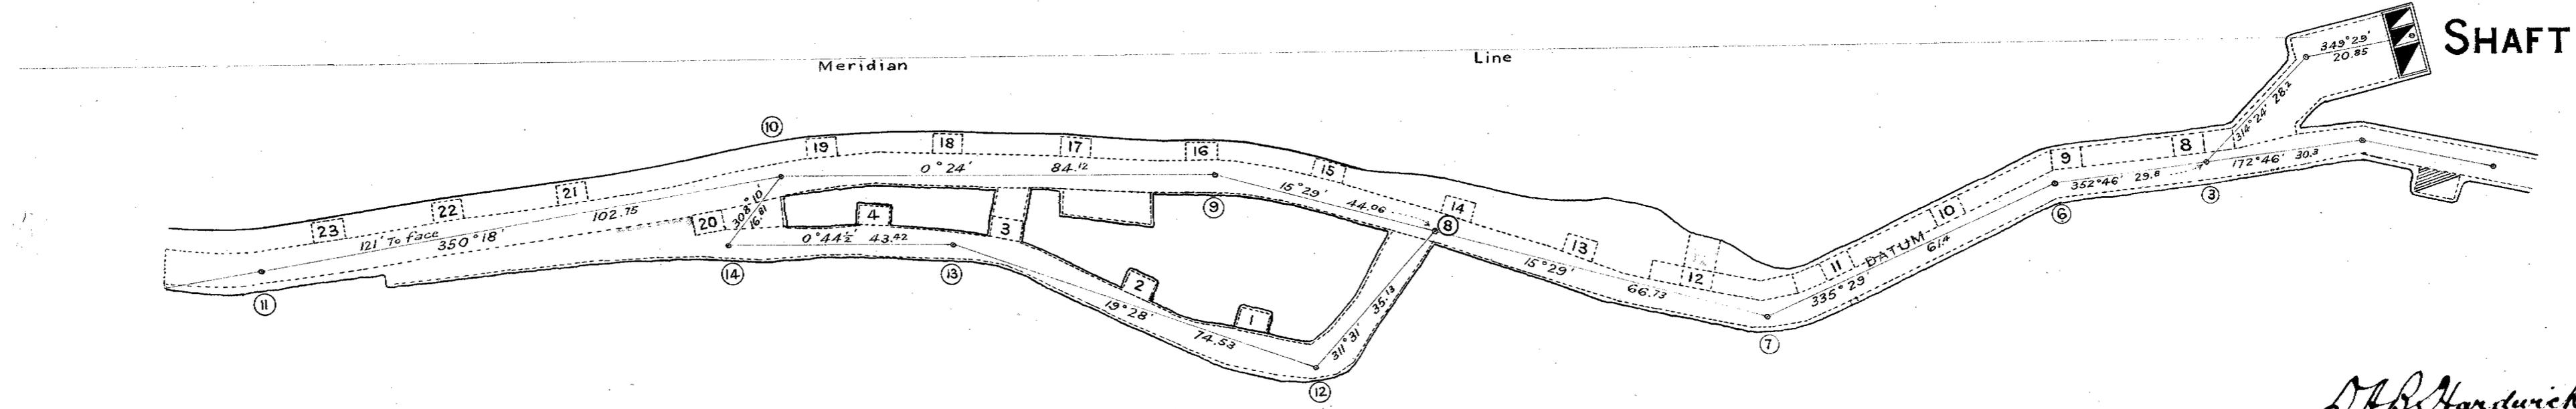


59-04

# NORTH MOUNT FARRELL COY N.L.

## — Plan of No 8 Level —

Scale 25 Feet to an inch

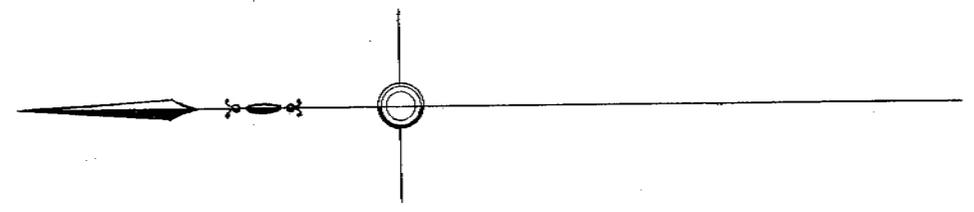

59-04

5 cm

*D. B. Hardwick*  
 Mining Surveyor  
 12<sup>th</sup> May 19

NOTE. All angles observed by 4" Transit Theodolite