



59-05

Extension of N° 6 LEVEL

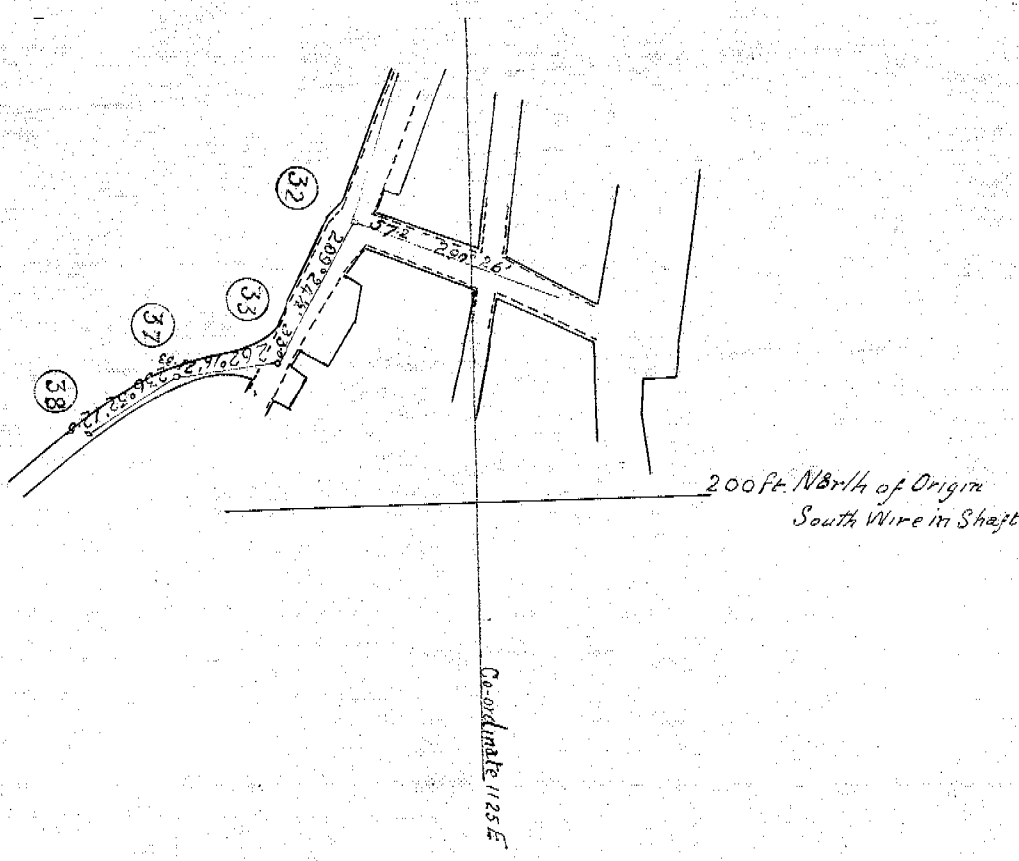

Extension of N° 7 LEVEL

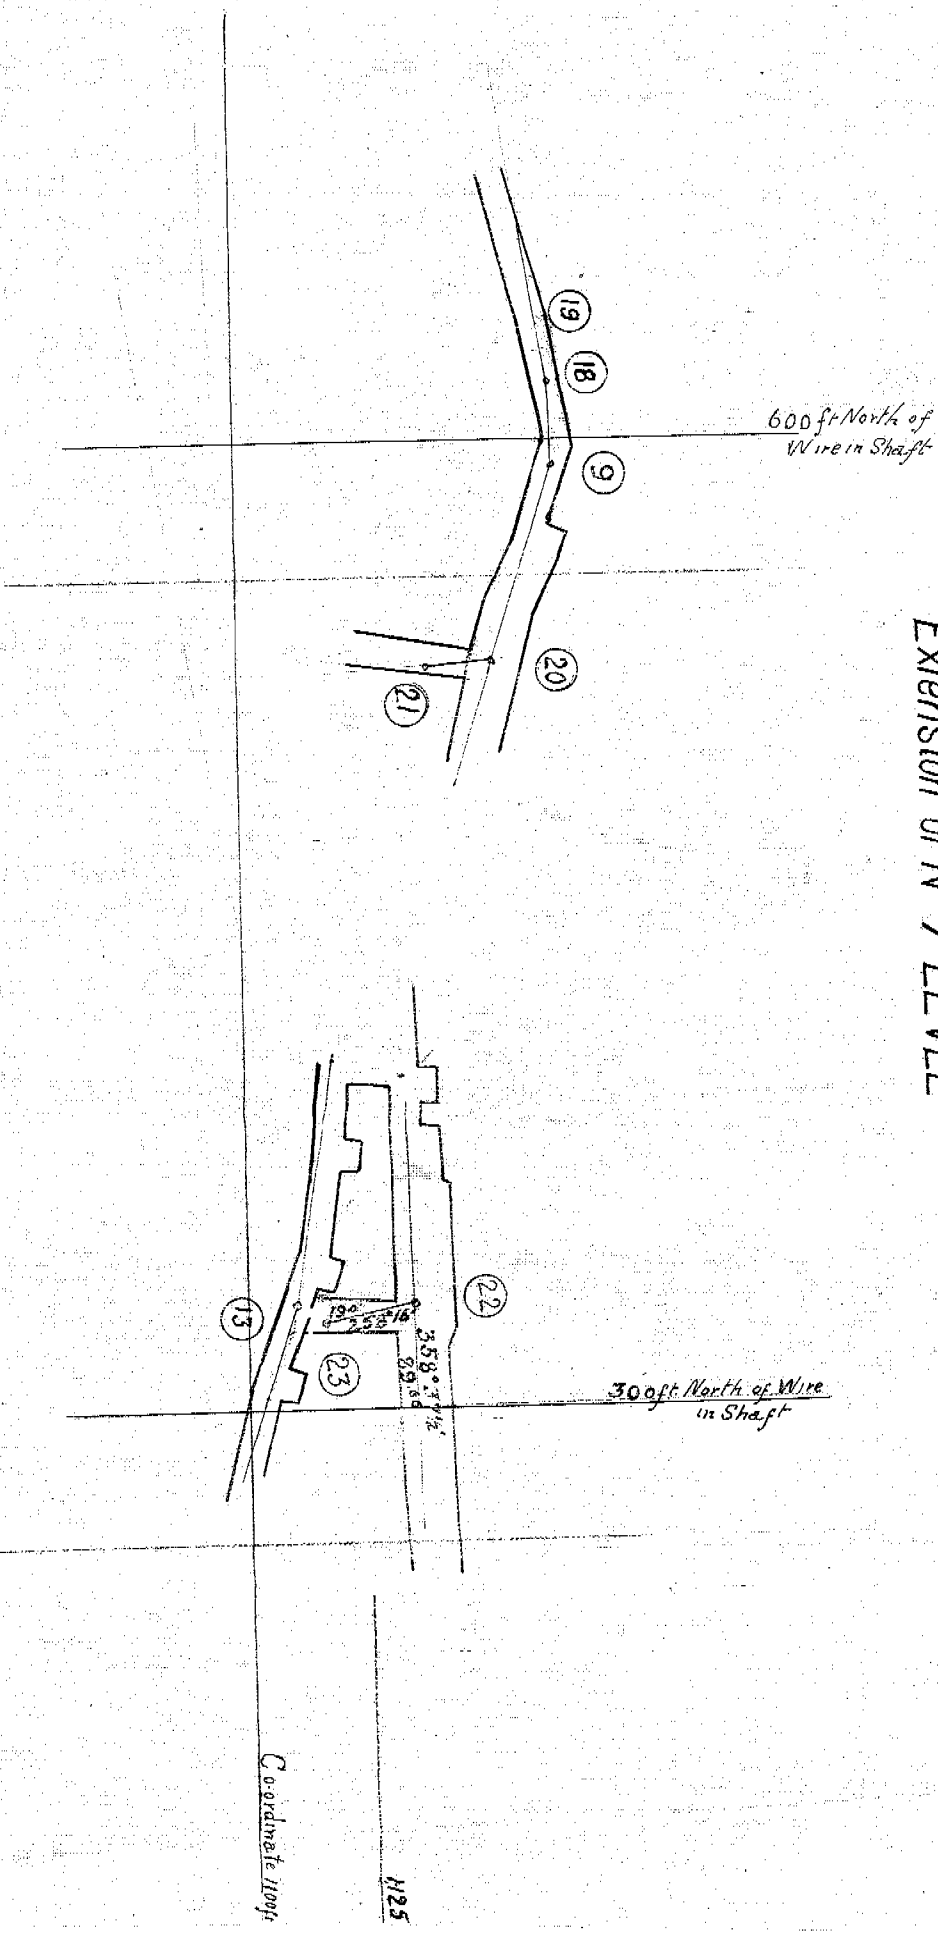

Mr. McDaniel, Mine Working
 in Donnan Surveyor
 Survey made with 5" theodolite
 Dec 1921
 E. A. Surveyor

5 cm