


59-06

59-06

Nth M^t Farrell Mine Workings
W J Doran Surveyor
Survey made with 5" theodolite
March 1921
Wm. H. Williams
Gen. Manager.

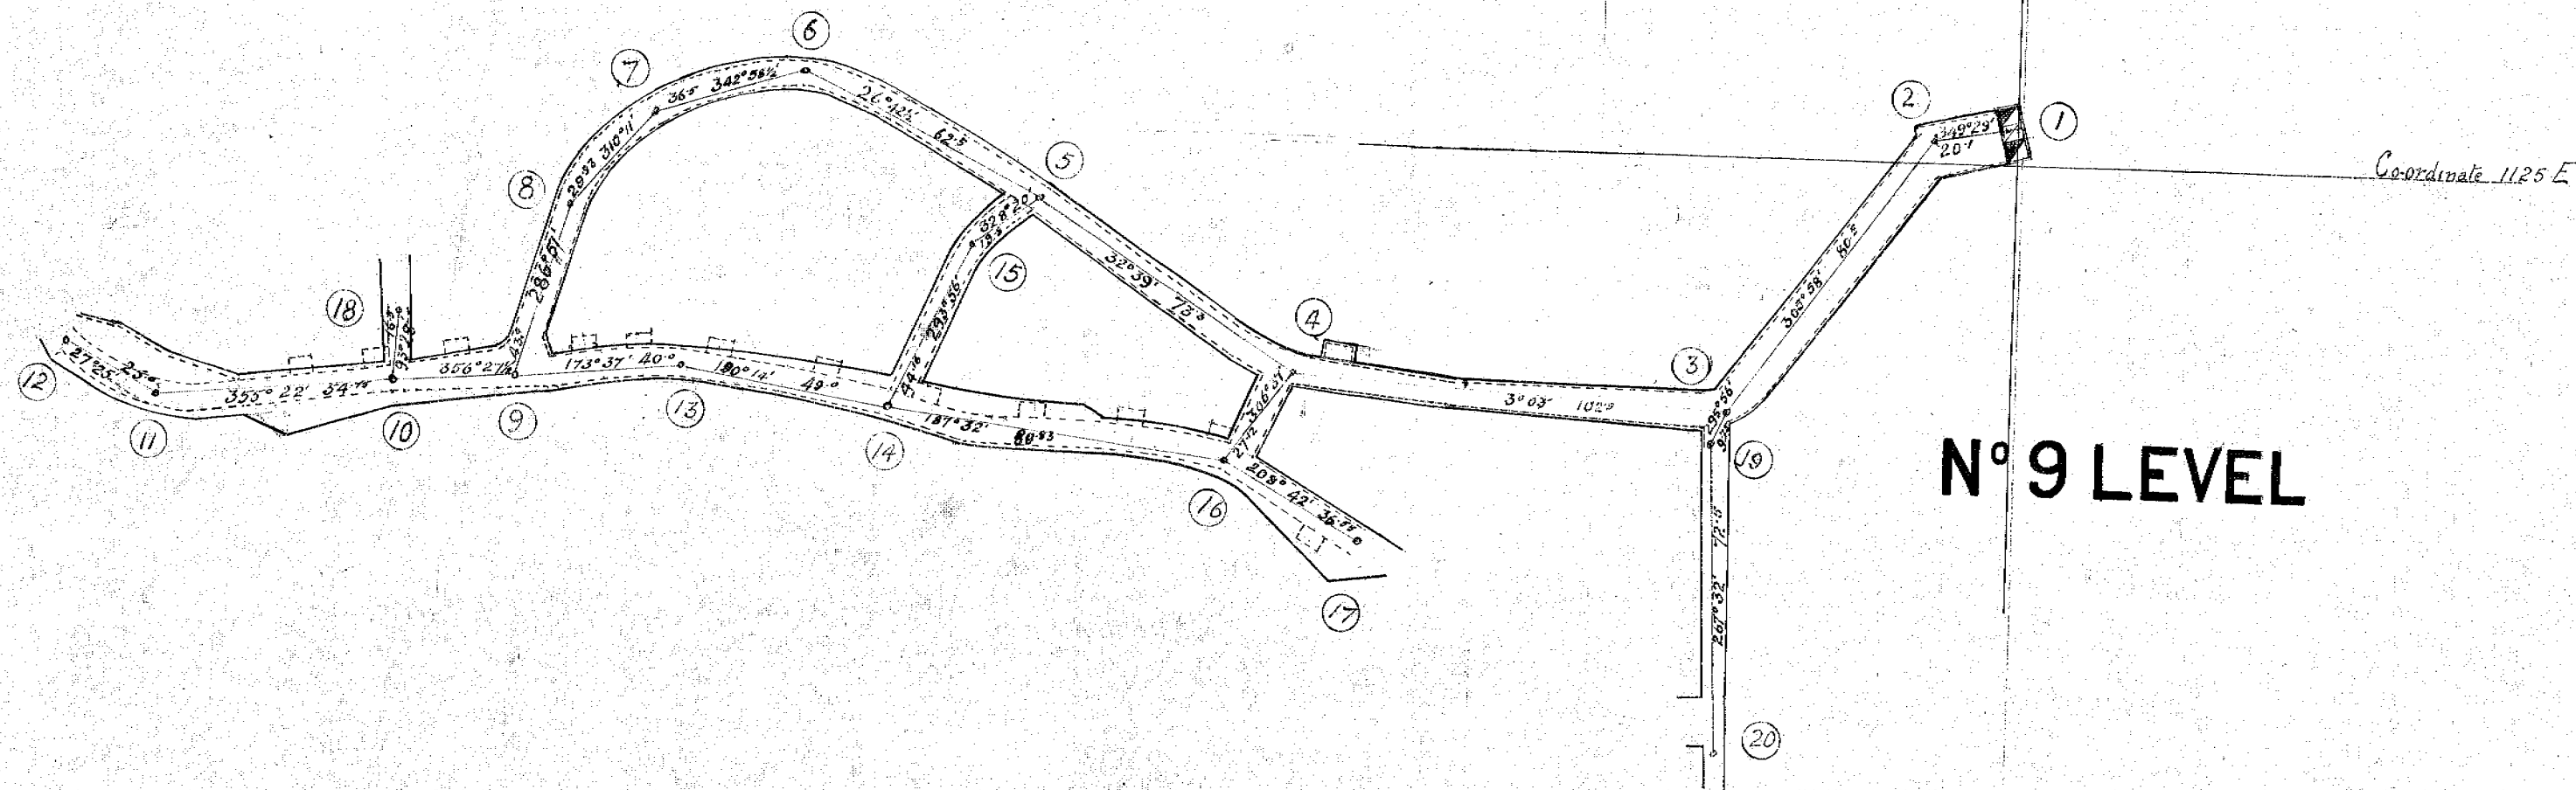

Nth M^t Farrell Mine Workings
W J Doran Surveyor

50