
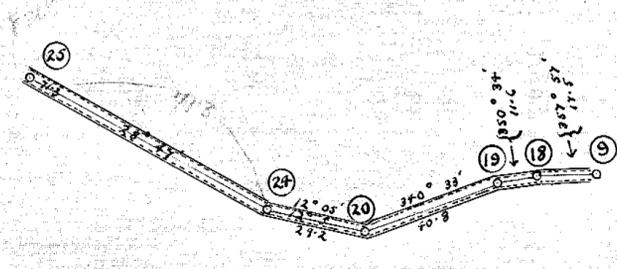
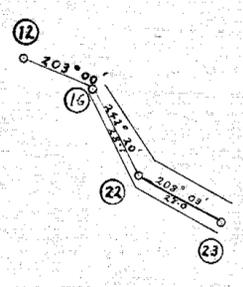



5 cm

NORTH MT. FARRELL MINE WORKINGS


SCALE 40 FEET TO AN INCH

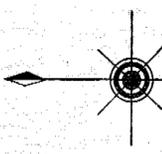


N^o 7 LEVEL

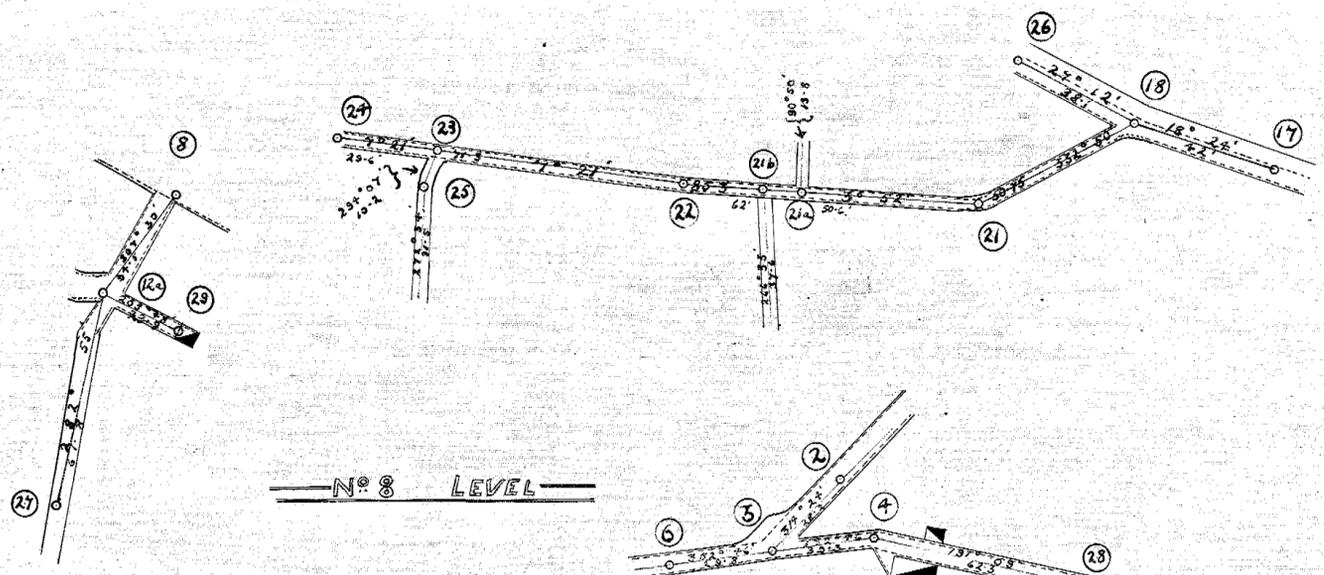

N^o 8 LEVEL

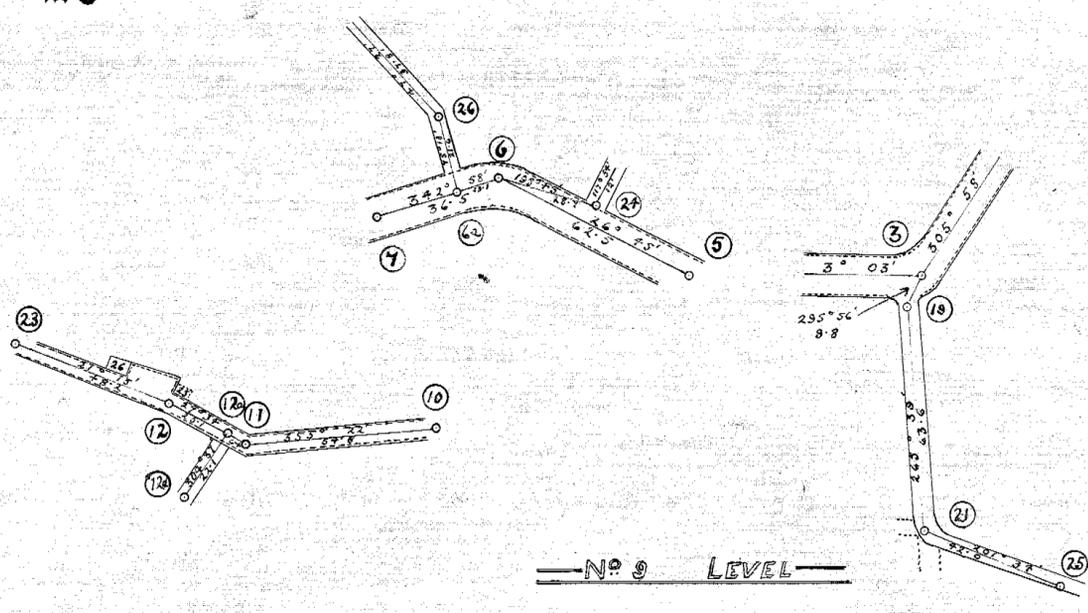

N^o 9 LEVEL

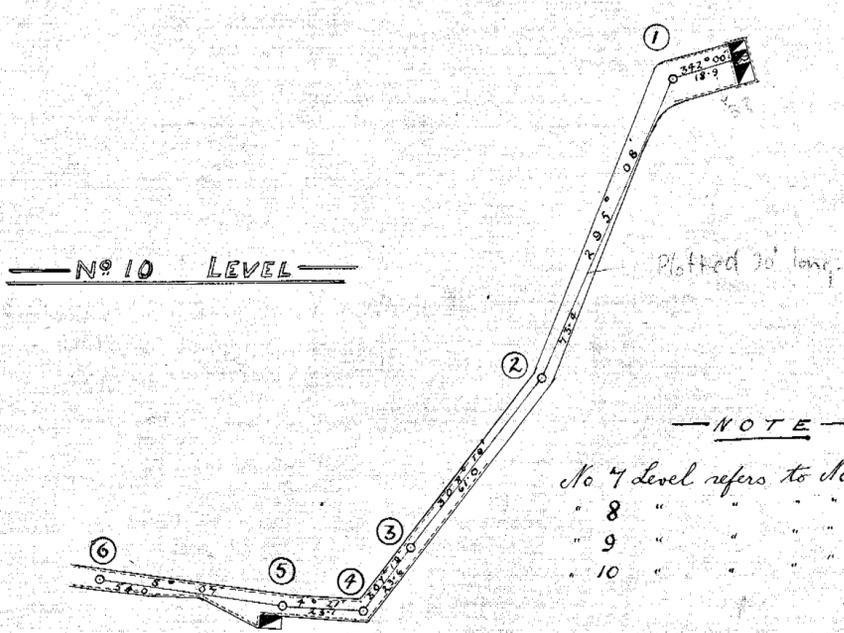

N^o 10 LEVEL

NOTE

No 7 level	refers to	No 3 shaft level
" 8 "	"	" 4 "
" 9 "	"	" 5 "
" 10 "	"	" 6 "

Exd.
7-4-22

Robertson
Mining Engineer