
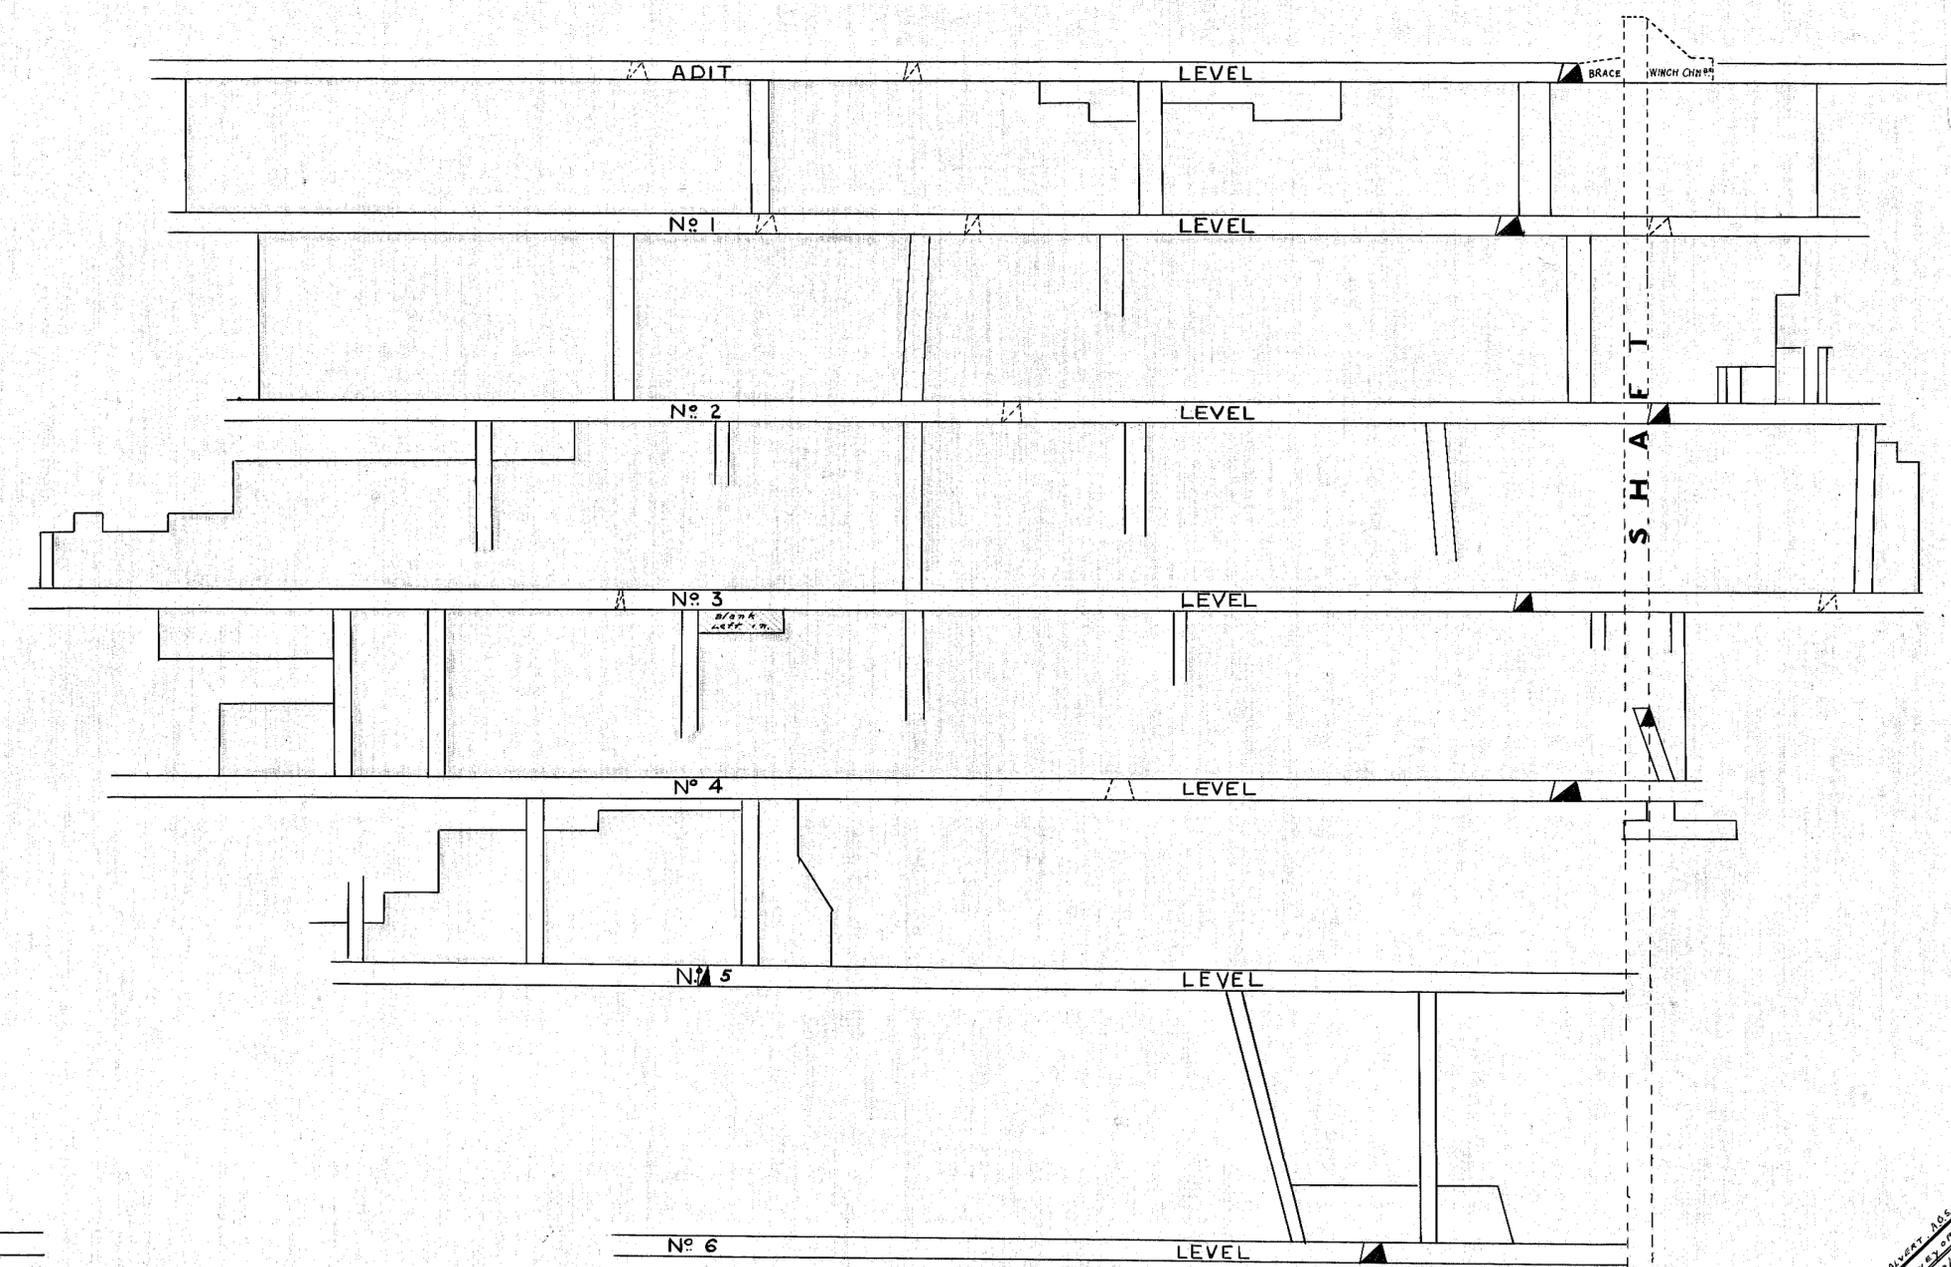


LONGITUDINAL SECTION OF SHAFT LEVELS

— SCALE 40 FEET TO AN INCH —

SECTION N°2 LODE

SECTION N°3 LODE

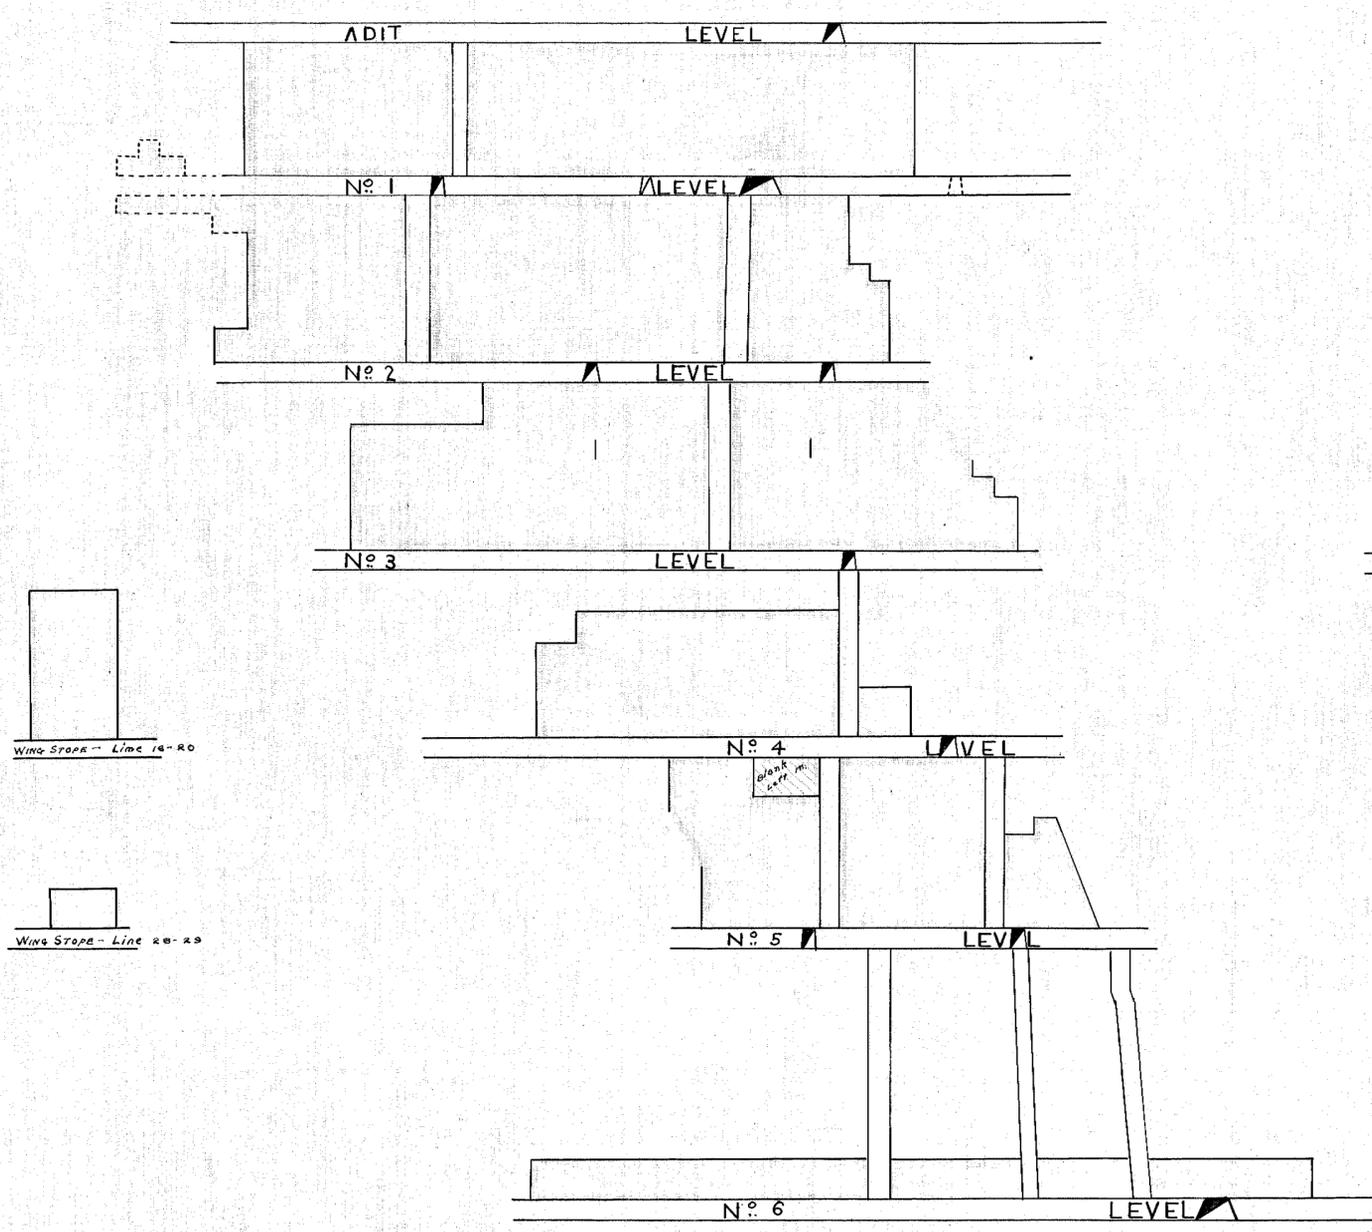

500

RECEIVED
SUNNYVALE
MAY 1923

59-08

5708