


5 cm

59-09

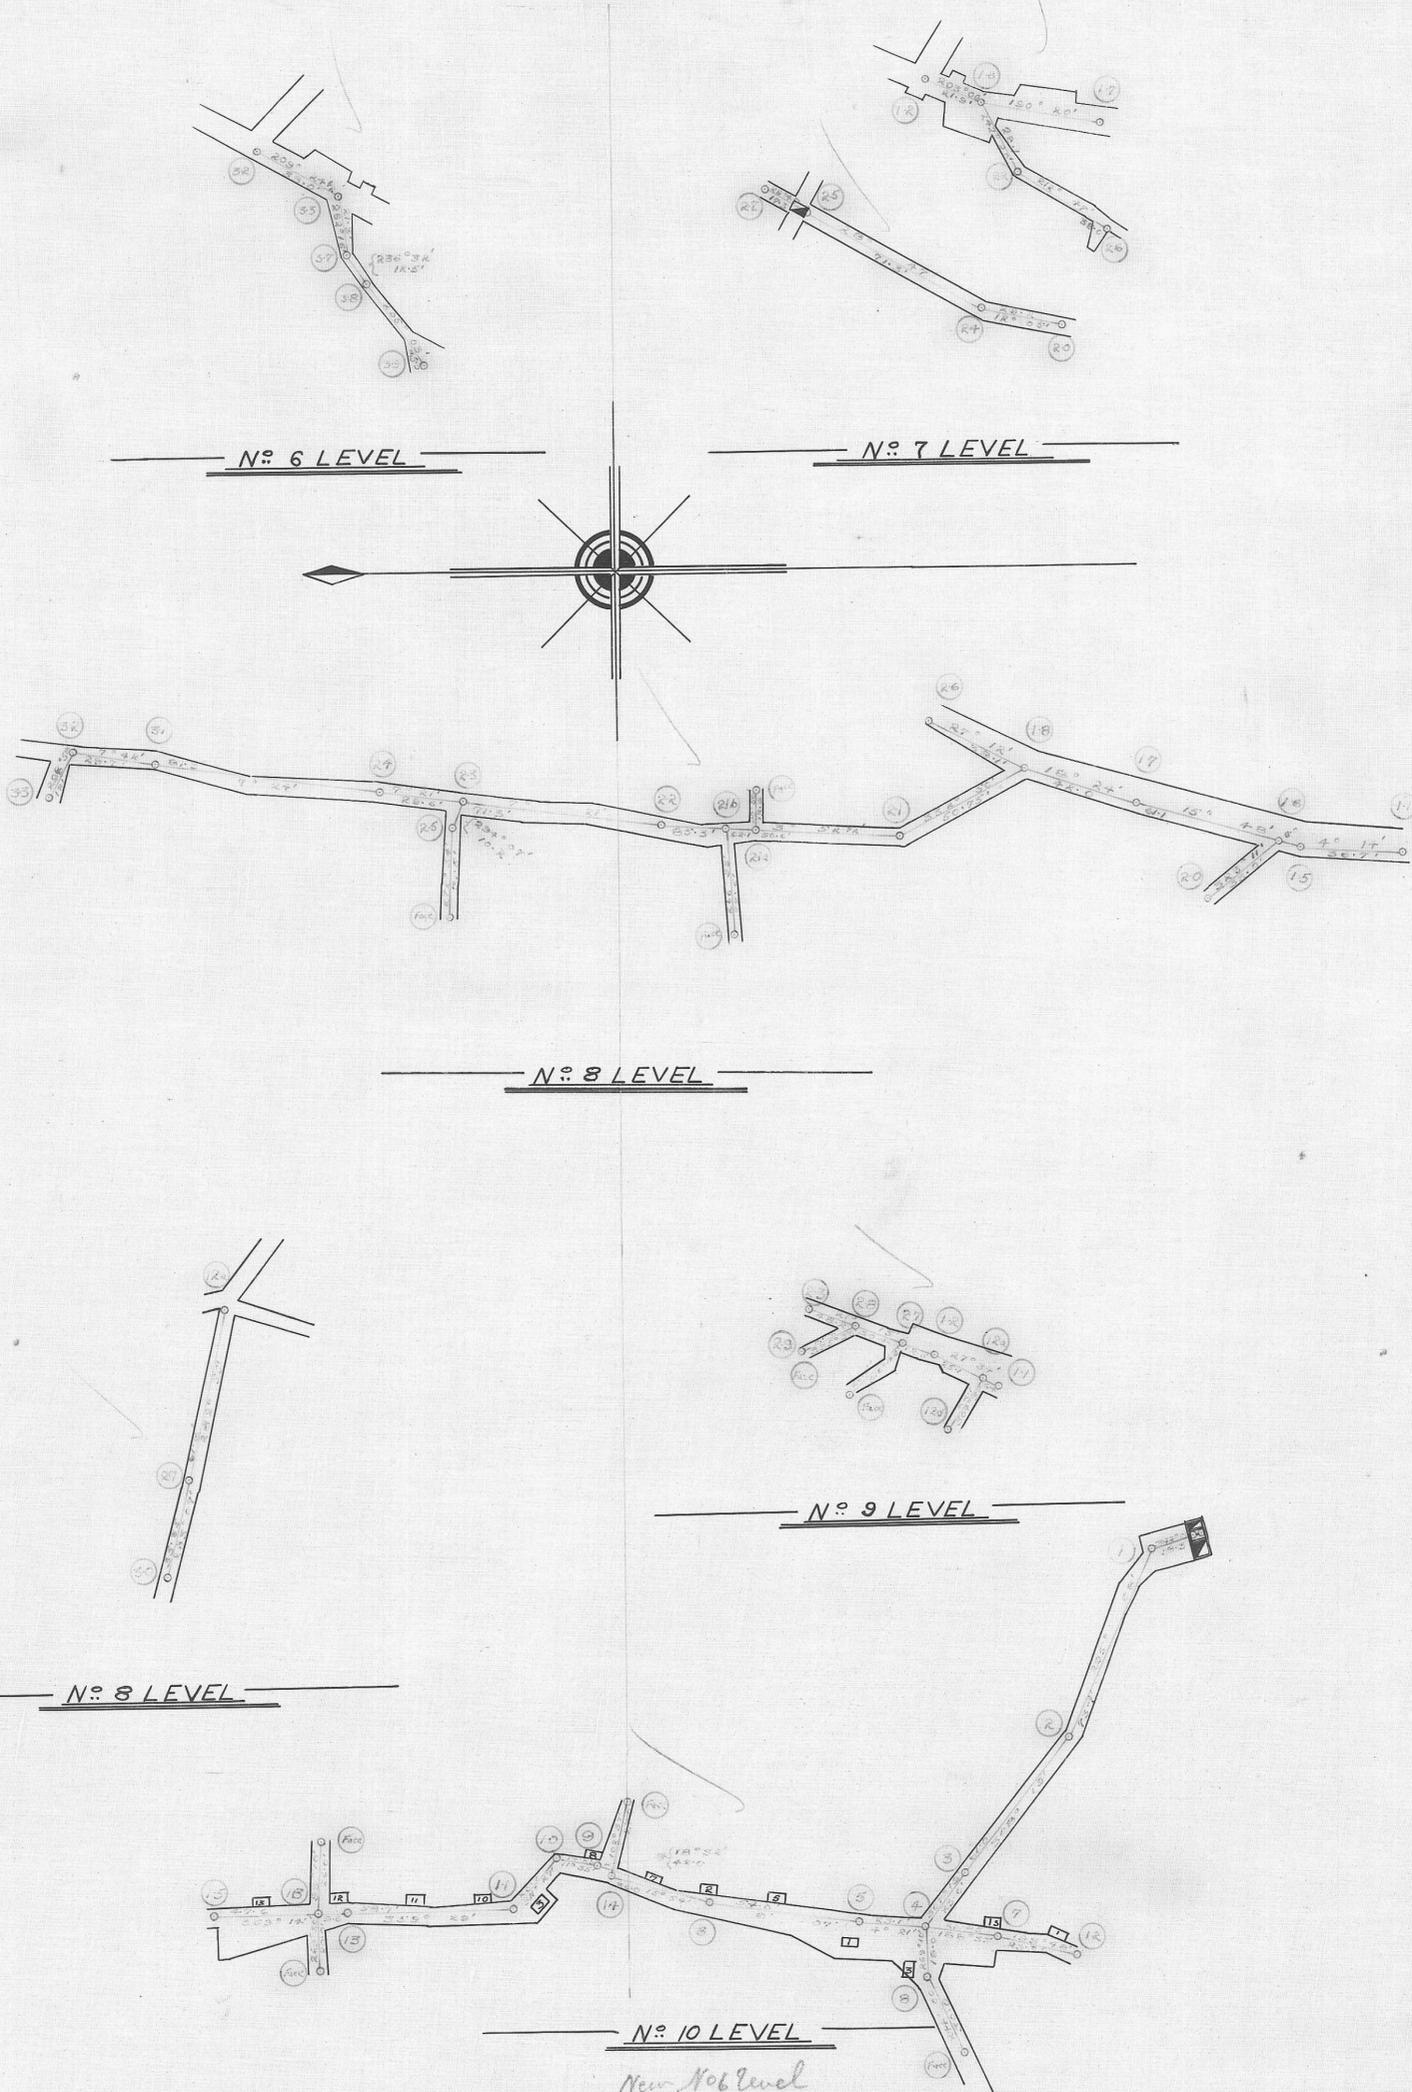

NORTH MOUNT FARRELL COY N.L.

SURVEYS MADE BY TRANSIT THEODOLITE

YEAR ENDING DEC 31st 1922

SCALE 40' = 1"

RECOVERED 1922
STATION
16/12/22

MAN
11/12/23

EX 2-6-23