

End 18.6.1920

NORTH M. FARRELL MAG. CO. N. L.

Scale 25 Feet to one inch

Underground Workings




No. 8 LEVEL

Also known as No. 4

SP-11

End 23.6.1920

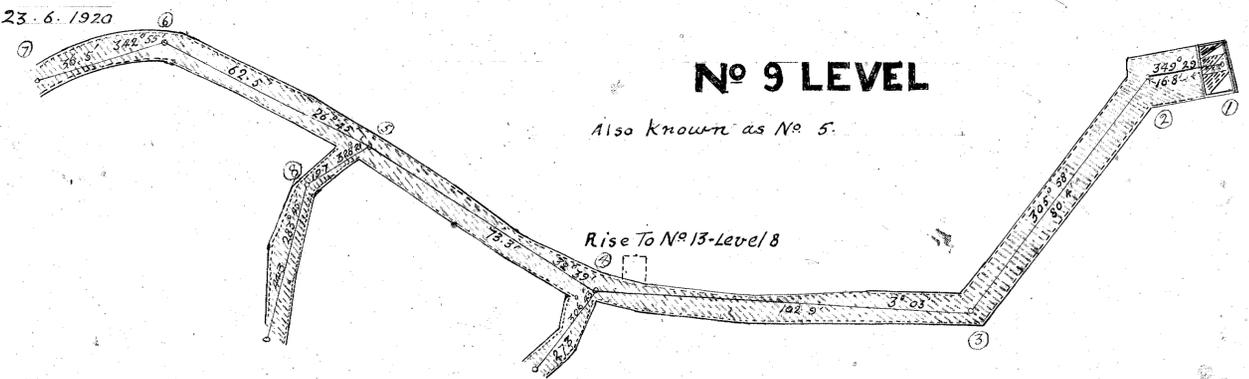

No. 9 LEVEL

Also known as No. 5.

Rise To No. 13-Level 8

J. H. Kline
Manager

This survey is effected with 4 1/2" and 5" transits,
and steel band chain - all in good adjustment.

J. H. Kline
Dist. Surveyor. June 30 1920

M. WILKINSON

SP-11