

130

NORTH MOUNT FARRELL MINING CO. N.L.


LONGITUDINAL SECTION OF SHAFT LEVELS

— Scale - 40 - Feet to an inch —


59-12

Cross Section

at
the Shaft

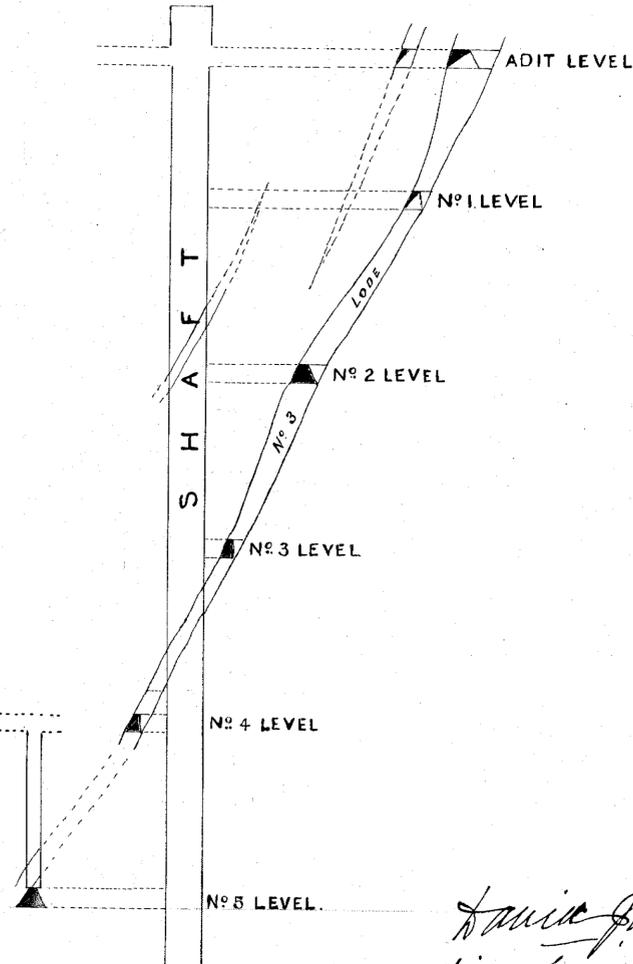

SECTION N° 3 LODE

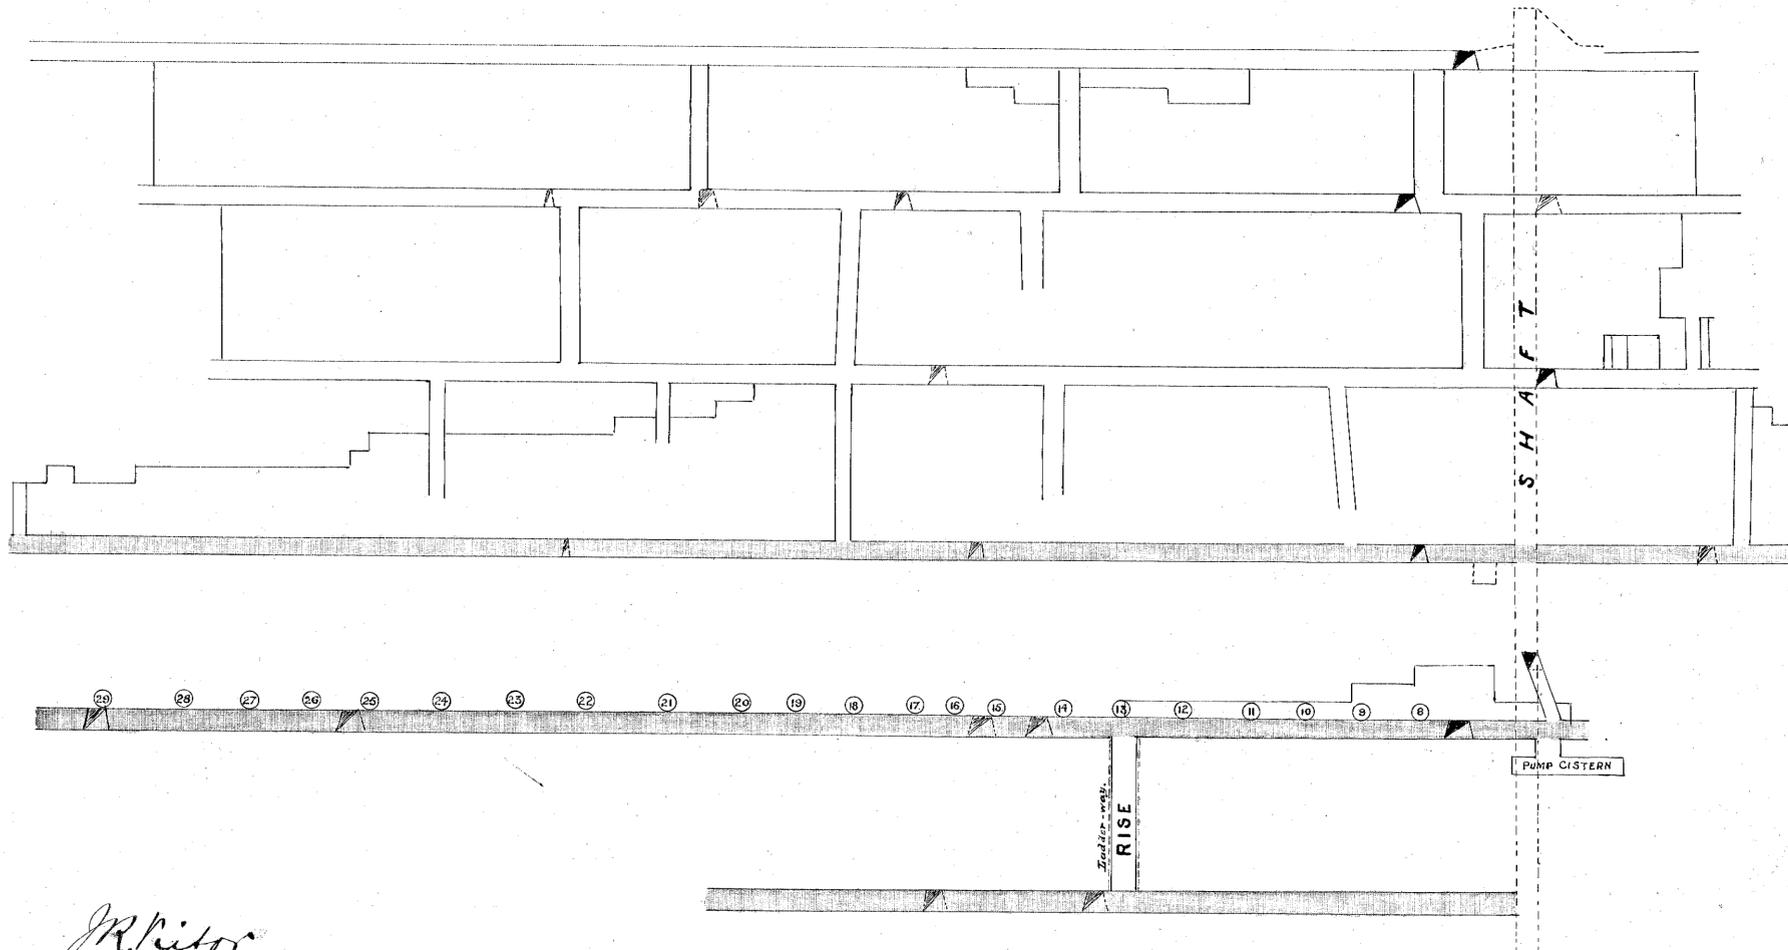

59-12

5 cm

130

Louis Jones,
Dist. Surveyor
Tallah.

J.R. Pitor
Manager

10.7.1920.

N° 3 LEVEL.

N° 4 LEVEL. 266' 73"

N° 5 LEVEL. 339' 103"