


59-13

59-13

North Mount Farrell Mining Coy. N.L. Consolidated Lease N^o 7191 M 183 acres

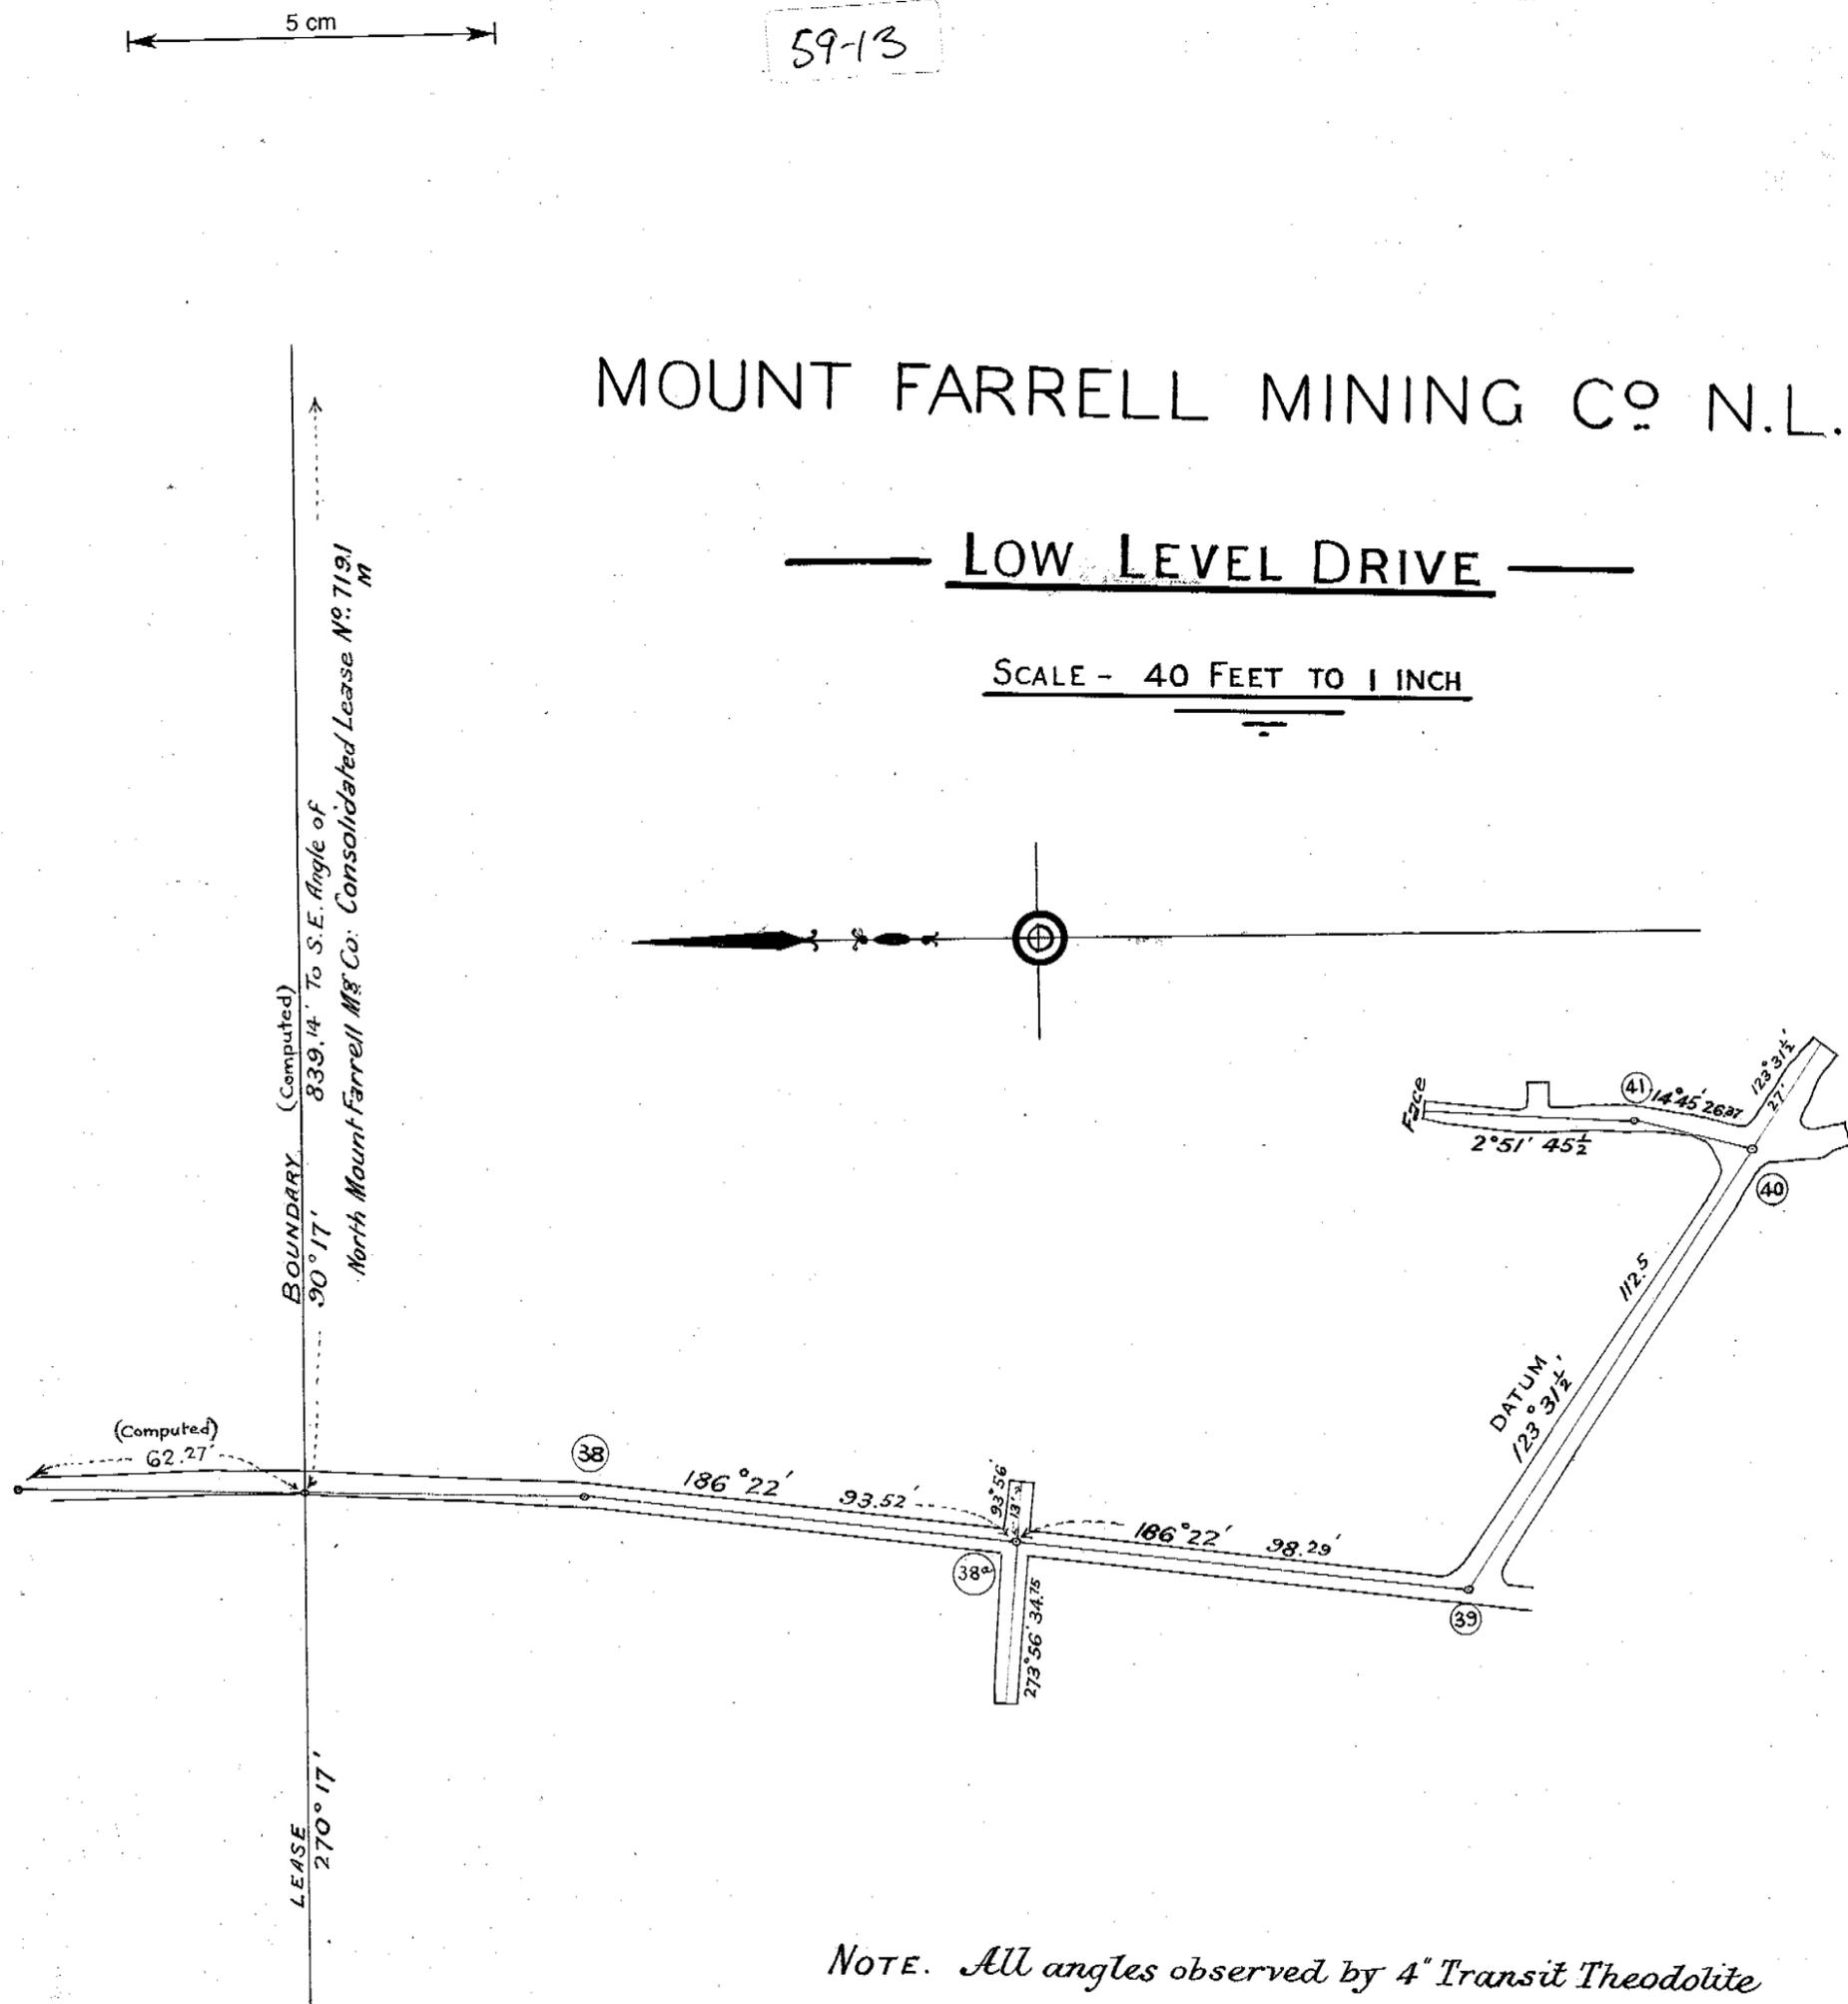

NOTE. All angles observed by 4" Transit Theodolite

A. H. Ardwick
Mining Surveyor
12th May 1919