

31 Dec. 1917
M. J. W. Young

59-15


5 cm

NORTH MOUNT FARRELL MINING CO.

PLAN OF NOS 6, 7, & 8 LEVELS.

— *Shewing extensions for year ending, 31-12-1917* —

— SCALE - 25 - FEET TO ONE INCH —

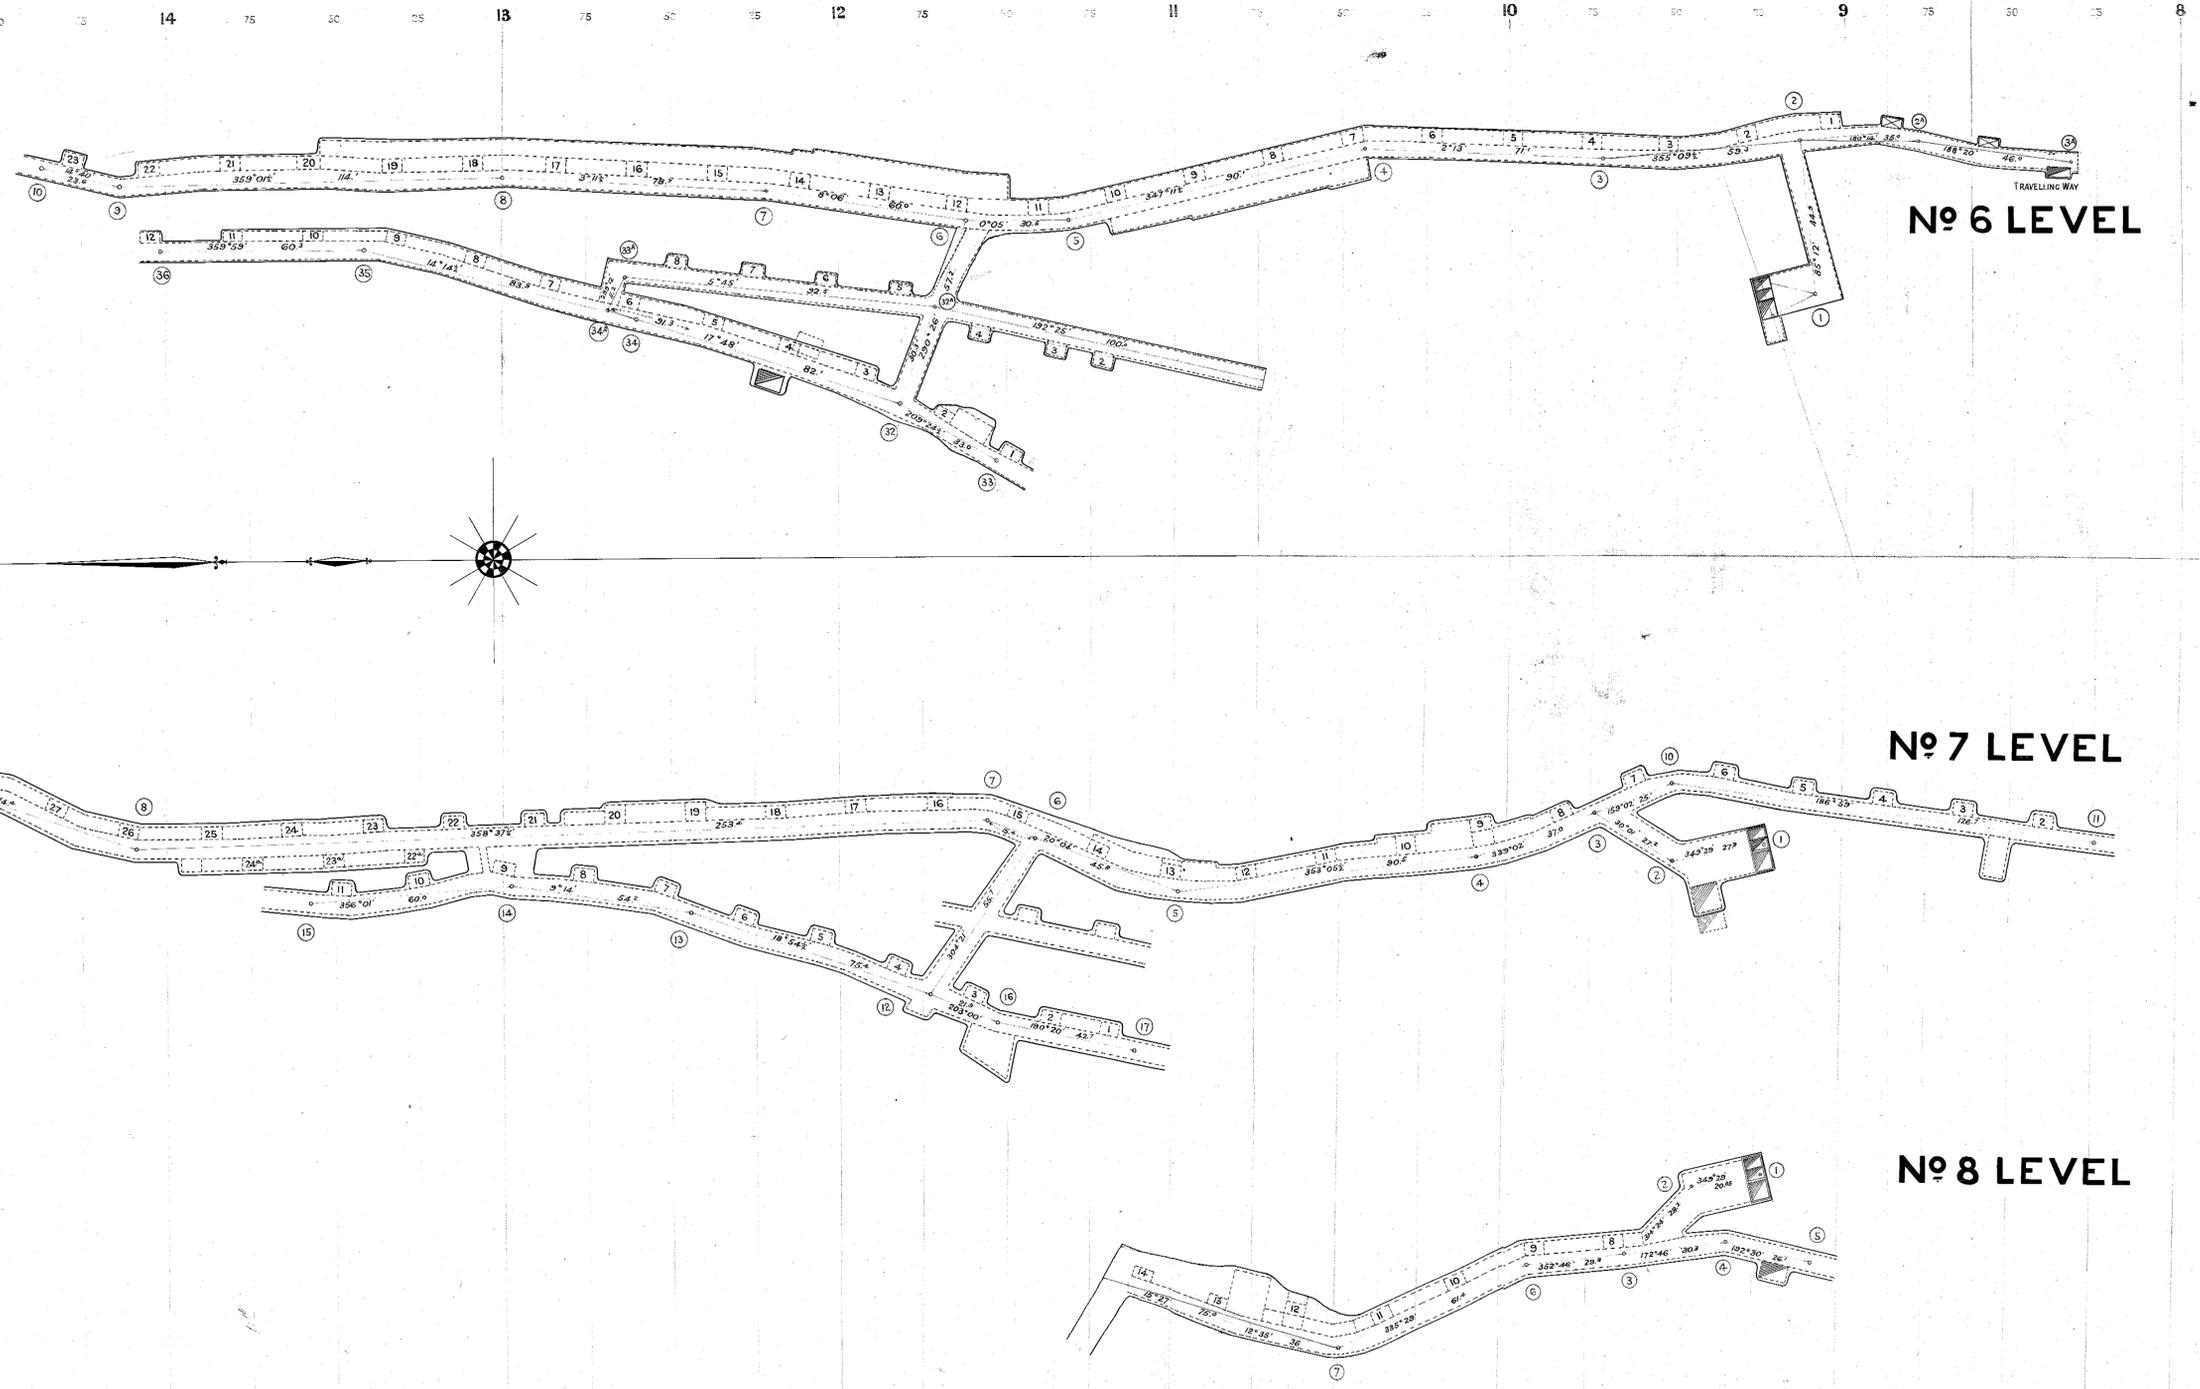

No 6 LEVEL

No 7 LEVEL

No 8 LEVEL

L. A. Woodroffe
Mining Manager