




NORTH MOUNT FARRELL MINING CO., N.L.

M.L. No 3818

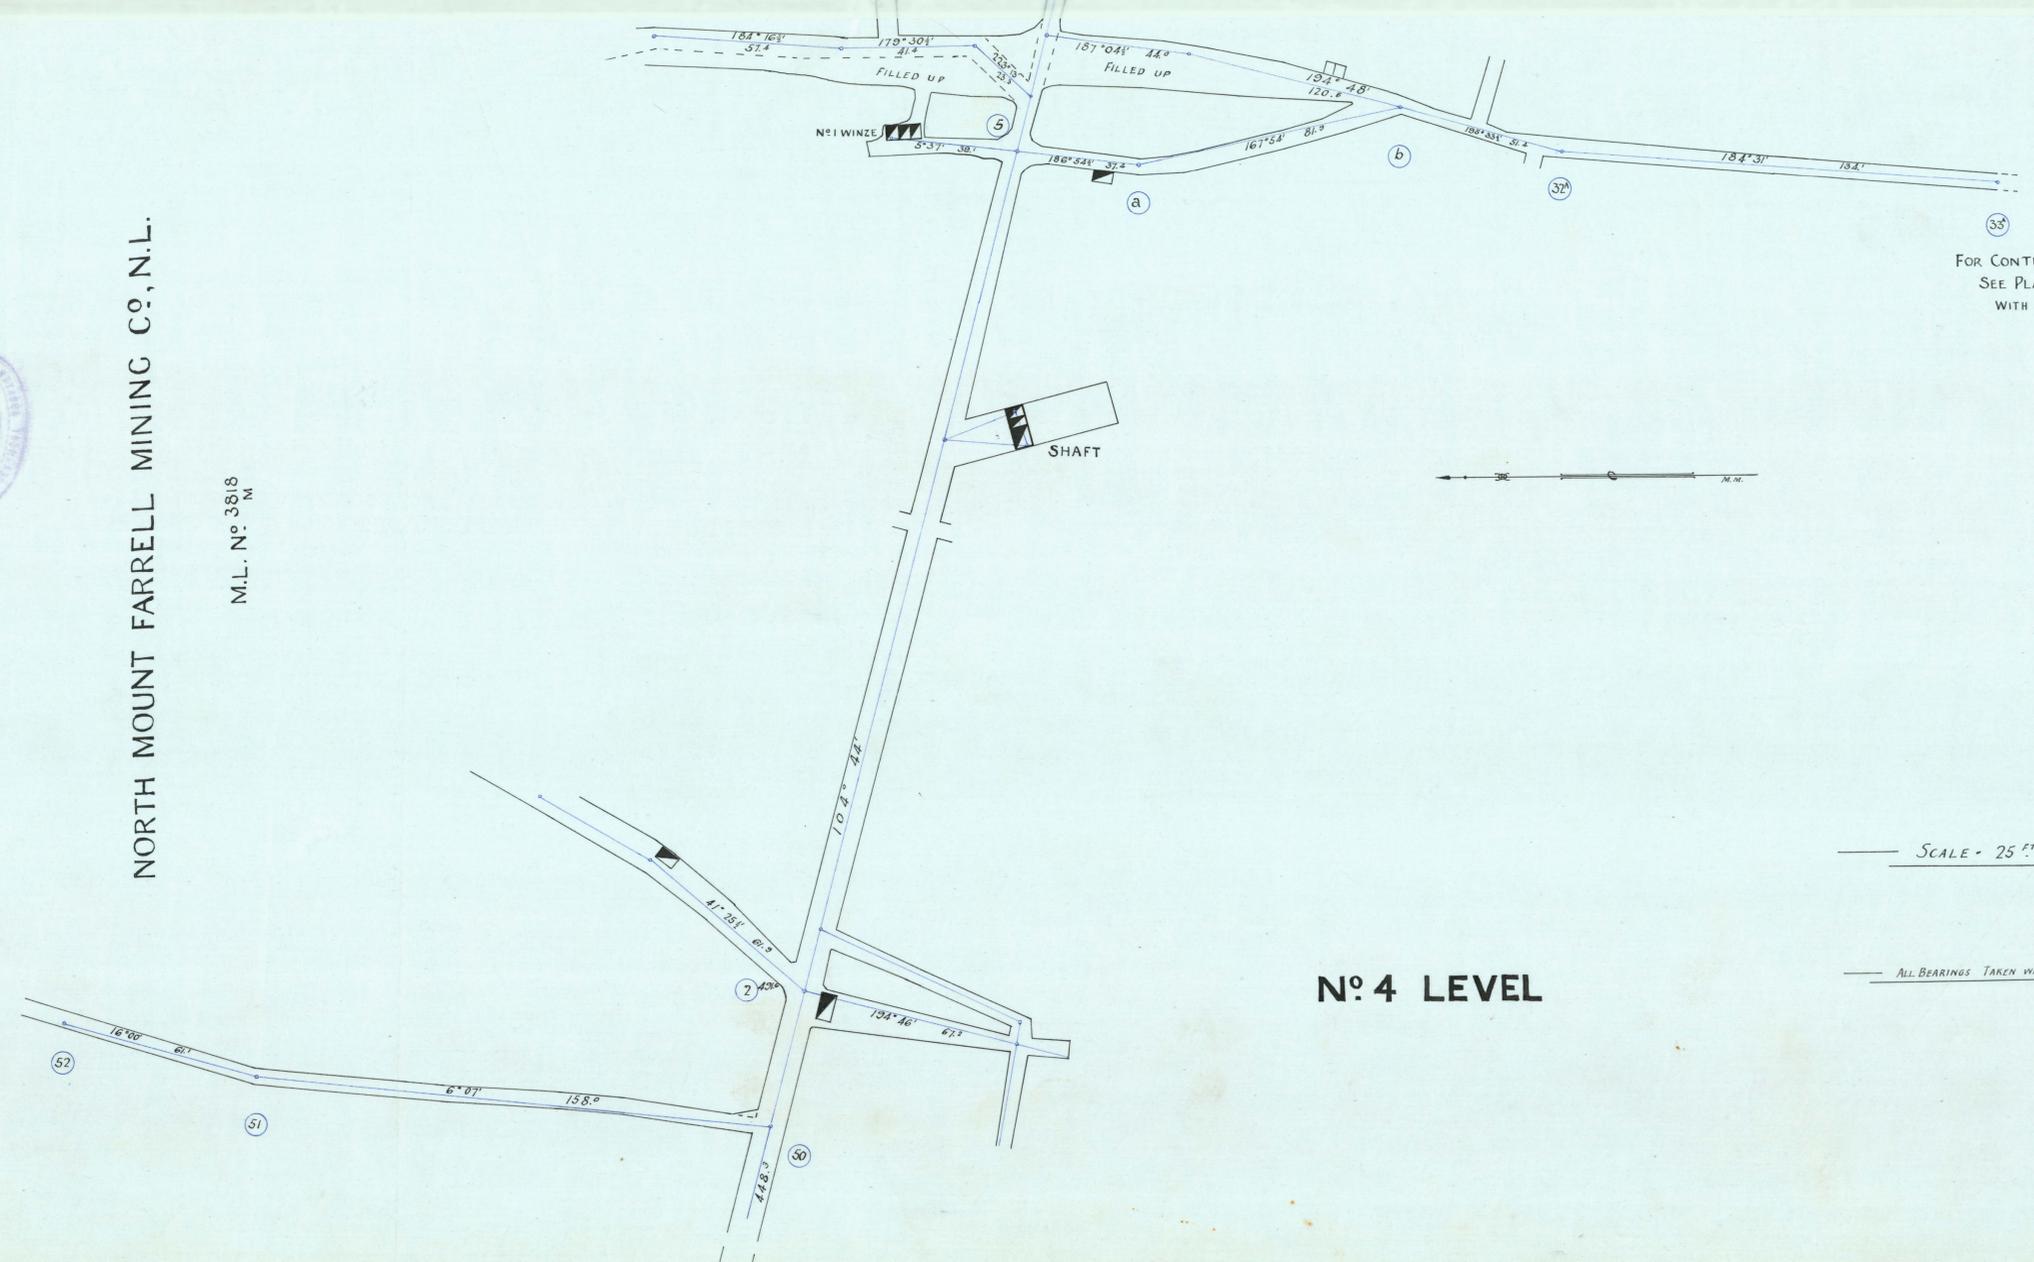


No. 4 LEVEL

FOR CONTINUATION
SEE PLAN OF JOINT DRIVE
WITH MOUNT FARRELL M.C.

SCALE - 25 FT TO 1 INCH

ALL BEARINGS TAKEN WITH TRANSIT THEODOLITE

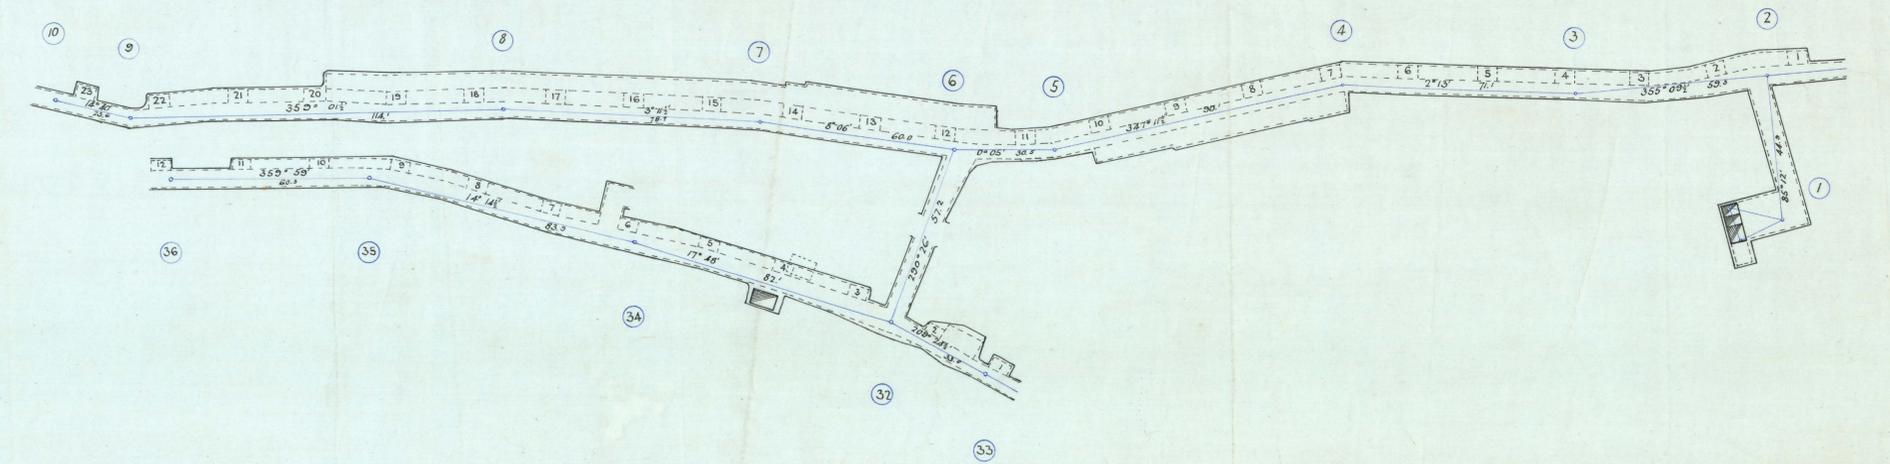

No. 6 LEVEL

L. H. Woodroffe B.C.E.
MINE MANAGER.
31-3-17

