

59-20

5 cm


NORTH MOUNT FARRELL MINE

PLAN OF PORTION OF WORKINGS N° 5 LEVEL

EXTENSIONS FOR YEAR 1912

SCALE 25 FT. = 1 IN.

J. C. Woodruff B.C.E.

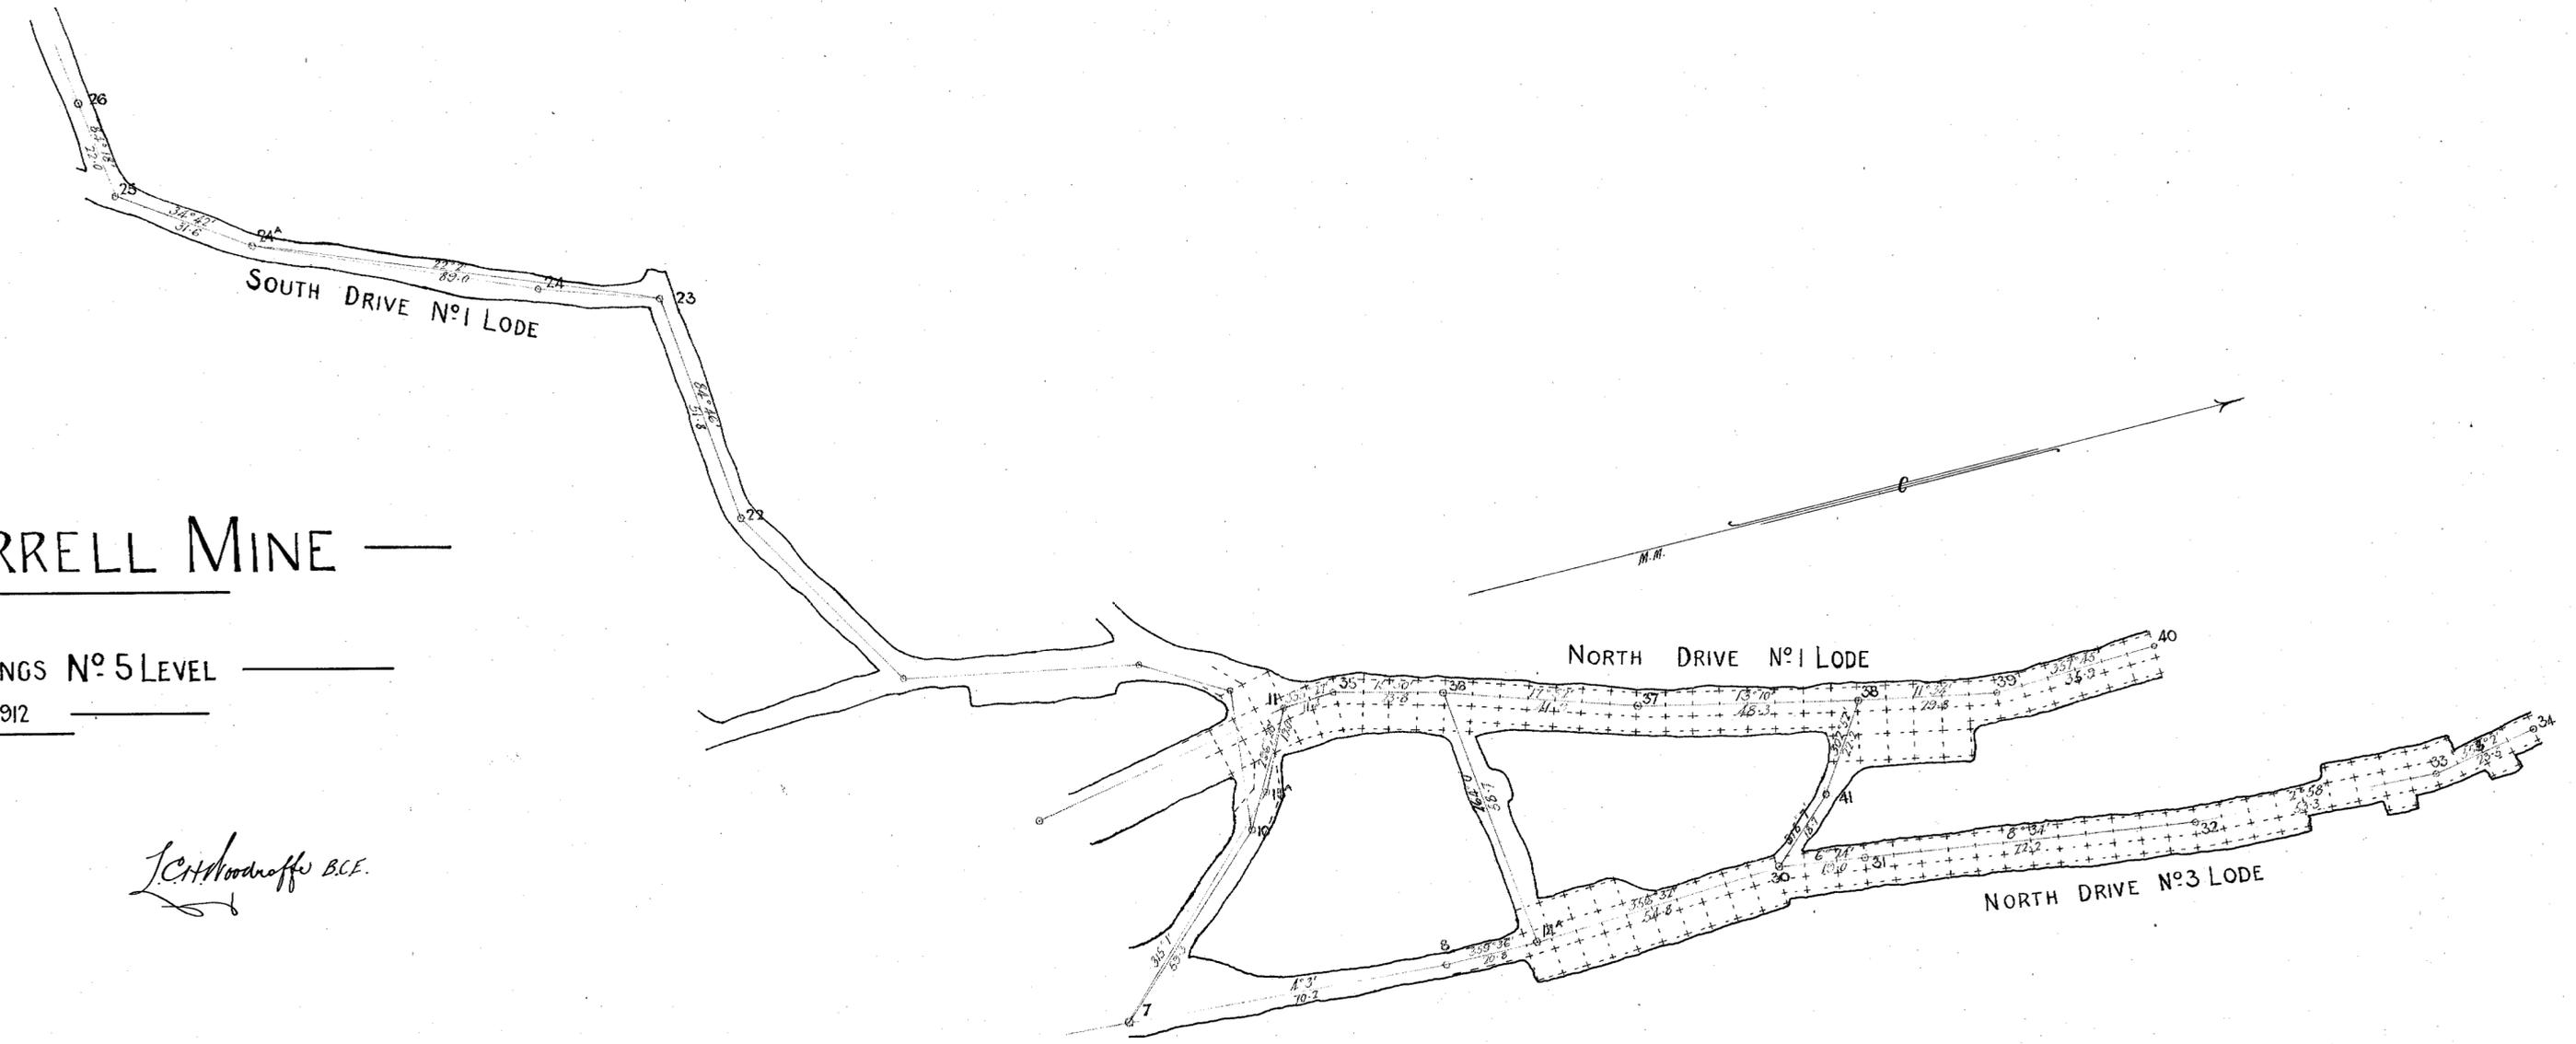

59-20