

NORTH MOUNT FARRELL MINE

LONGITUDINAL SECTION OF WORKINGS

SCALE: 30 FT = 1 IN.

NOTE: GROUND STOPPED OUT APRIL 30TH 1912
COLORED RED


L. C. Woodroffe, B.C.E.

59-23

← NORTH


5 ft

59-23

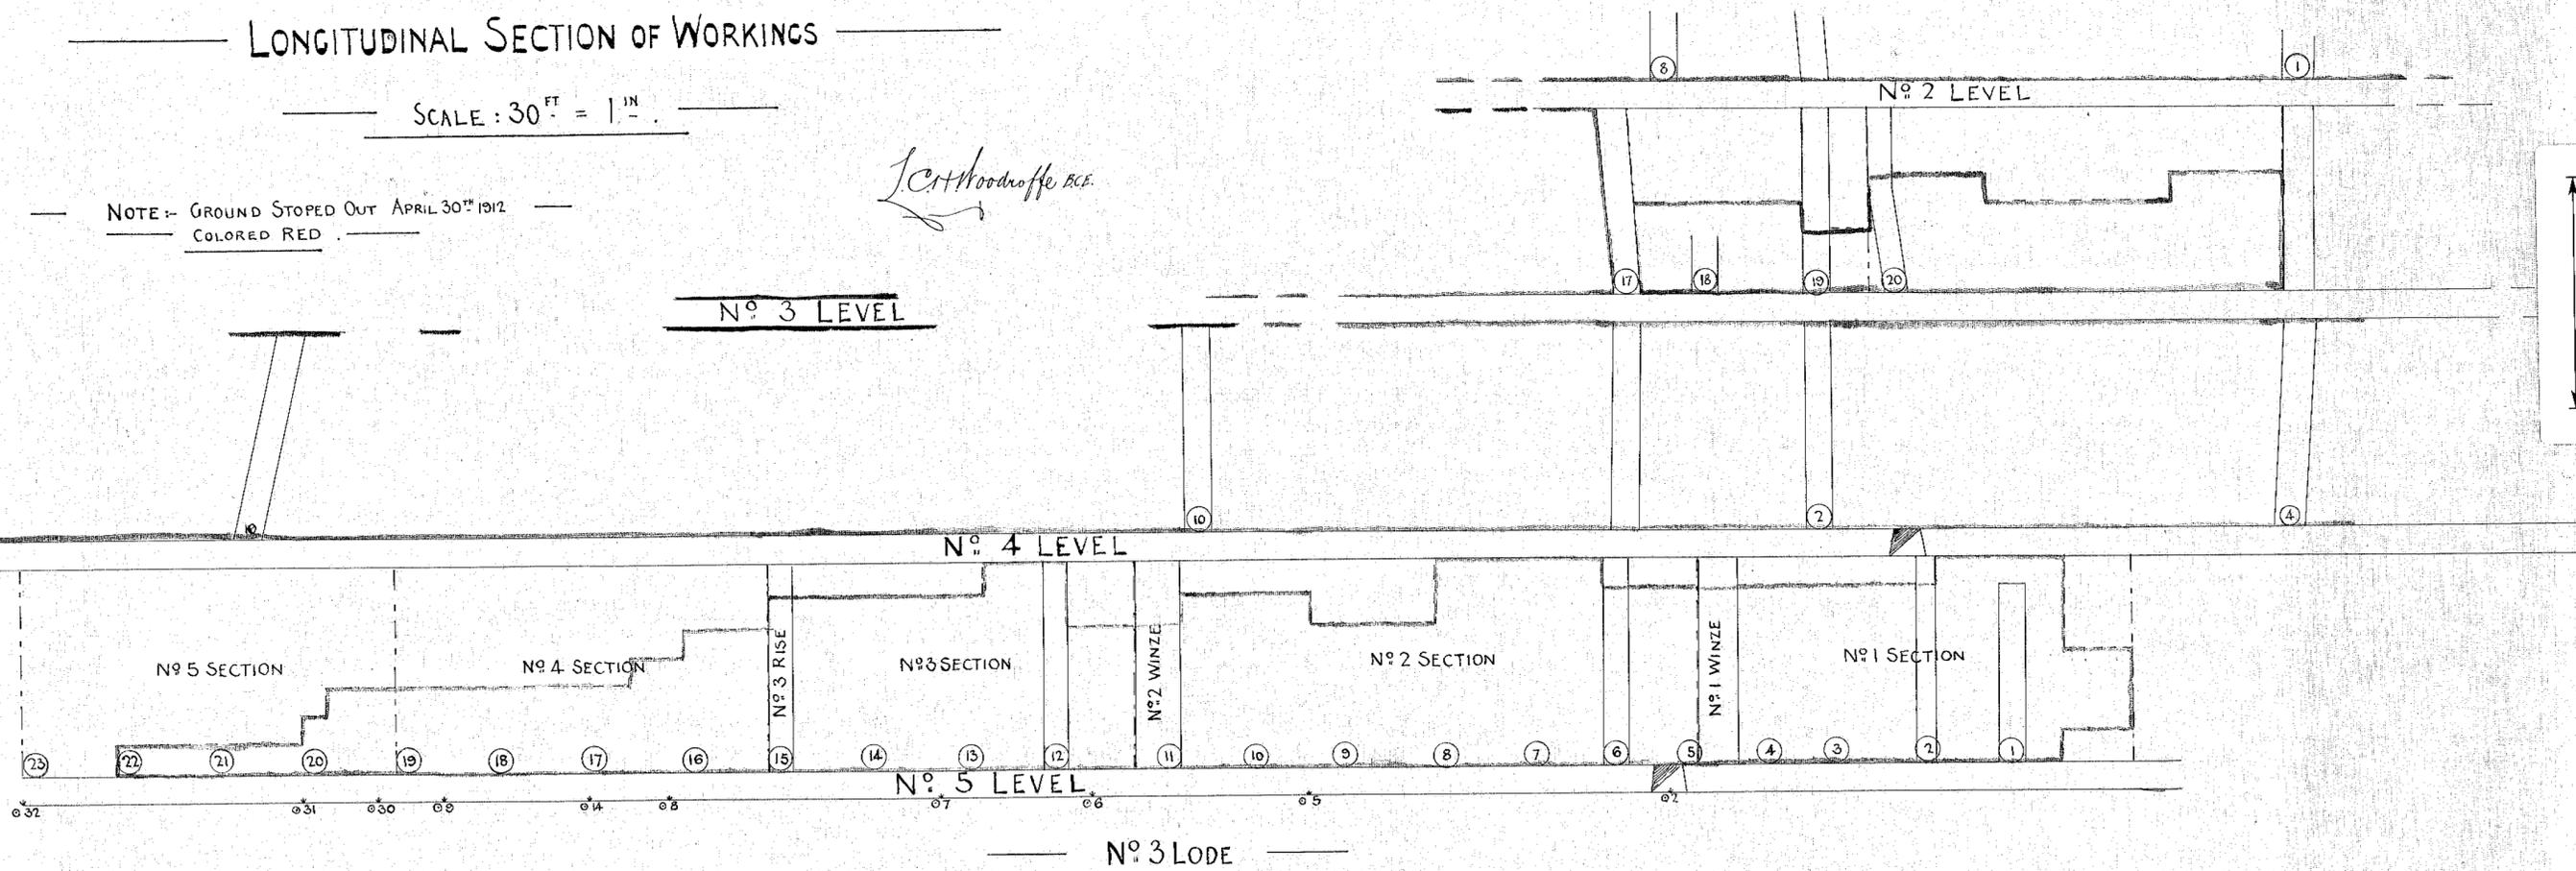


← SOUTH

← SOUTH

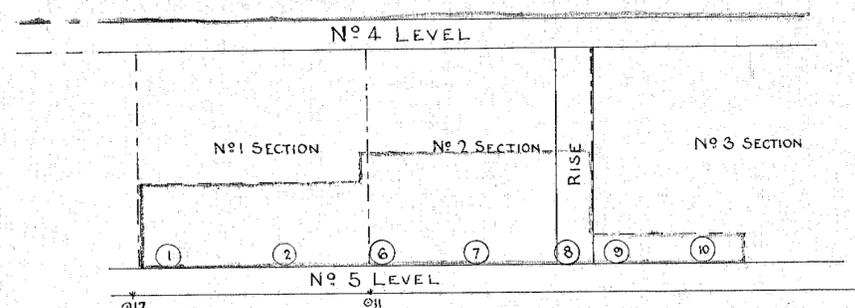

No. 1 LOSE

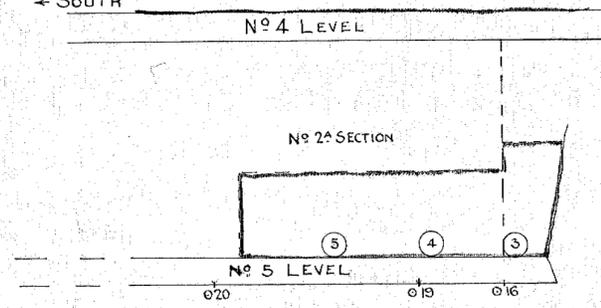

No. 2 LOSE

130