

59-24

# NORTH MOUNT FARRELL MINE

## PLAN

OF

### EXTENSIONS OF WORKINGS AT N°5 LEVEL


FOR YEAR ENDED DEC. 31<sup>ST</sup> 1911.

Scale: 25<sup>ft</sup> = 1 inch

Surveyed & Plotted by

*J. C. Woodroffe* B.C.E.

GENERAL MANAGER

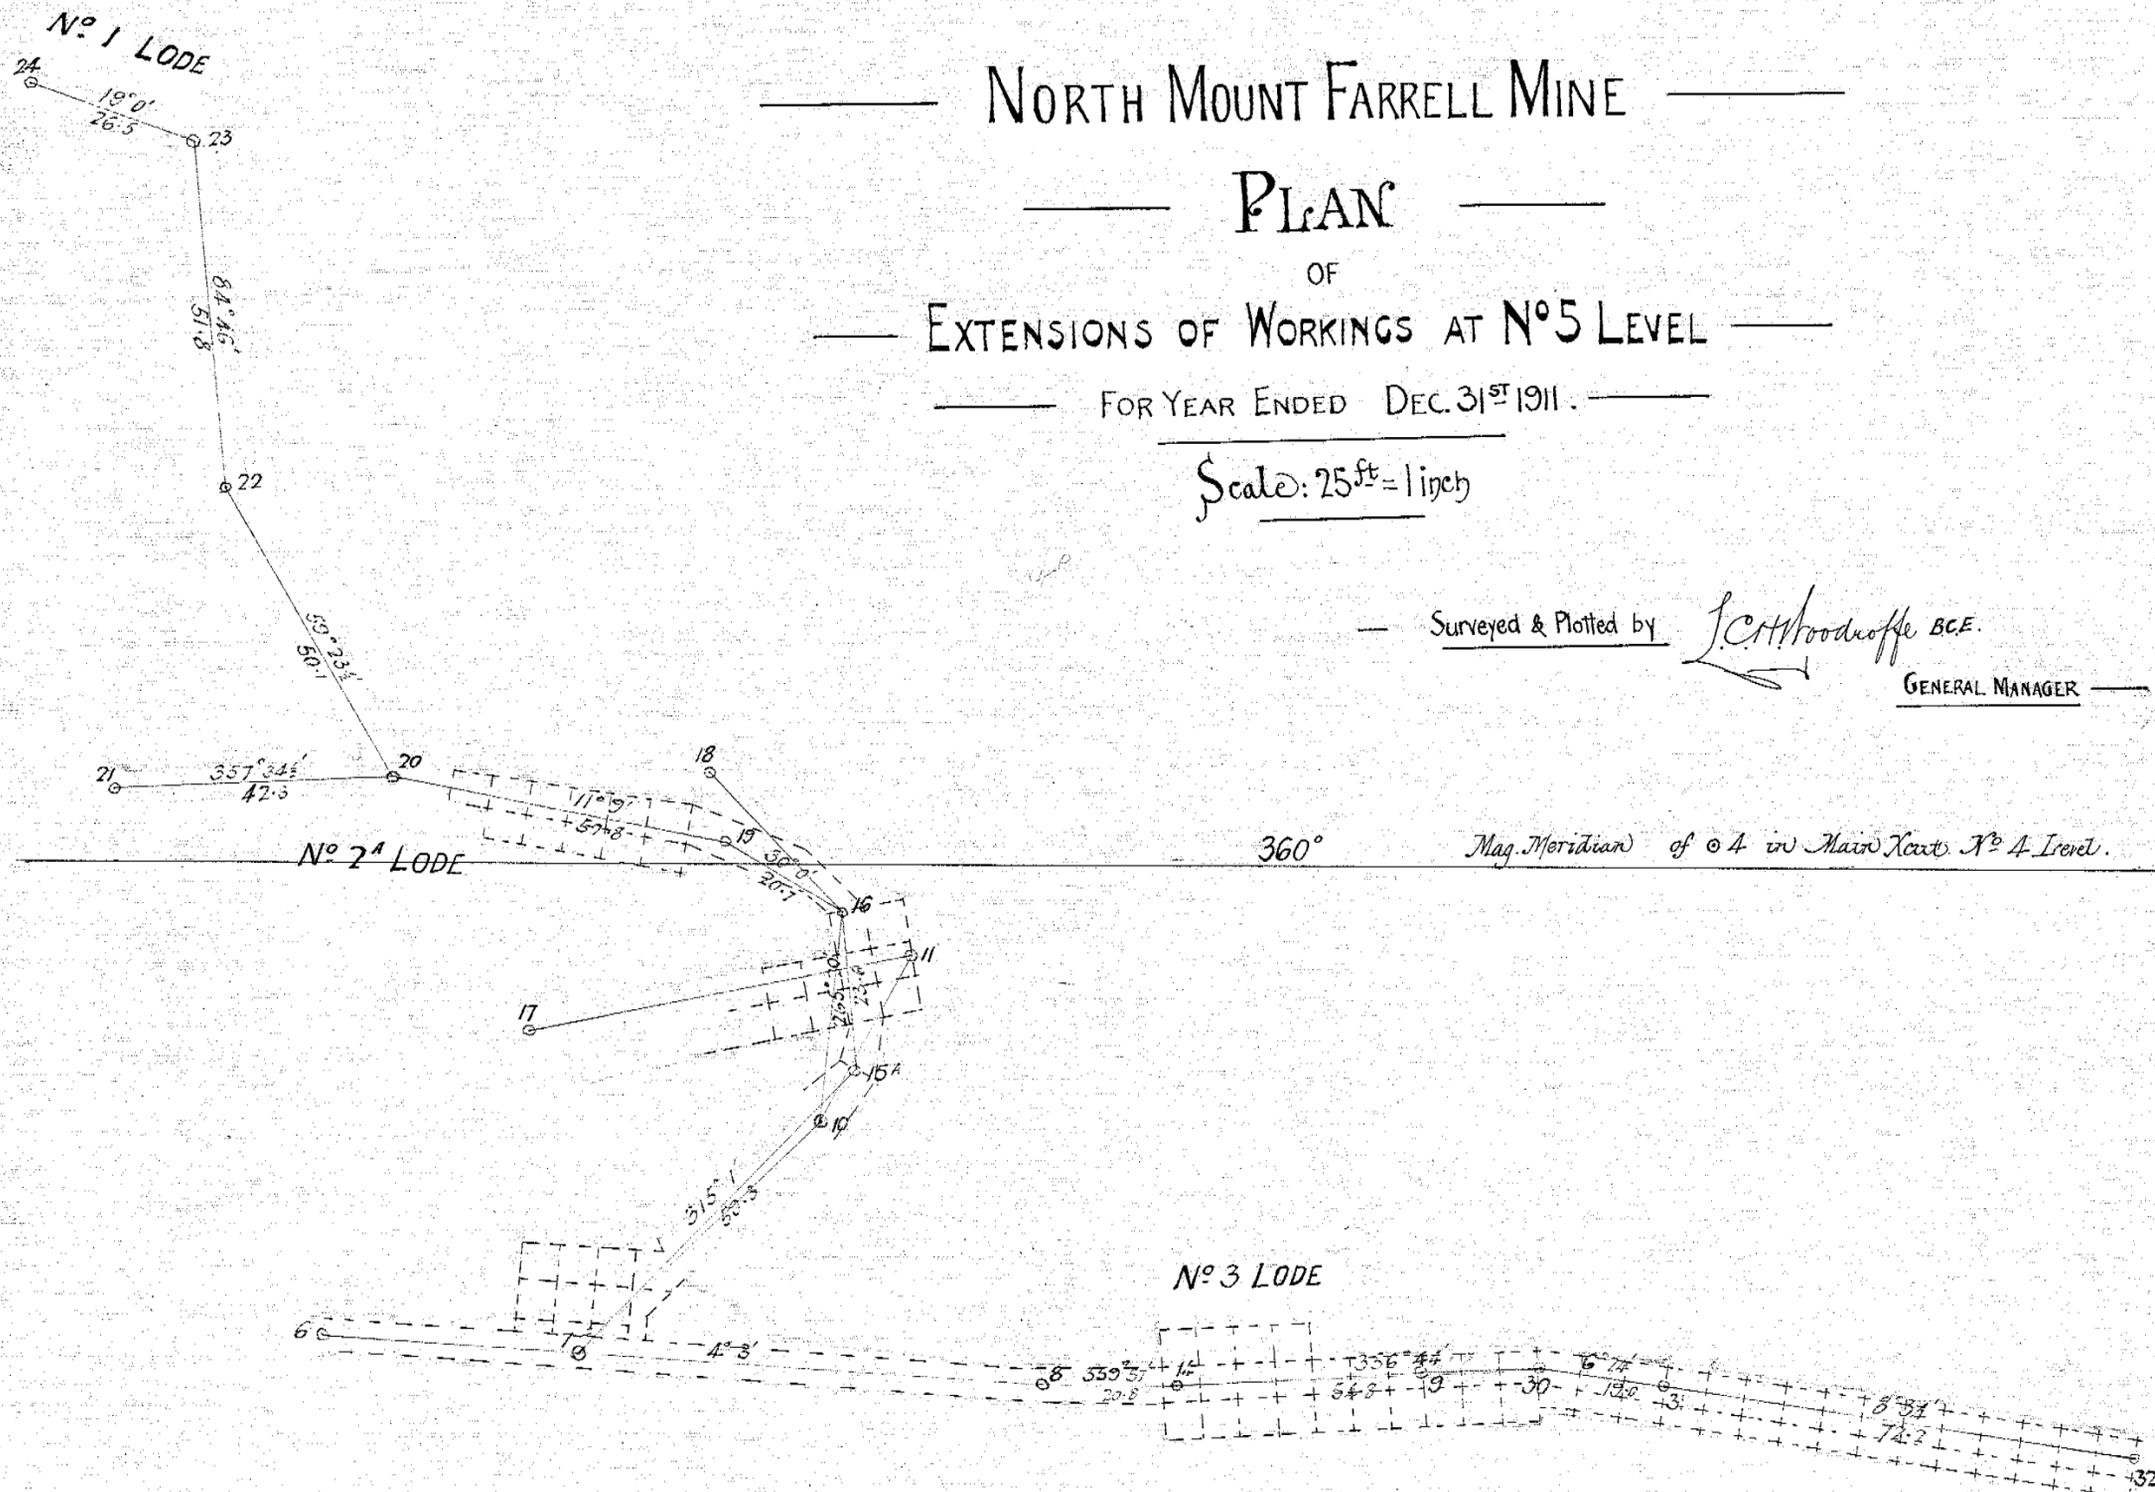

5 cm

59-24