


59-25

5 cm

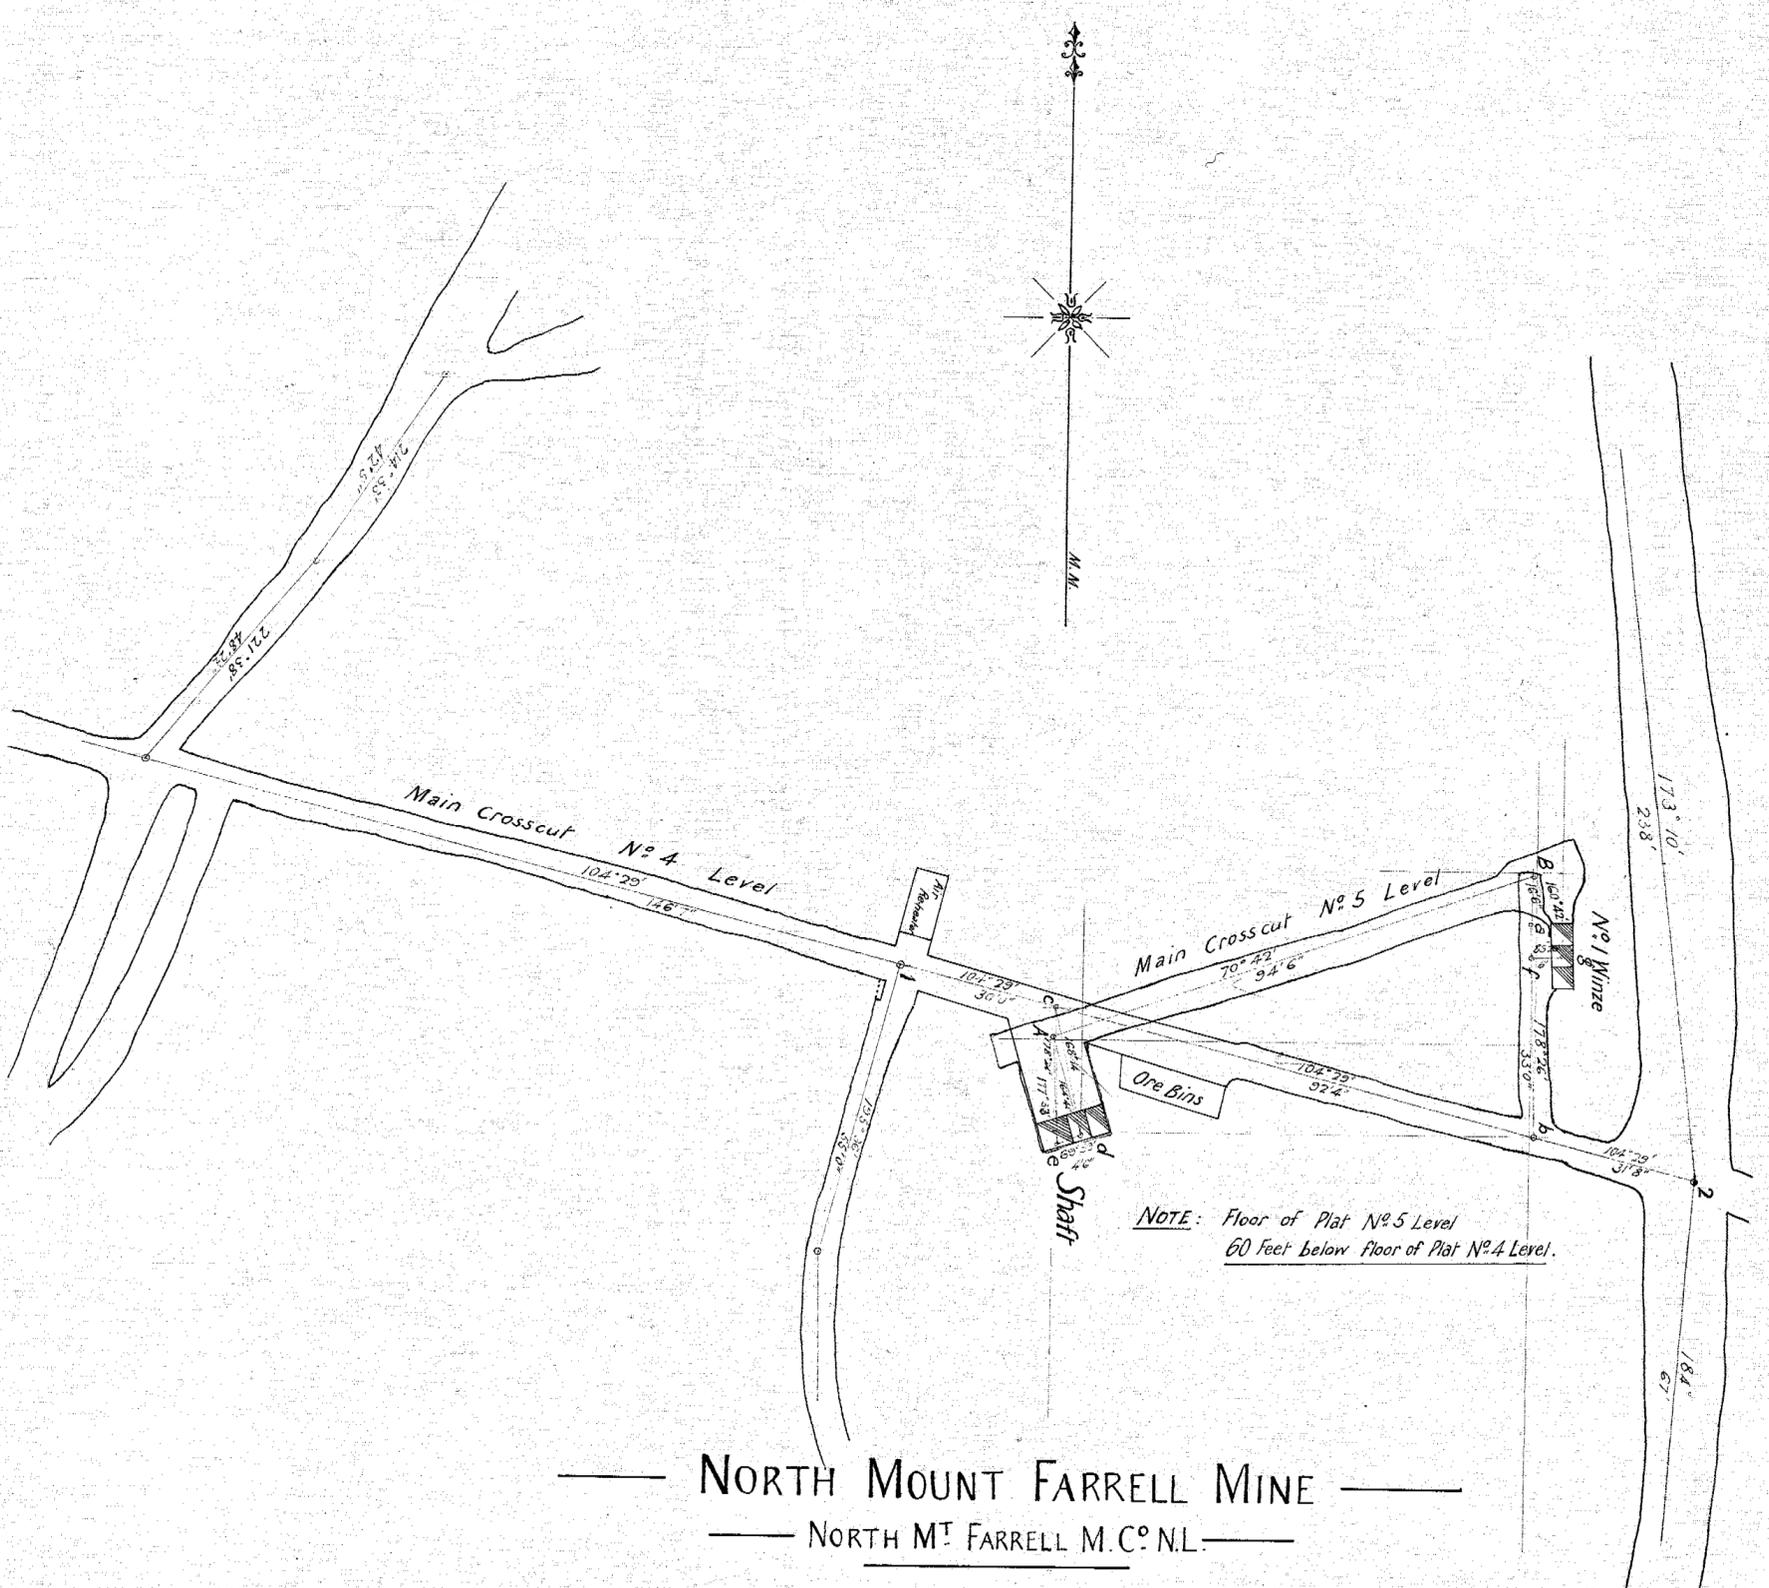

NORTH MOUNT FARRELL MINE

NORTH MT FARRELL M. CO. N.L.

PLAN

— SHEWING EXTENSION OF MINE WORKINGS —

— FOR YEAR ENDED 31ST DECEMBER 1909 —

— SCALE 25 FEET TO 1 INCH —

NOTE: Floor of Plat No. 5 Level
60 Feet below Floor of Plat No. 4 Level.

NOTE — SURVEY MADE WITH A 5" THEODOLITE

ON DEC 27TH 1909

BY LCH Woodroffe B.C.E.

MINE MANAGER

LCHW
1910

