


NORTH MOUNT FARRELL MINE

LONGITUDINAL SECTION WORKINGS N^o 3 LODGE

SCALE 30 FT. = 1 IN.

NOTE: GROUND STOPPED OUT TO DATE, 31 OCT. 1910,
COLORED RED

*L. C. Howard & Co. Sec.
Min. Eng.
3/14/10*

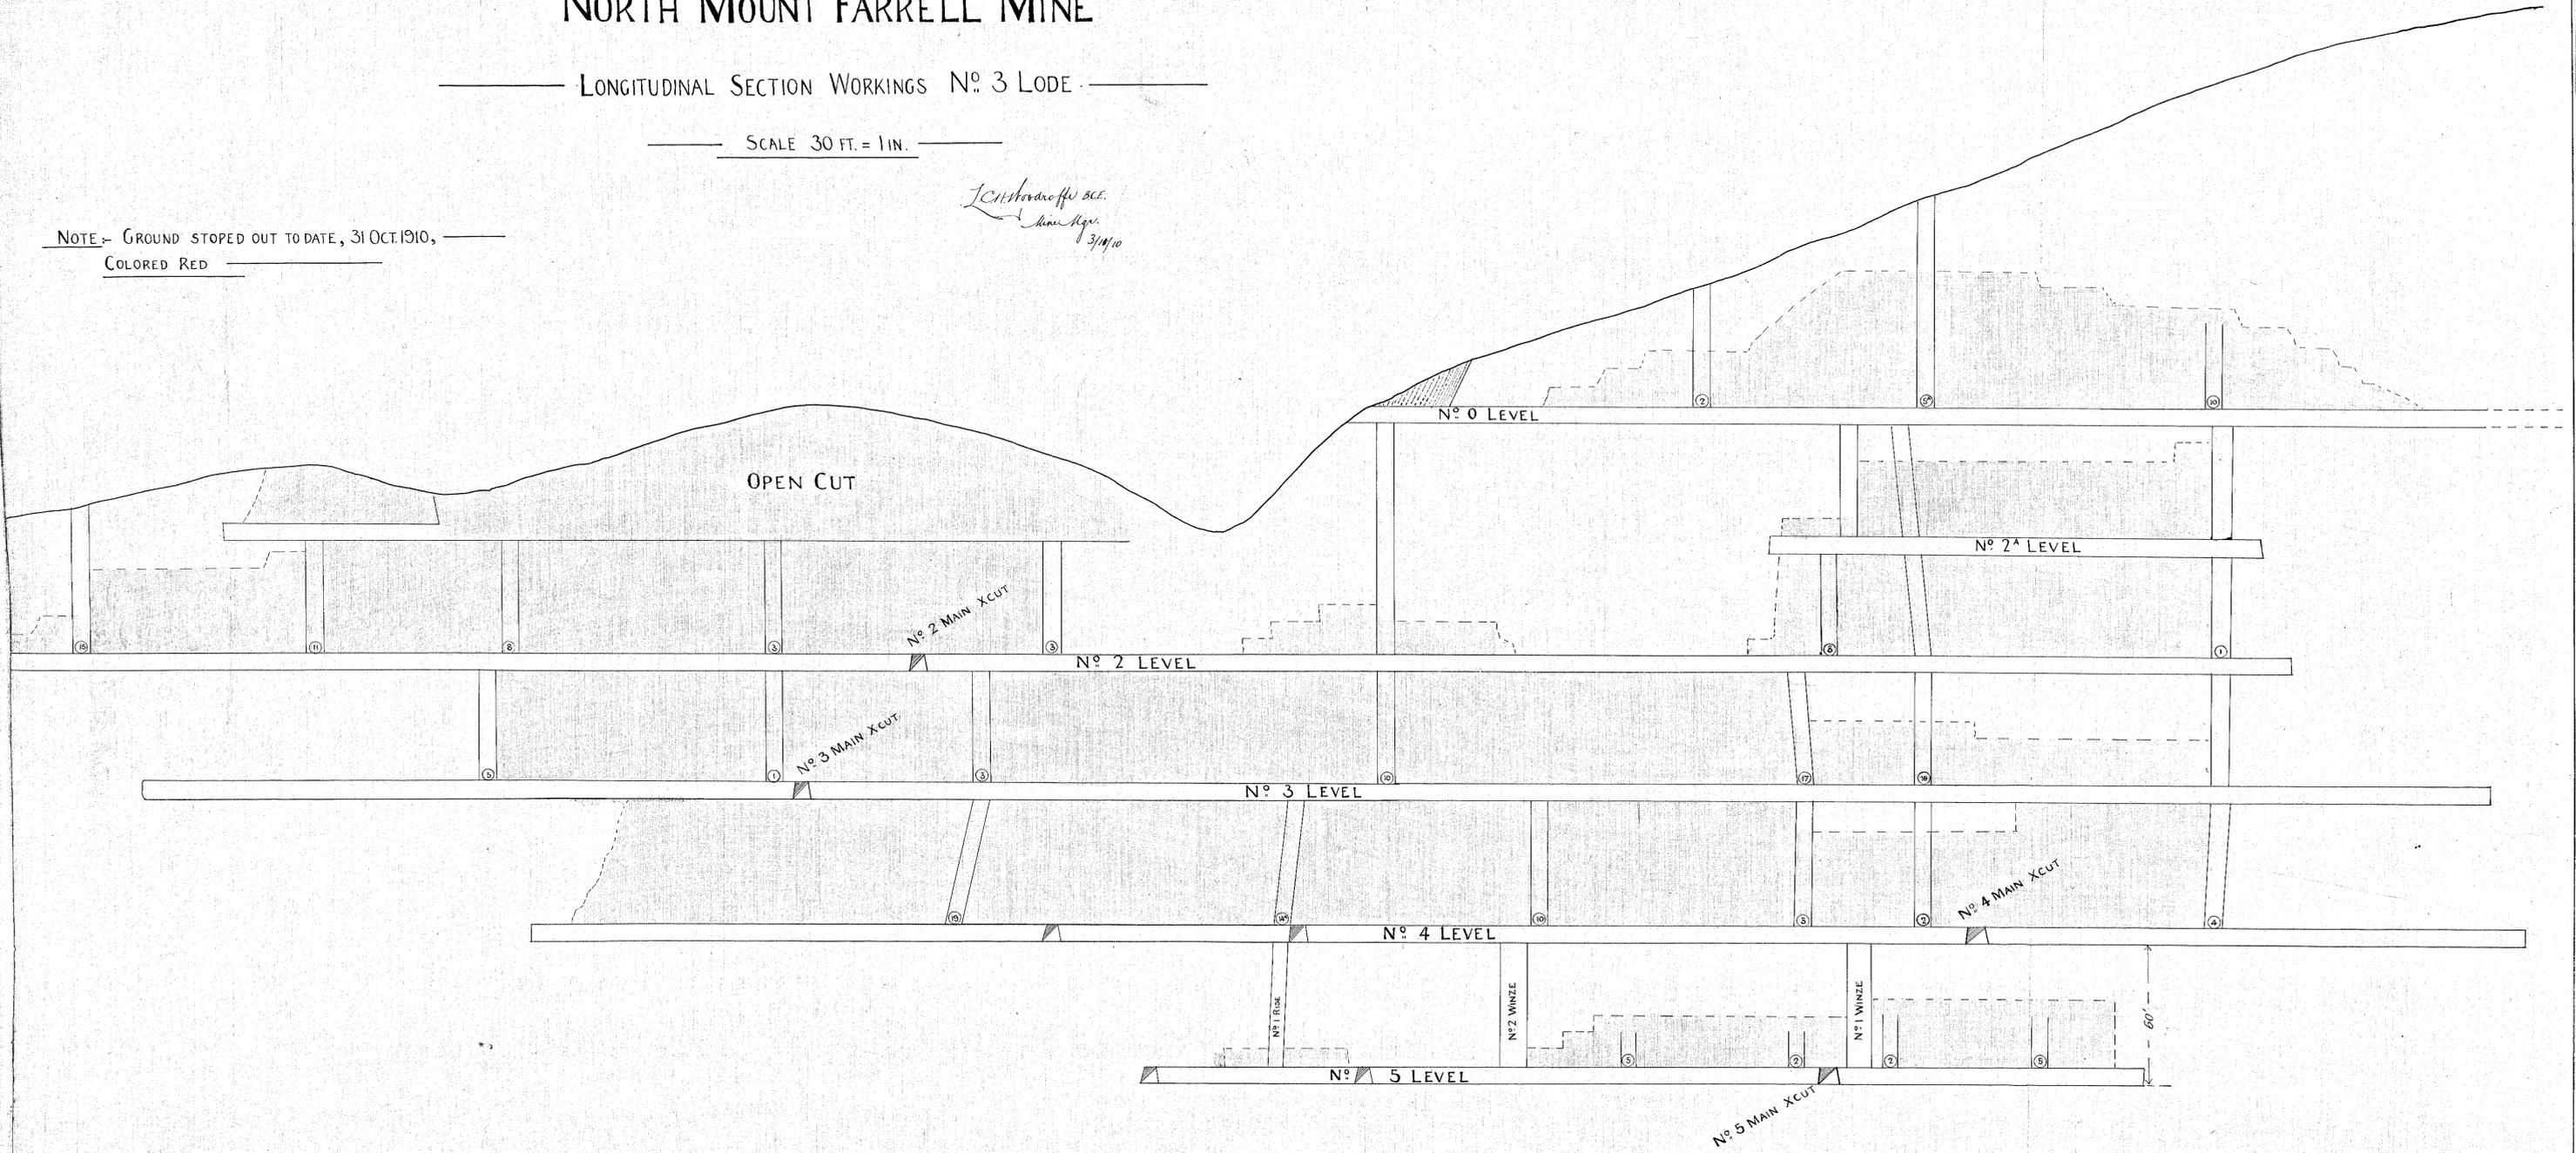

50'

51-27

