


NORTH MT FARRELL MINE

Scale 25 feet to 1 Inch

Survey made with the theodolite

W.R. Salo

March 21st 1908

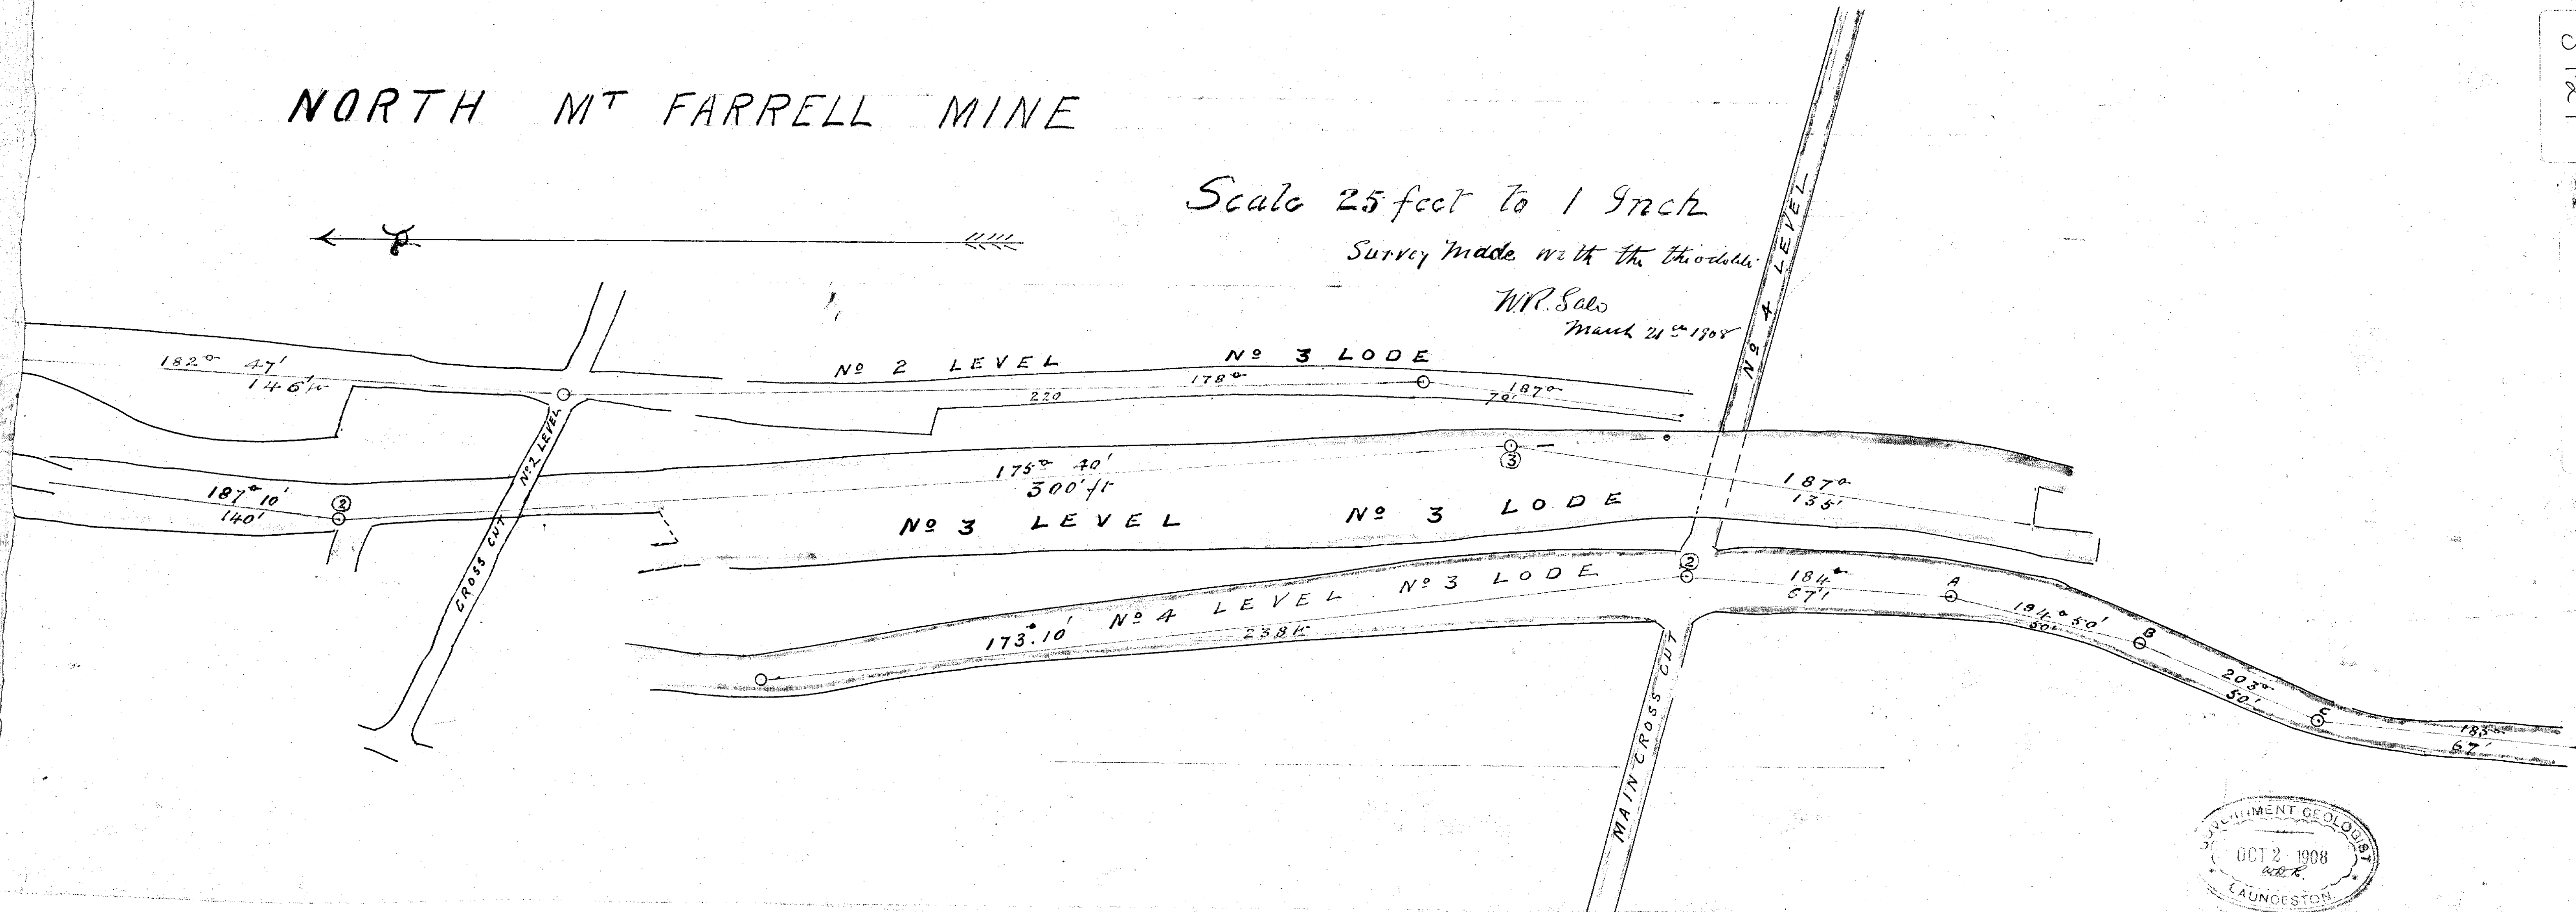

59-29

5 cm

59-29

