


NORTH MT FARRELL

SCALE 25 FT TO AN INCH


LONGITUDINAL SECTION

Nº 2 LEVEL

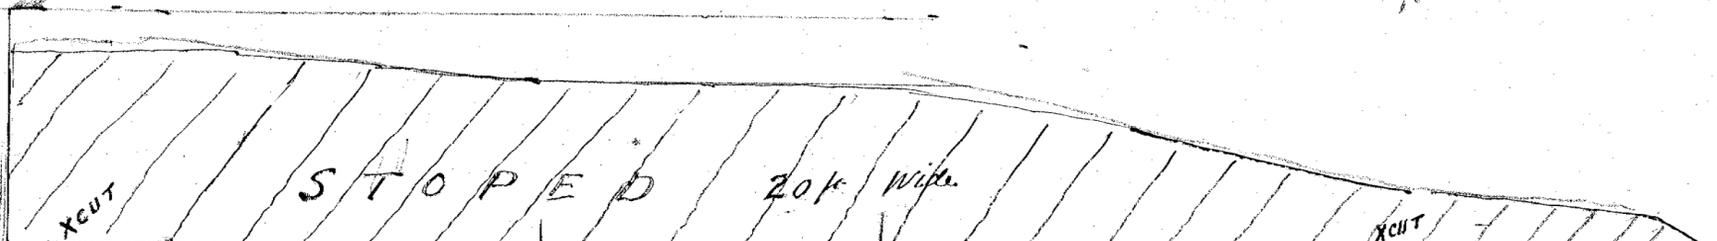


W.R. Sale
Mine Manager
July 19th 1907

Nº 3 LEVEL Nº 3 LODE

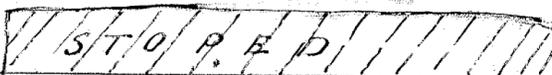

Nº 4 LEVEL Nº 3 LODE

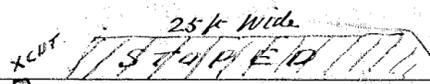

5 cm

59-31

