



59-32

130

Mount Farrell
0091.008

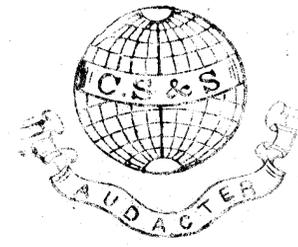


Charles Schleicher & Schill
Düren.

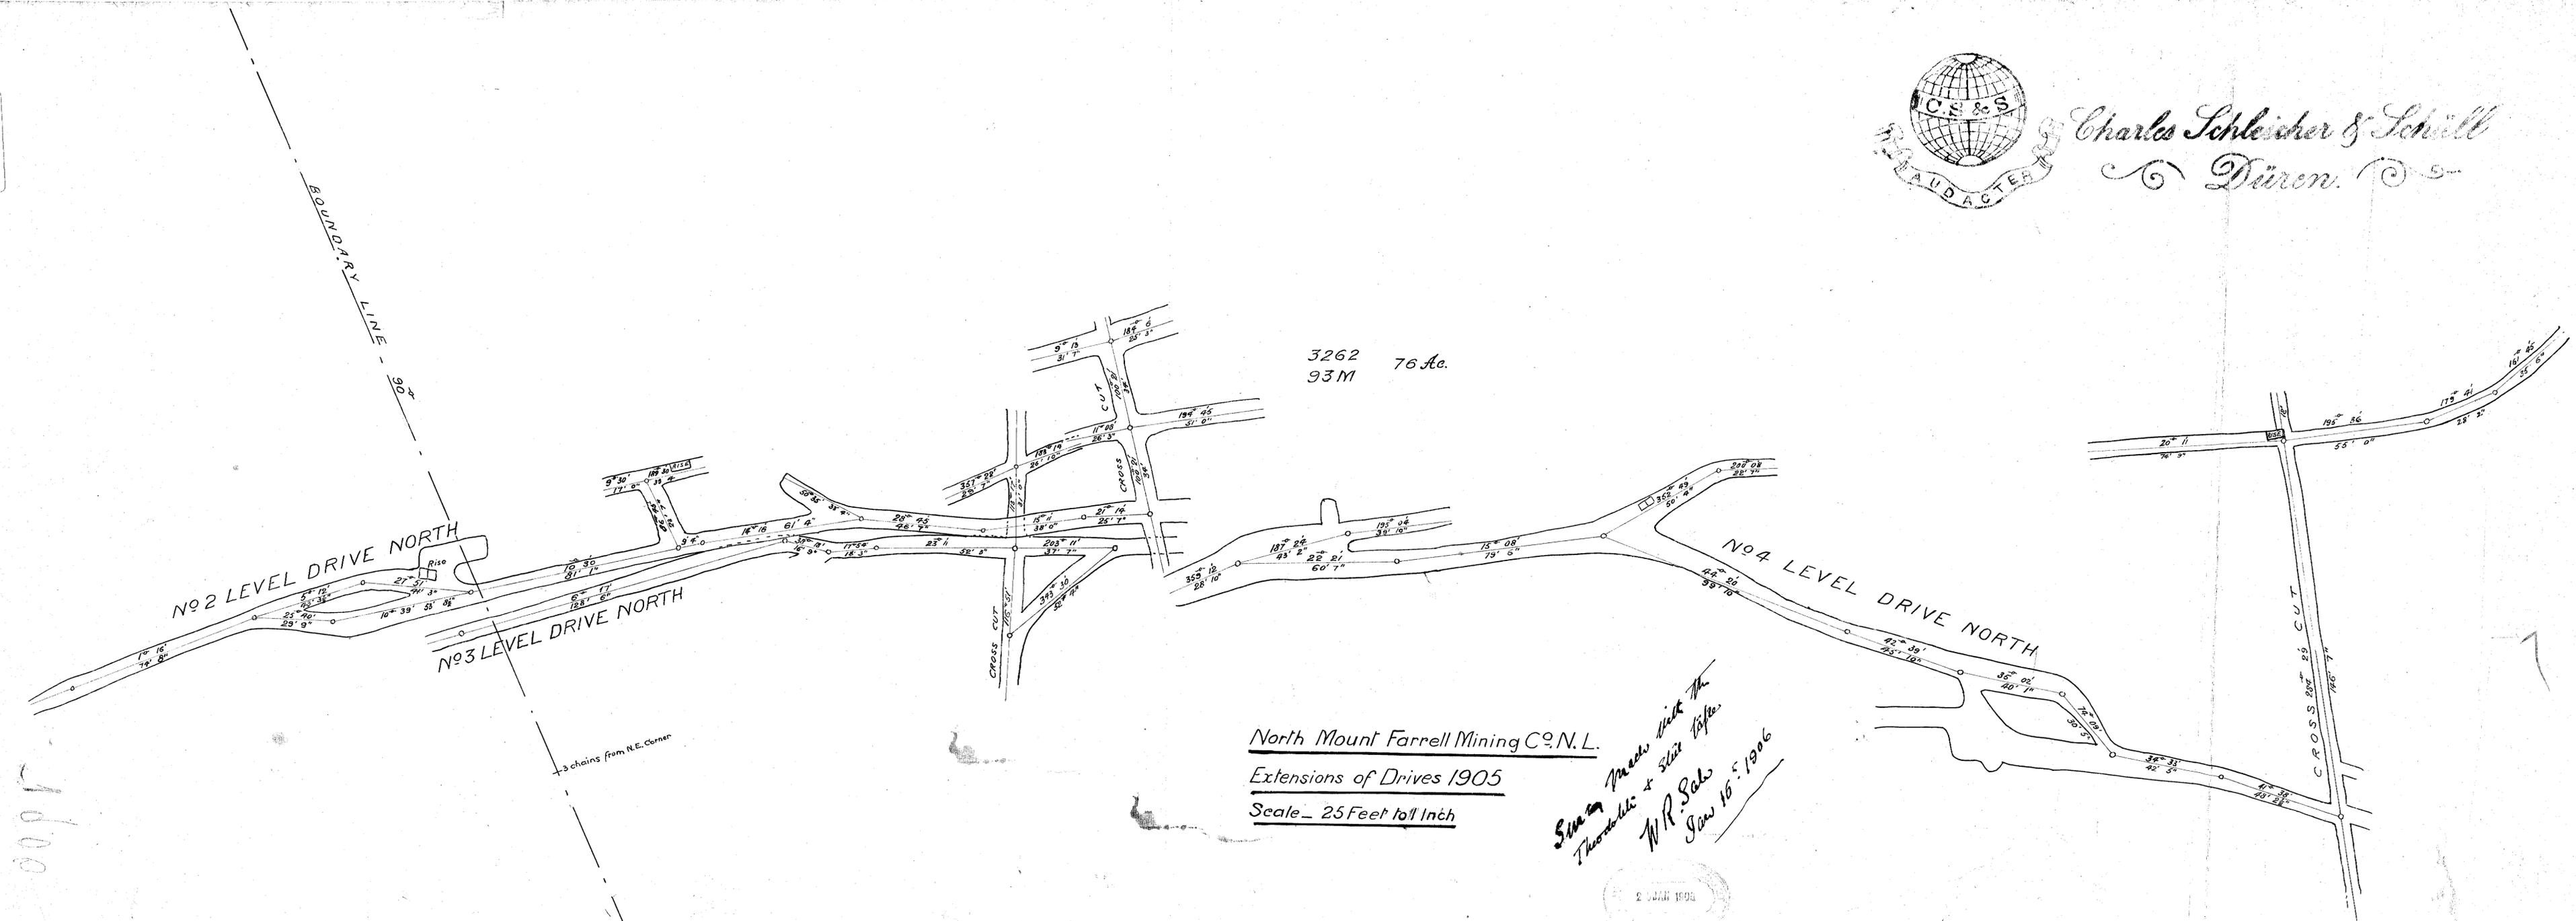

3262 76 Ac.
93M

North Mount Farrell Mining Co. N.L.
Extensions of Drives 1905
Scale - 25 Feet to 1 Inch

See on maps with the
Theoretical & Blue Tapes
W.R. Sals
Jan 15th 1906

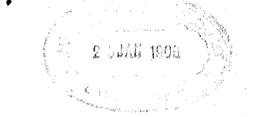

130