


59-33

59-33



SOUTH Boundary 4116
90°

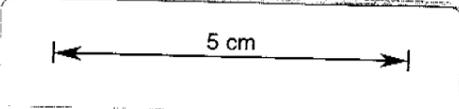


NORTH M^r FARRELL

N^o 2 LEVEL NORTH

Jan 1905

Scale 25' ft to one inch

W.R. Selk
Mining Manager

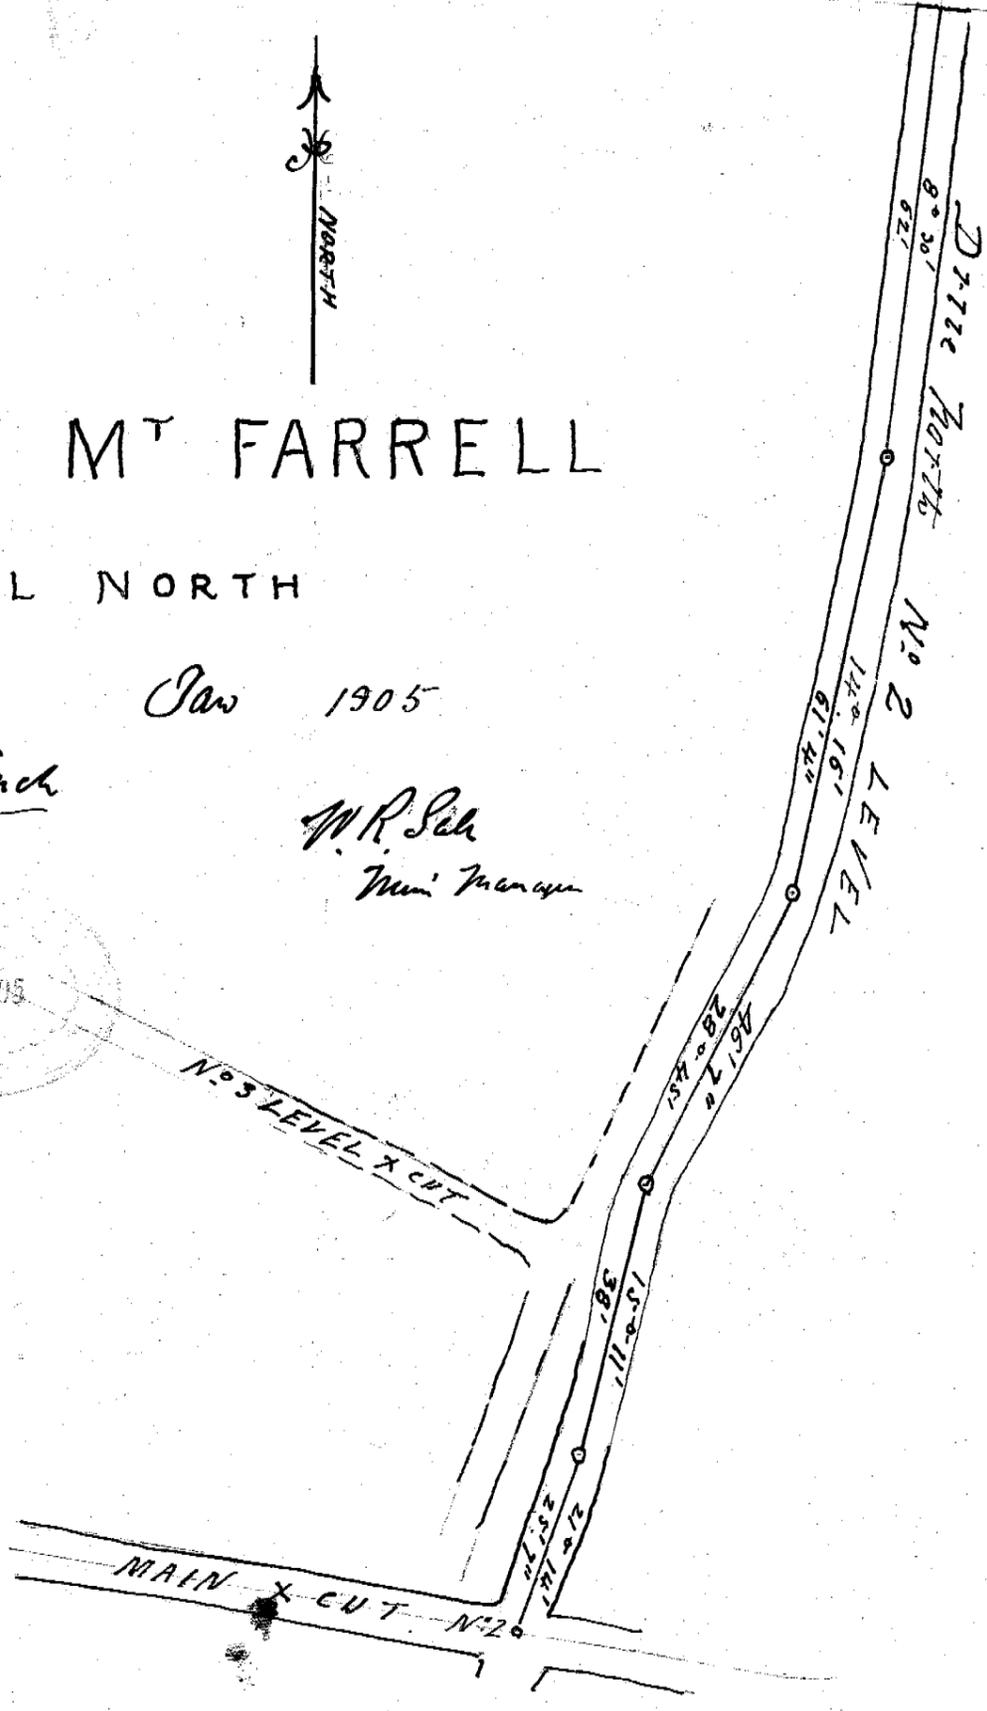

25' 7 1/2"