
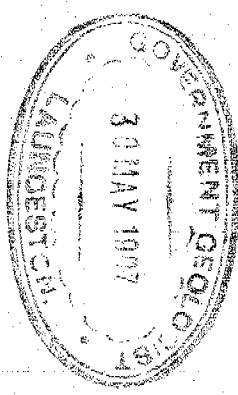


NORTH MOUNT FARRELL
S.M
SCALE ~~1~~ 25' TO 1 INCH

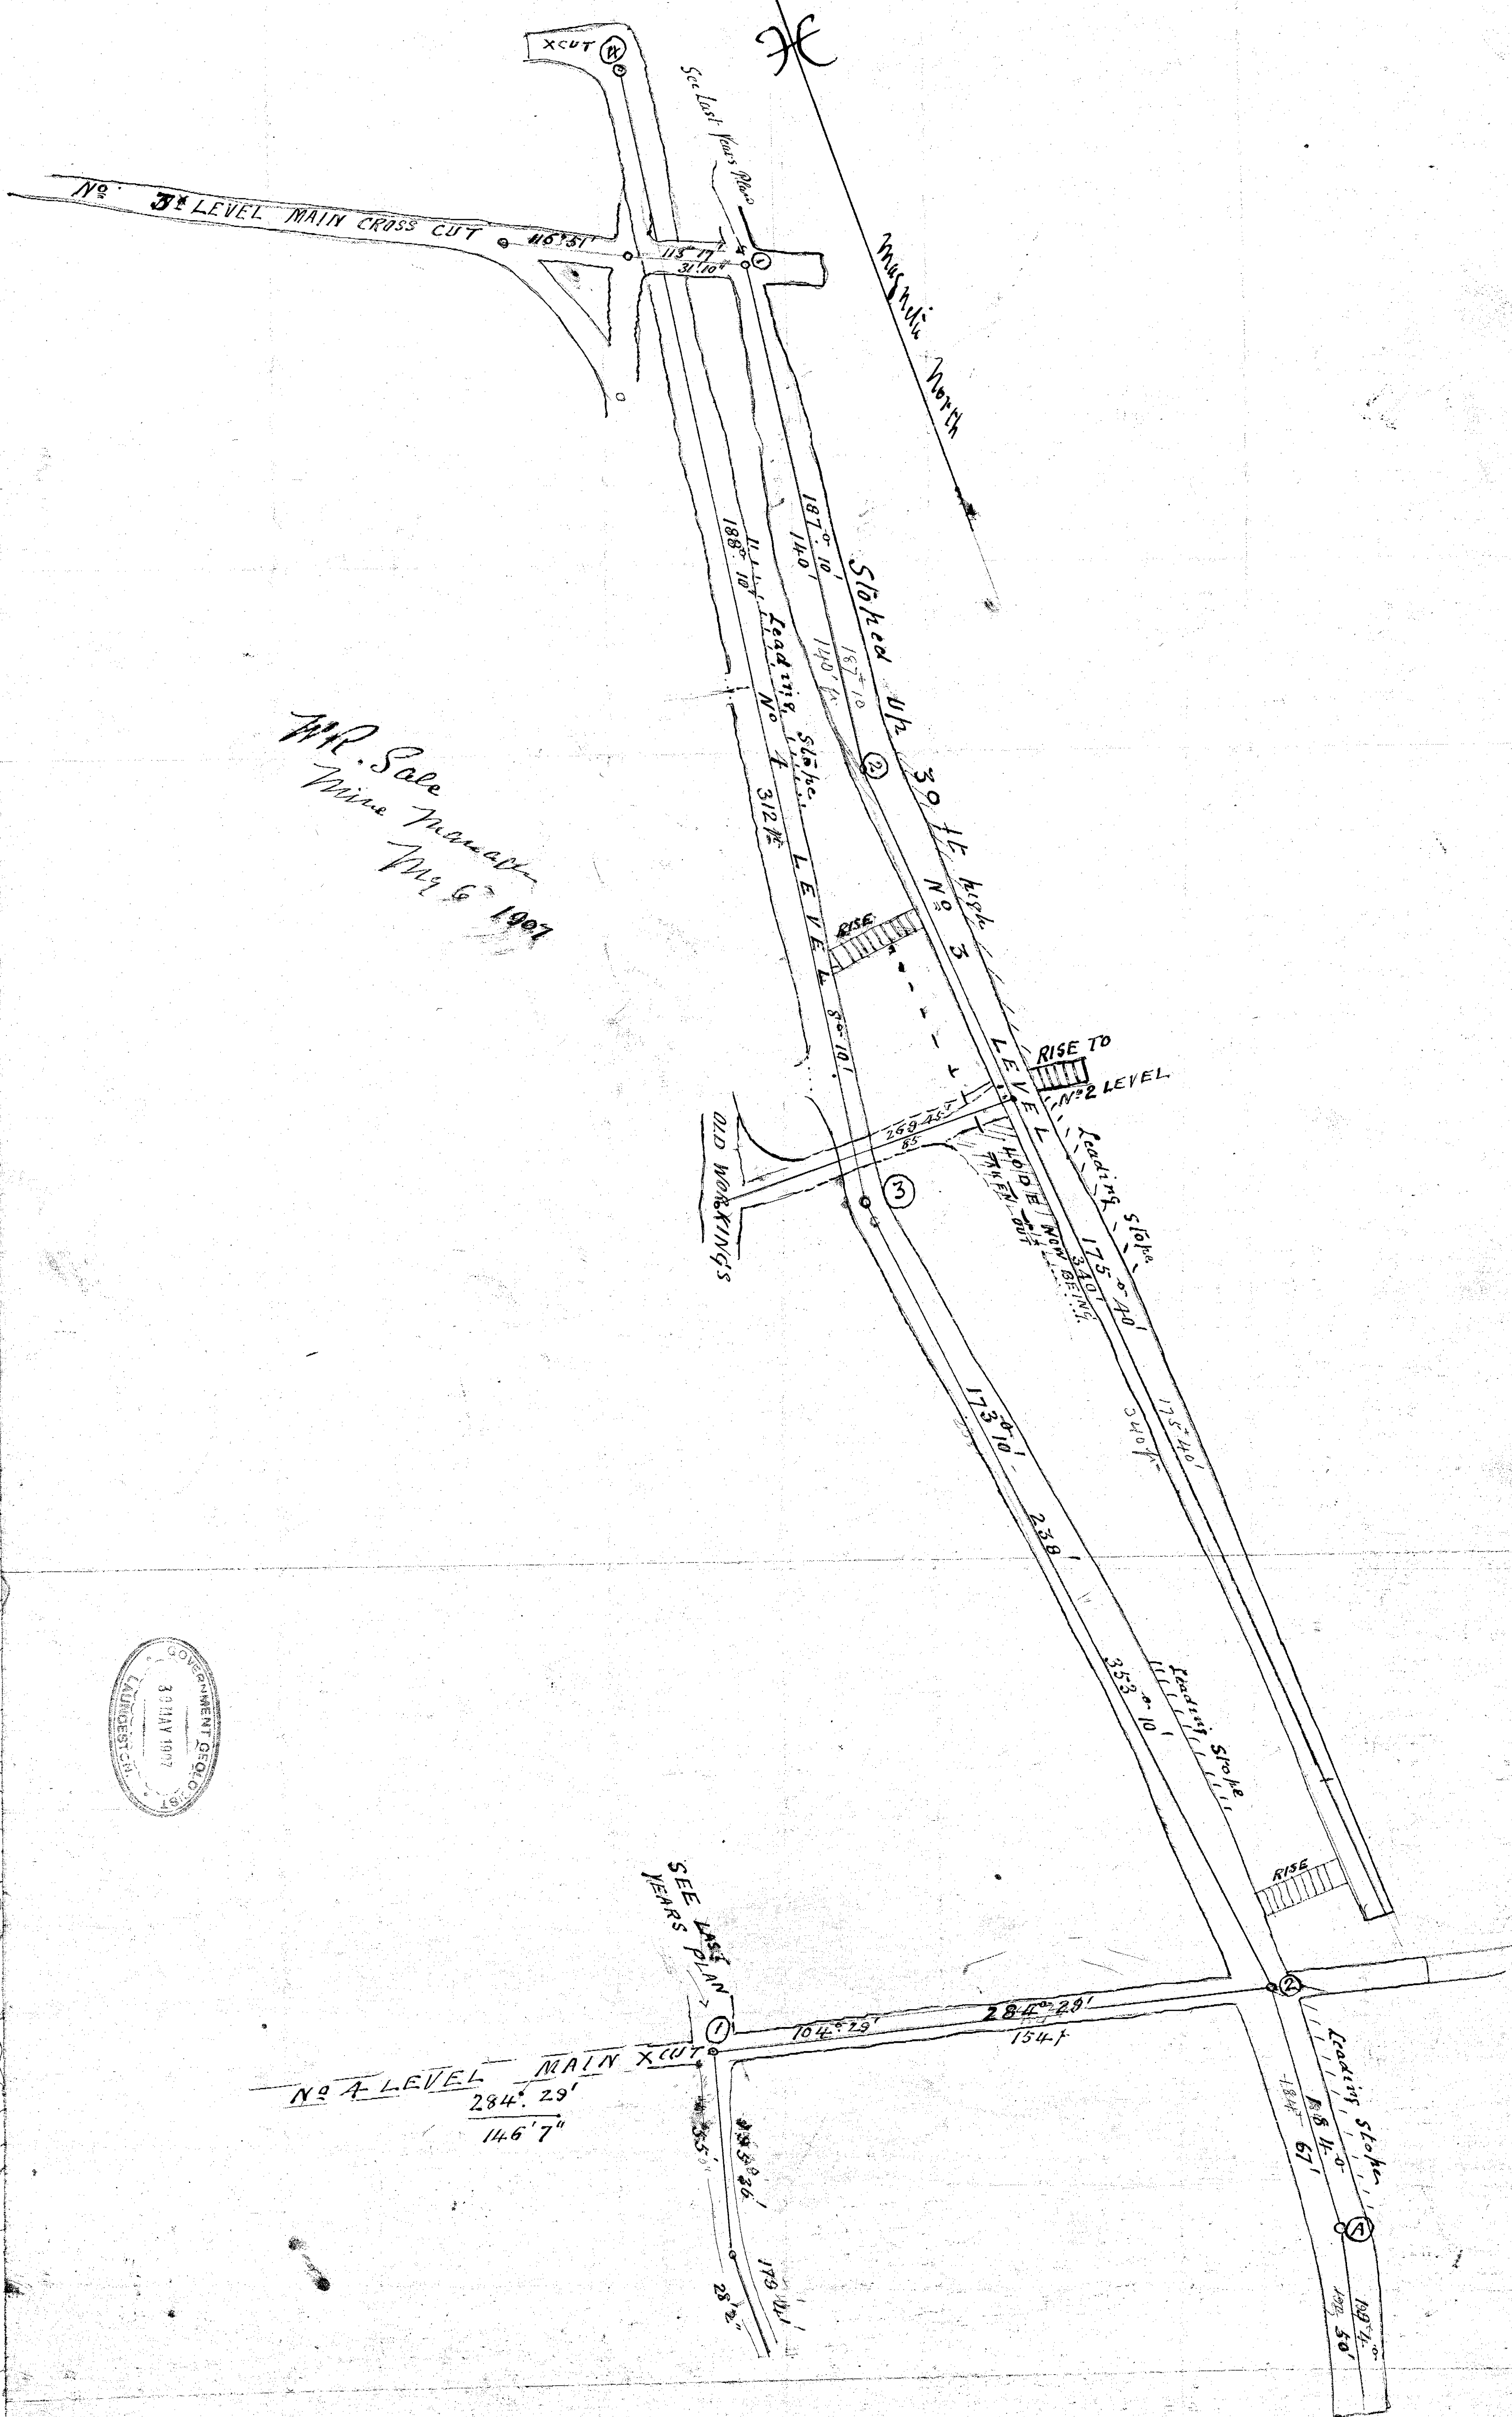

W. R. Sale
Mine Manager
May 6 1907