


NORTH M^r FARRELL MINE

LONGITUDINAL SECTION


Scale 25 feet to one Inch

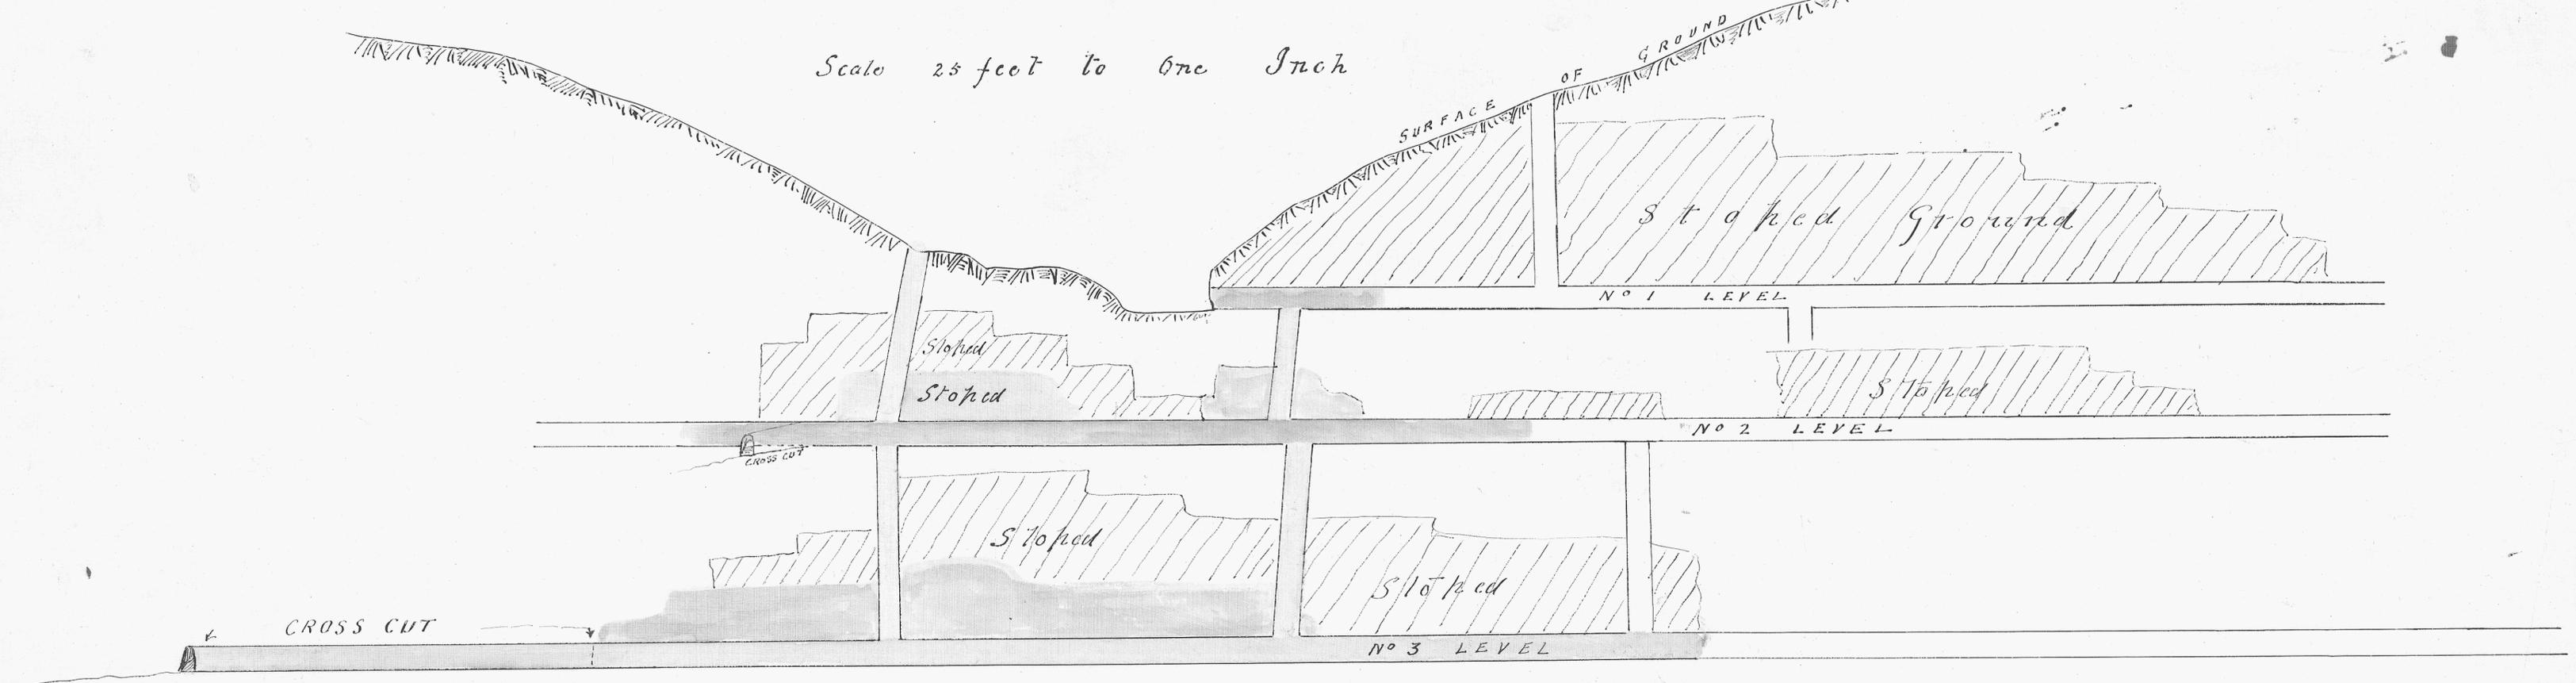


The coloured portion is copied from Mr Montgomerys Section of January 1901

The uncoloured parts is work done since

W.R. Sale June 2nd 1903

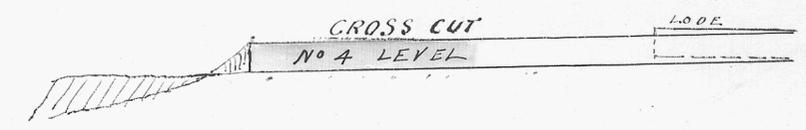

59-35

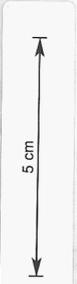

59-35