

59-36

93 M


76 Ac

Scale 25 feet to One Inch

W.R. Salo

Summary

June 2nd 1903

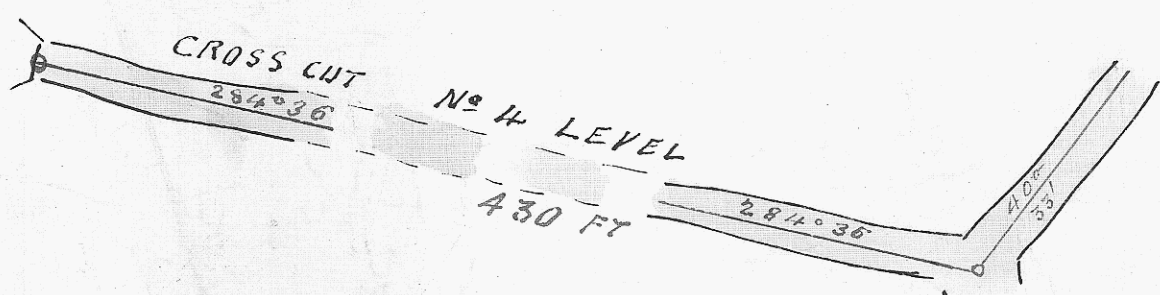

130