


59-37

59-38

59-38

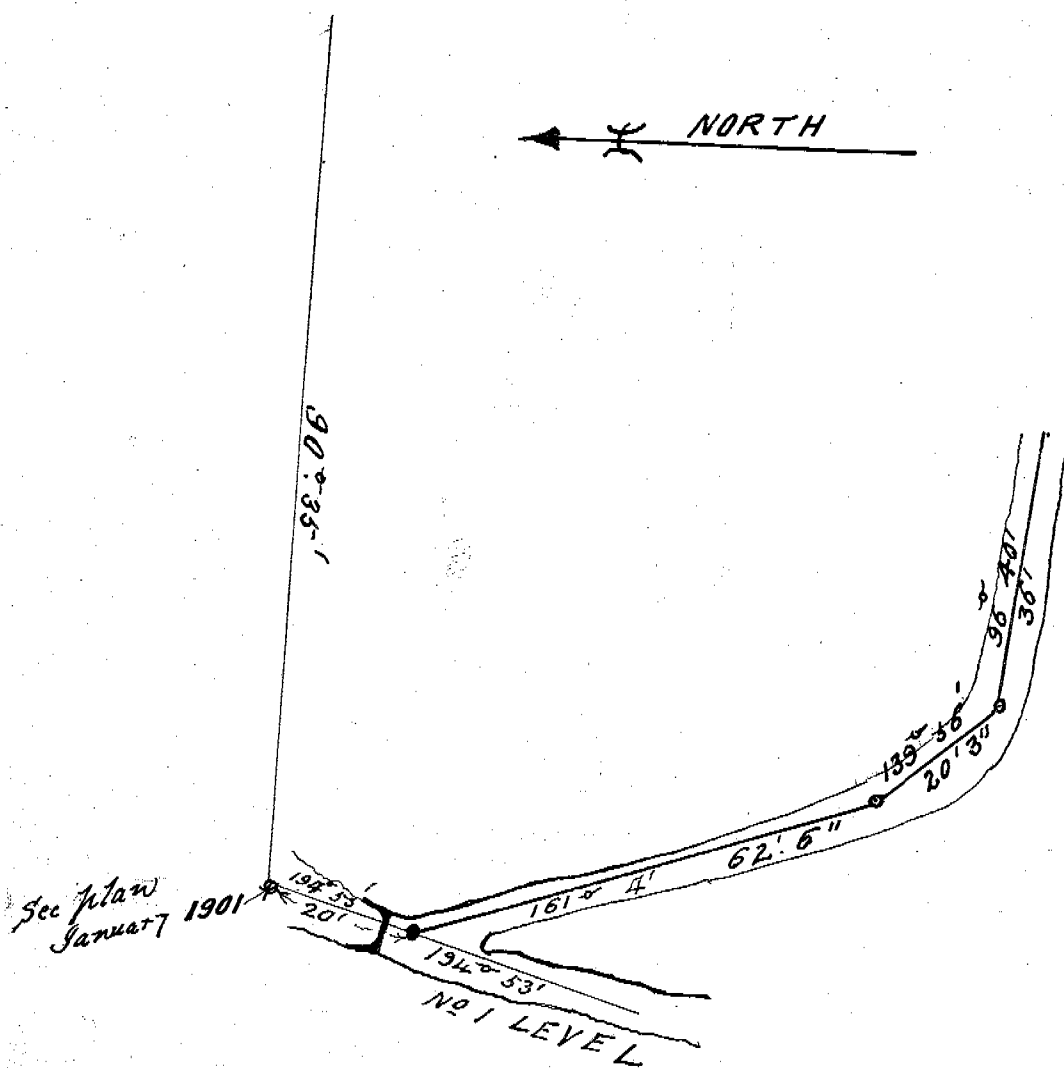

NORTH MOUNT FARRELL MINE

branch drive off Nº 1 LEVEL

Scale 25 ft. to one Inch

W.R. Selw

Surveyor

Jan 1904

