




193. Mount of ...
1001
N.B. Montgomery
with survey
Jan 19 1801

CROSS SECTION
Looking South

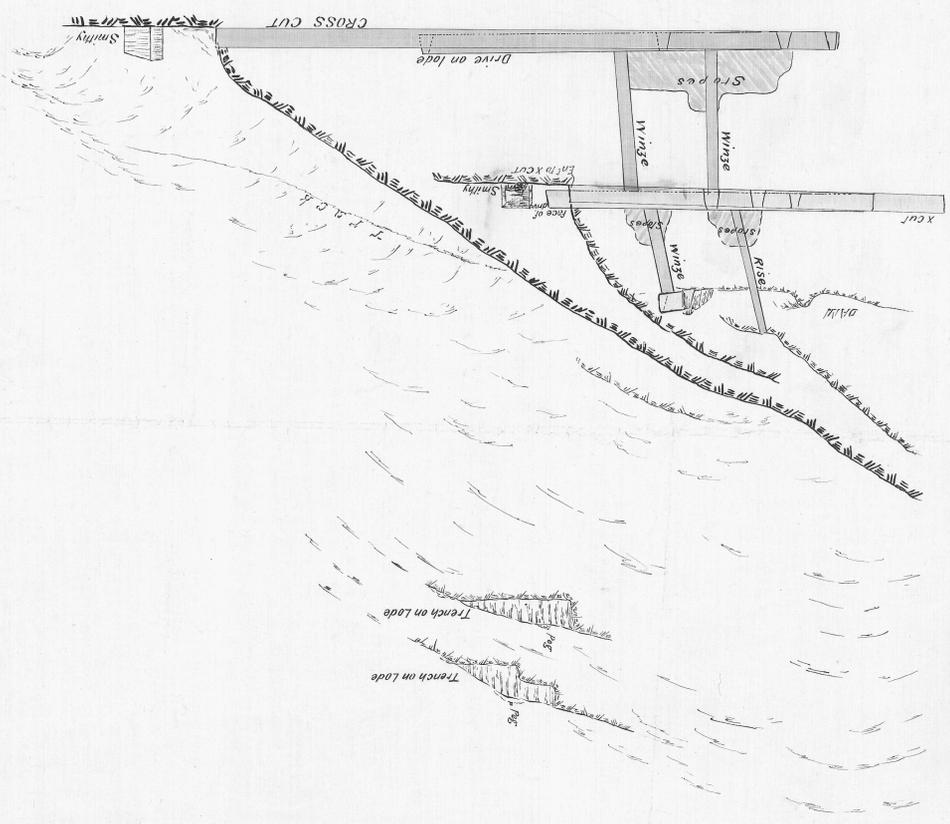


5m

59-39




LONGITUDINAL SECTION
Looking East

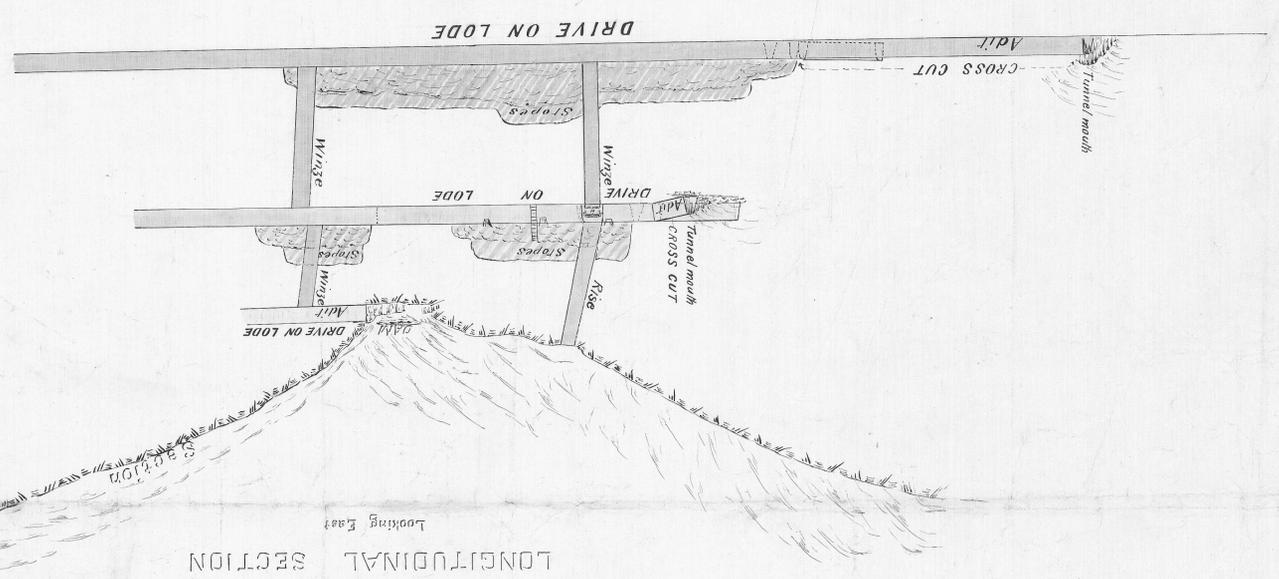

Boundary line

59-39

1001
1001
1001

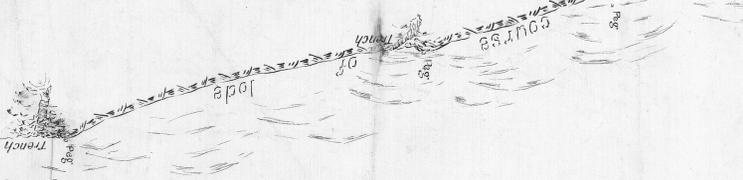

183