


59-41

MOUNT FARRELL MINING CO. N.L.

Plan shewing extensions of Underground Workings, for year ending, 31st December 1917.

Scale 40Ft. to an inch

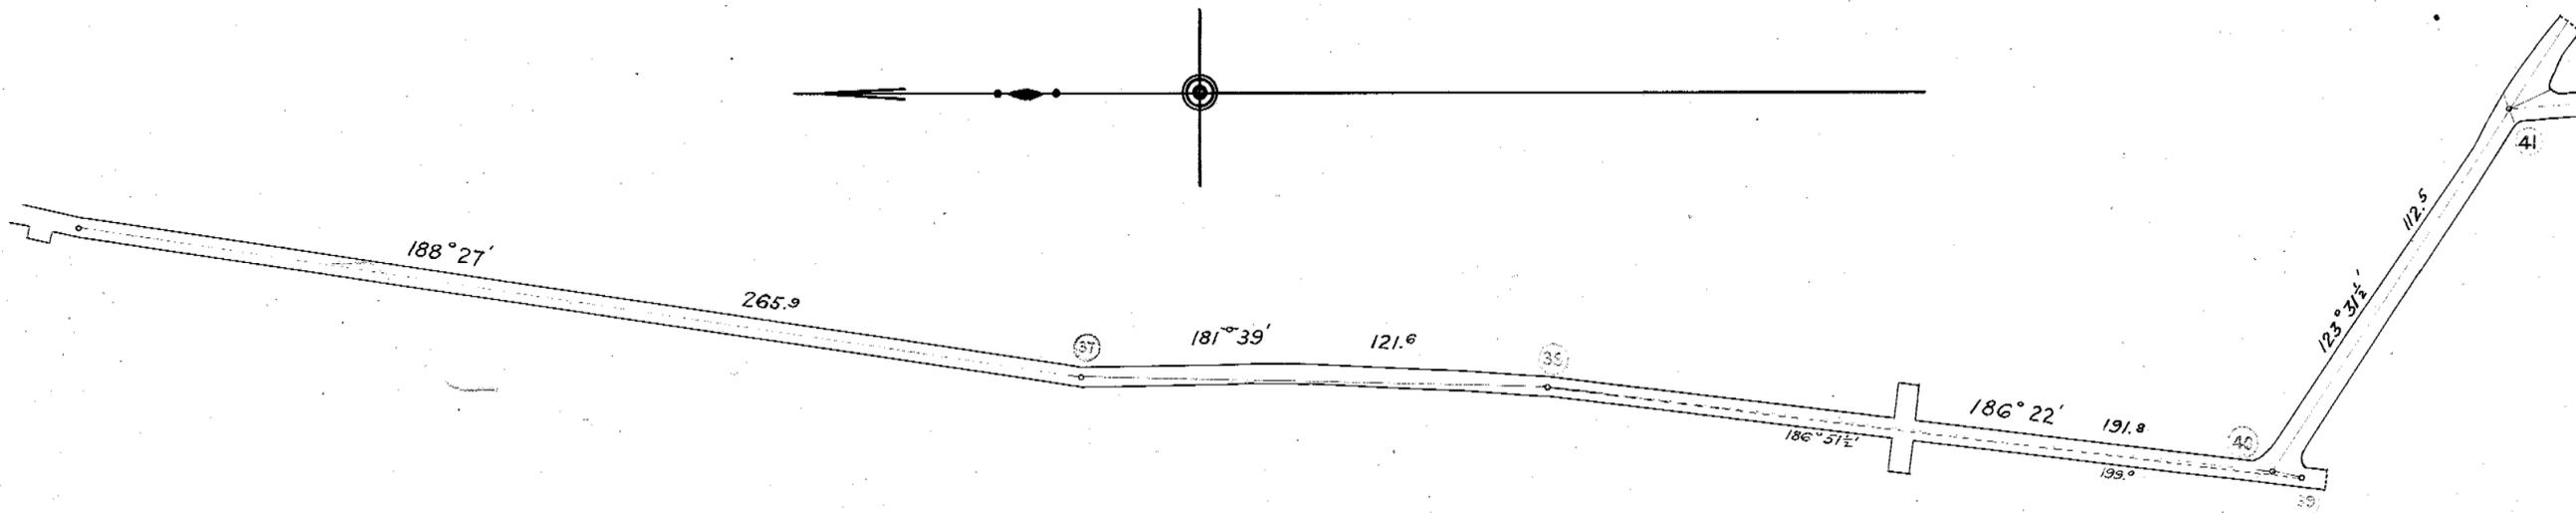

NORTH MOUNT FARRELL AND MOUNT FARRELL COMPANIES' JOINT DRIVE

MOUNT FARRELL M. CO. LOW LEVEL DRIVE

AT N^o 4 LEVEL NORTH M^r FARRELL MINE

L. H. Woodroffe
Mine Manager.