



59-43

NORTH MOUNT FARRELL MINING CO. N.L.

LONGITUDINAL SECTION OF SHAFT LEVELS


— Scale - 40 - Feet to an inch —

CROSS SECTION AT 13.25

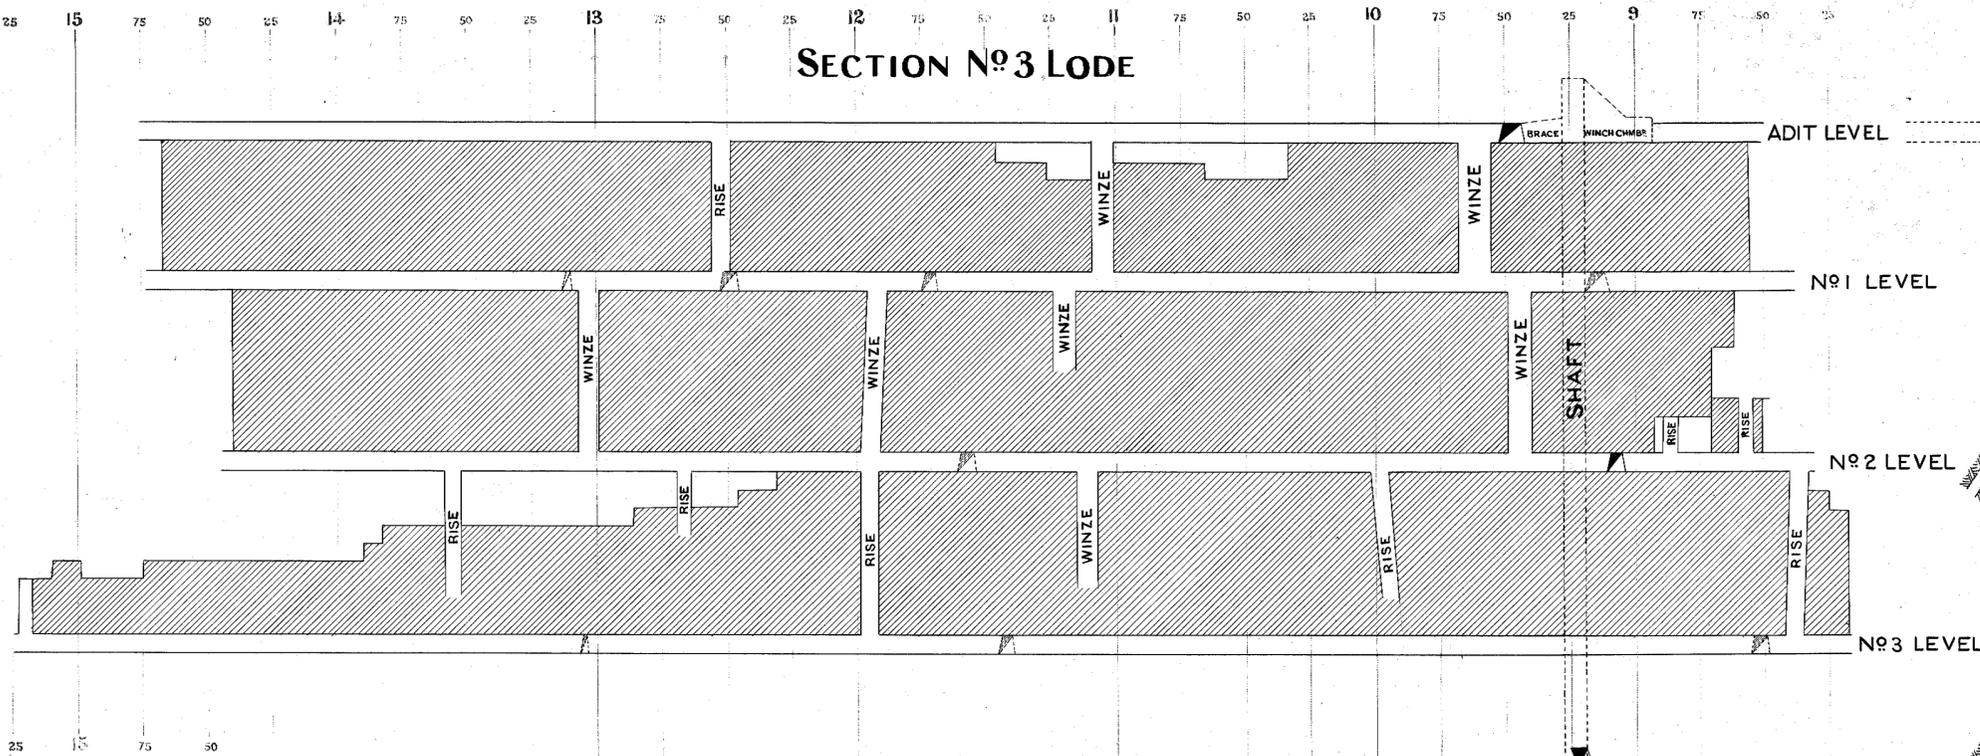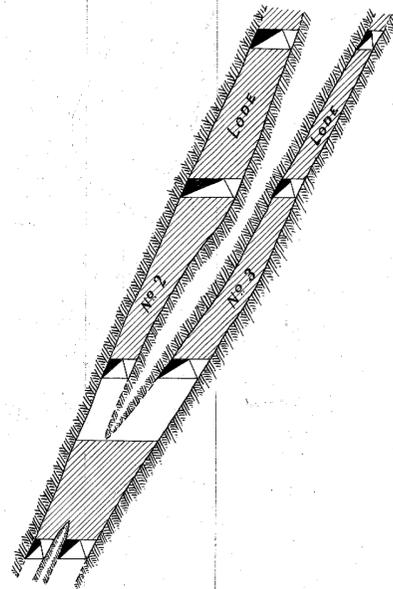


SECTION No 3 LODE



CROSS SECTION AT SHAFT

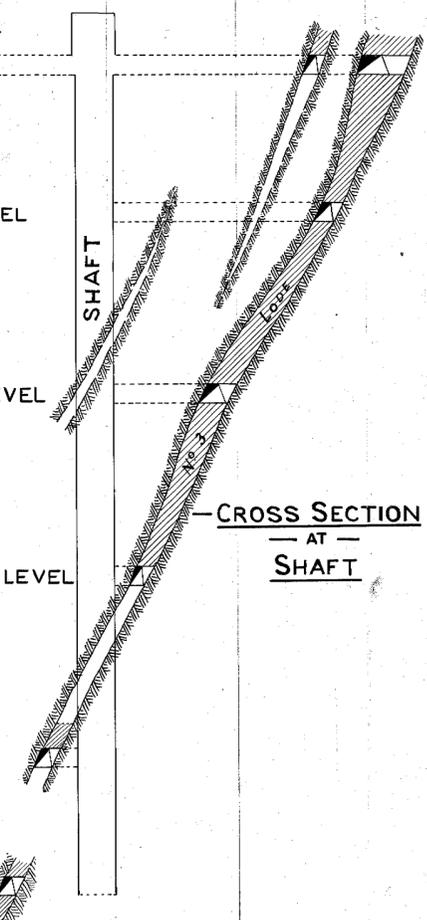


SECTION No 2 LODE

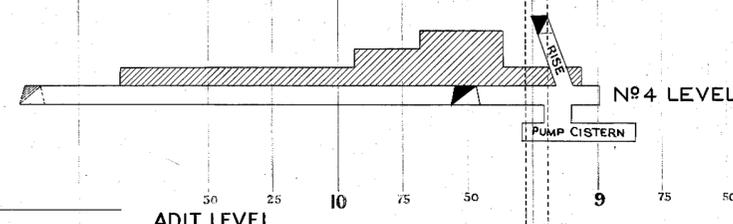

SECTION No 2^A LODE

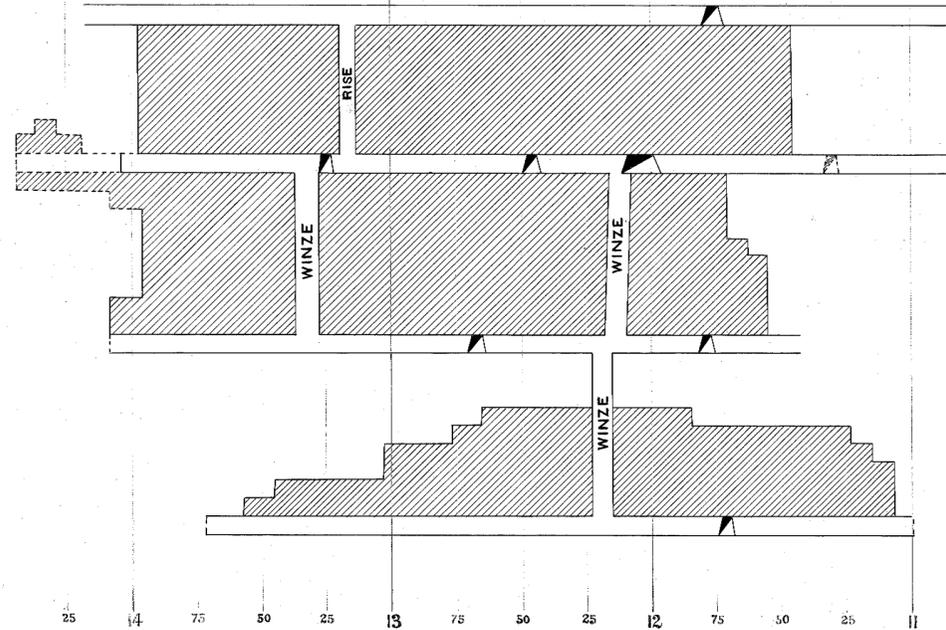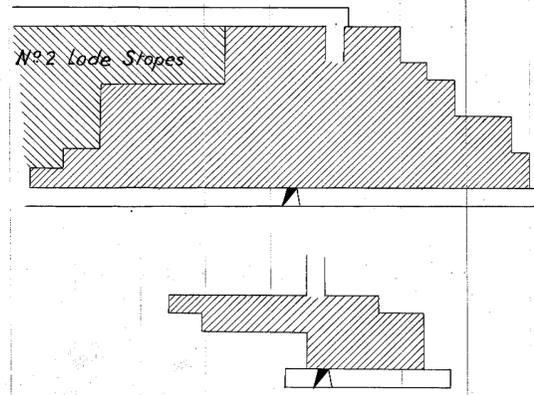

ADIT LEVEL
No 1 LEVEL
No 2 LEVEL
No 3 LEVEL

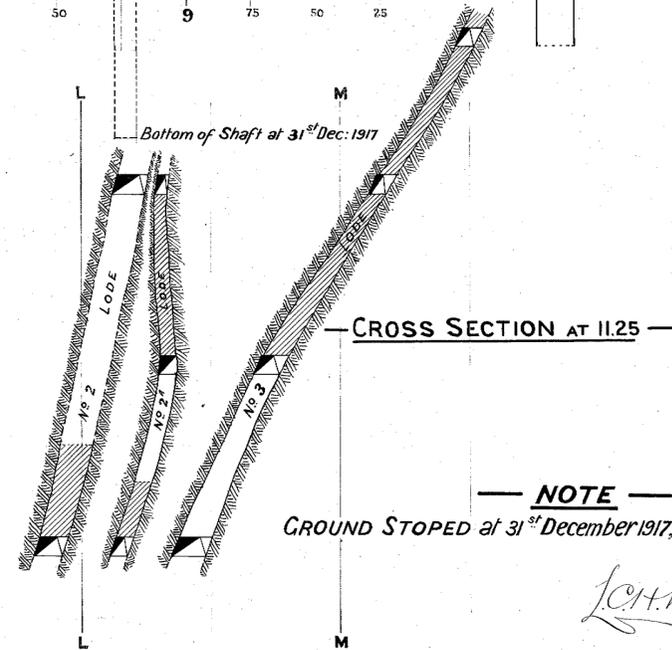

NOTE
GROUND STOPPED at 31st December 1917, SHEWN THUS

L. H. Woodroffe
Mining Manager

5 CM