

SCALE - 40 FEET TO 1 INCH

Low Level Drive R.L. 700.00 ft


SECTION

NORTH MOUNT FARRELL MINING CO., N.L.

MOUNT FARRELL MINING CO., N.L.

M.L. No. 3818 M

M.L. No. 5316 M

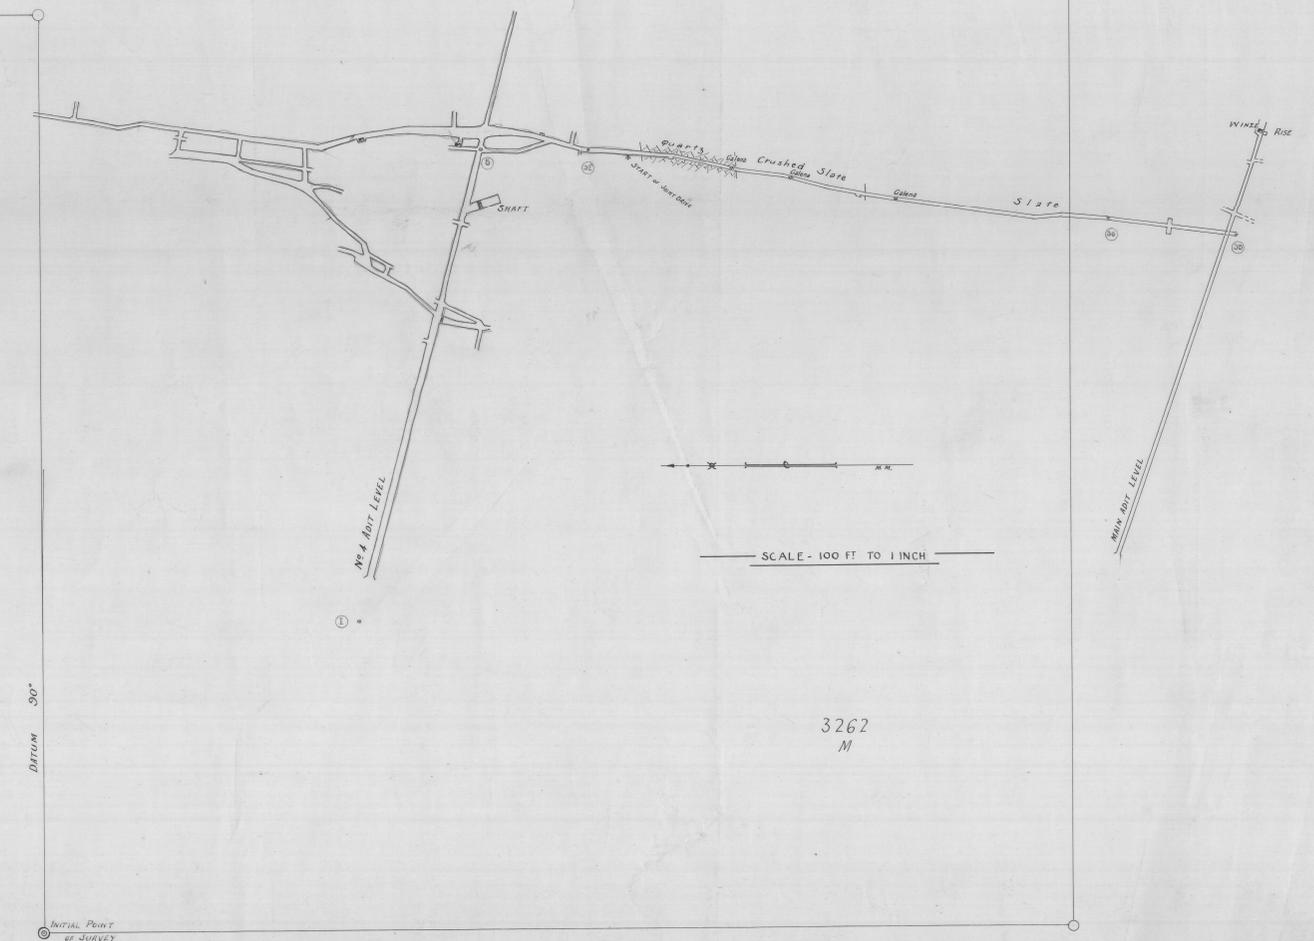

L. C. Woodroffe B.C.E.
 MINE MANAGER
 70-5-17



5944

Asst
 M. Farrell

13