

NORTH M^r FARRELL M^{nc} C^{oy}

PLAN OF MINE WORKINGS



SCALE

Twenty five feet to an inch





3262 W. Lines 93M
76Ac
799 North Mt. Farrell

4116 W. Lines 93M 68Ac

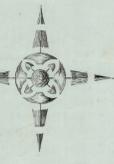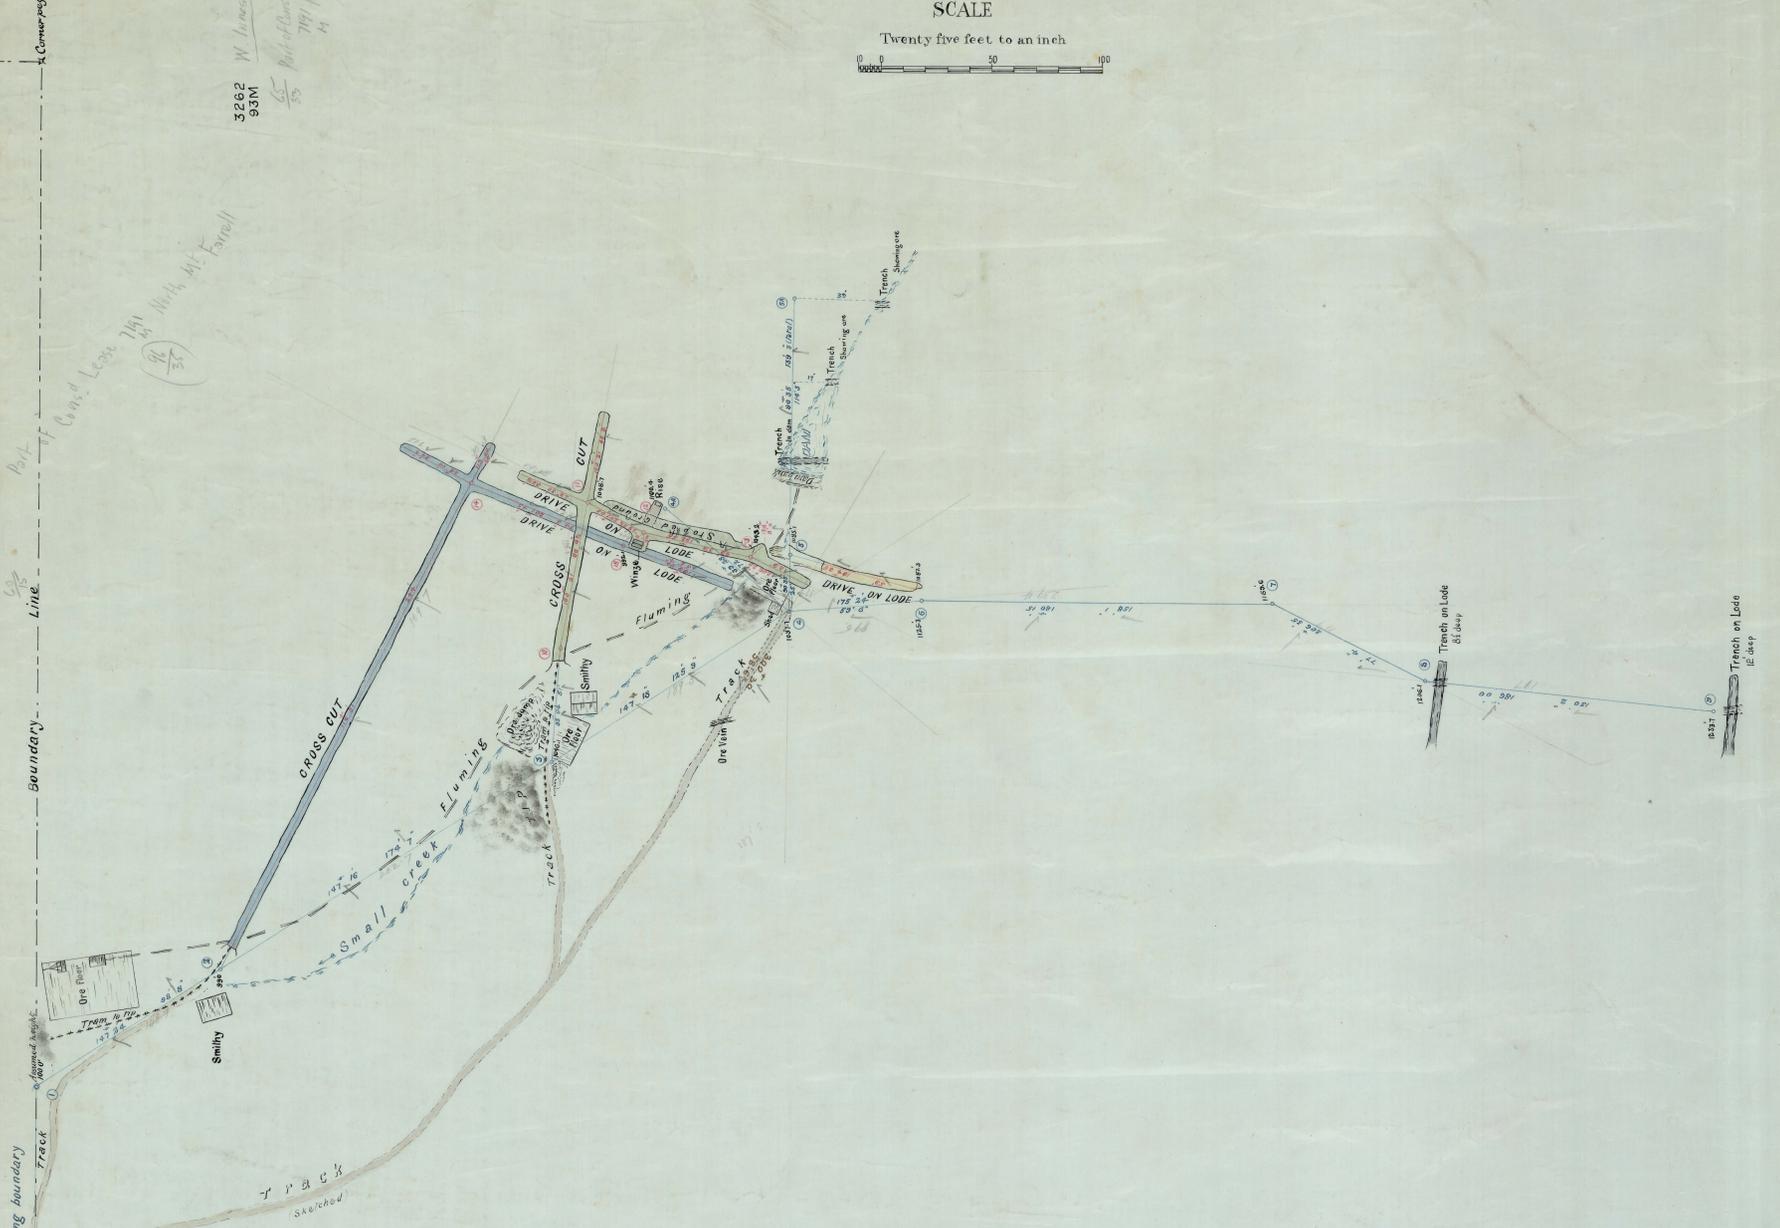

LONGITUDINAL SECTION

Looking East

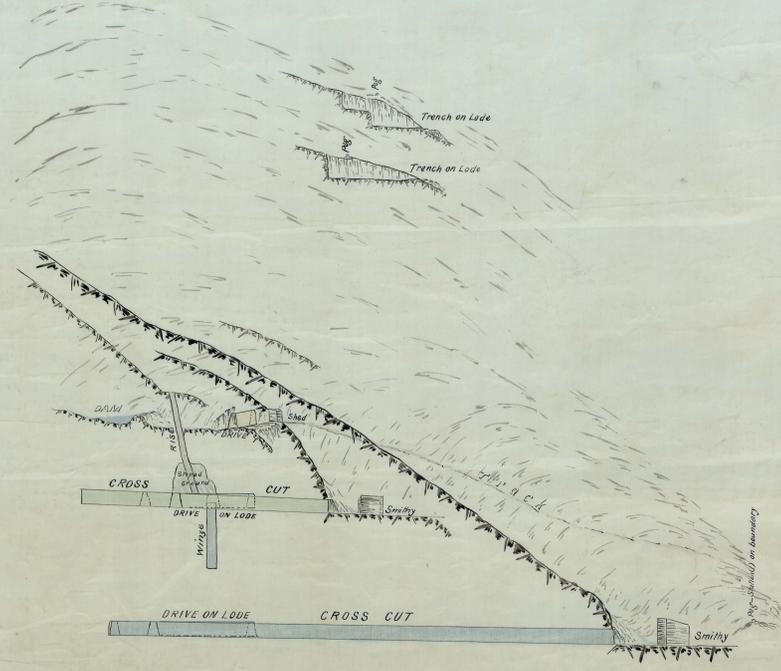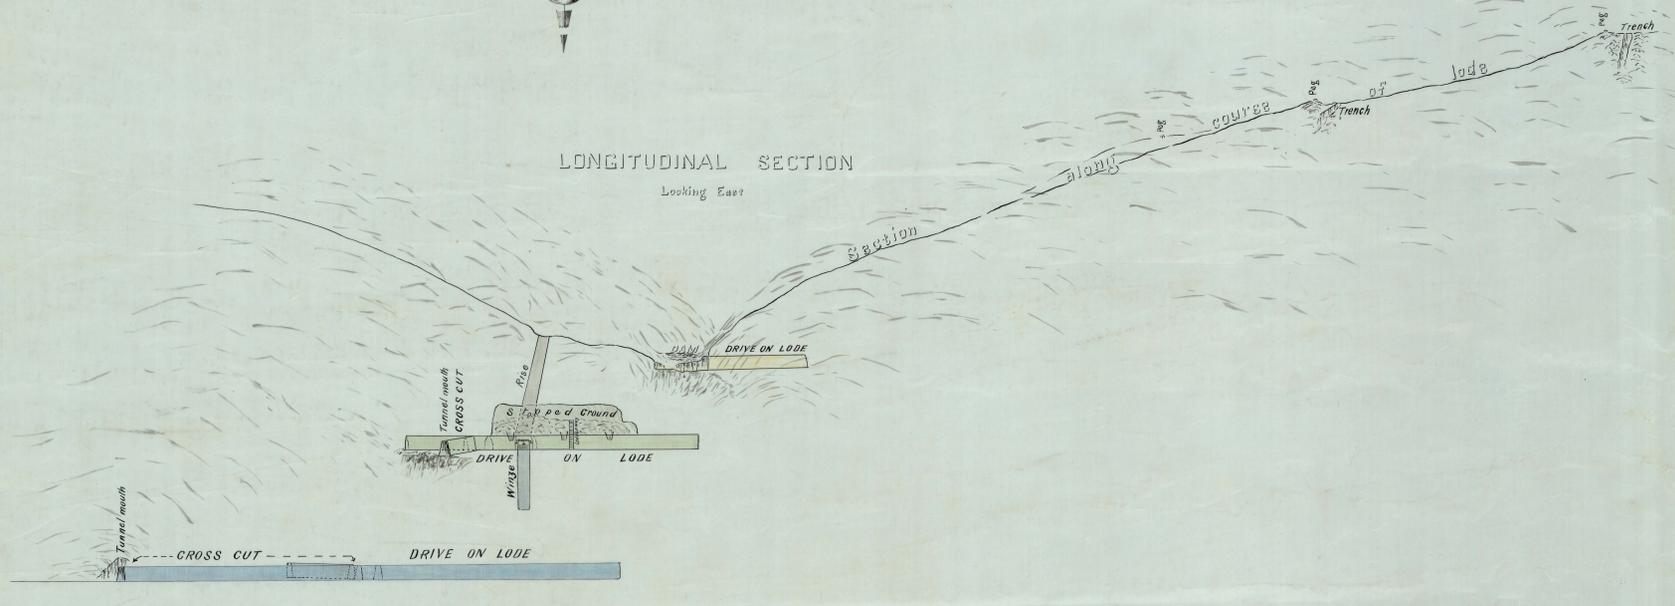

CROSS SECTION

Looking South

Robt. MacFarlane
Adm. Surveyor
1st June 1900

