




# NORTH MOUNT FARRELL MINING CO. N.L.

## SECTIONS OF SHAFT LEVELS


— SCALE 40 FEET TO AN INCH —

59-49

59-49.

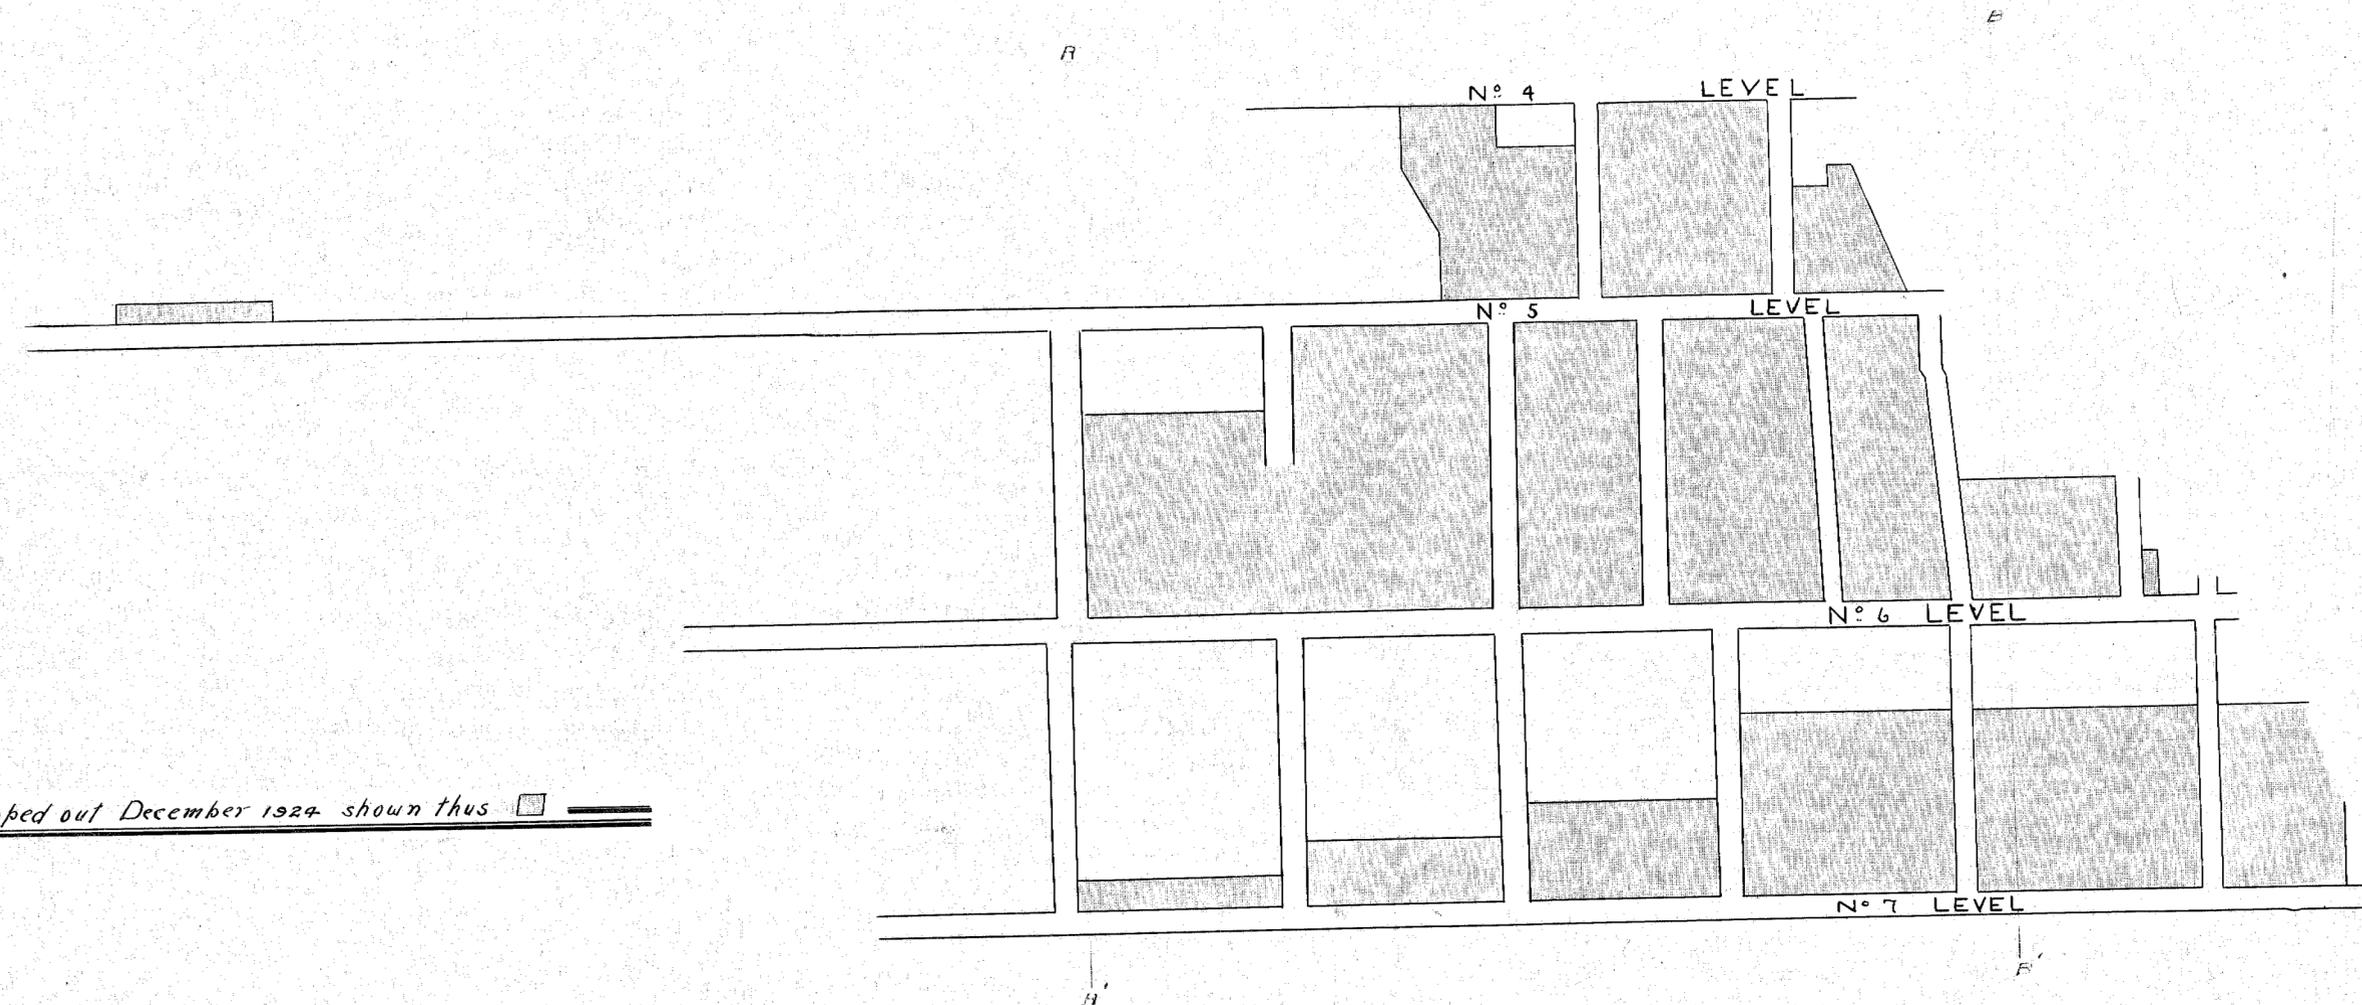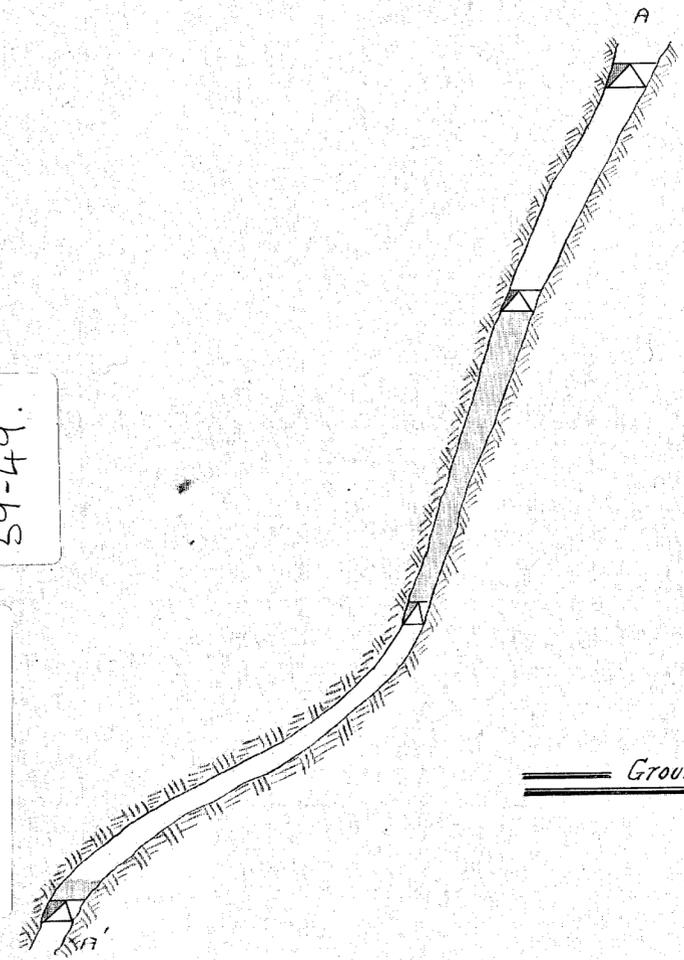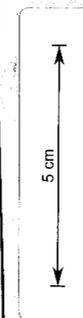

==== *Ground stoped out December 1924 shown thus* [shaded square] =====

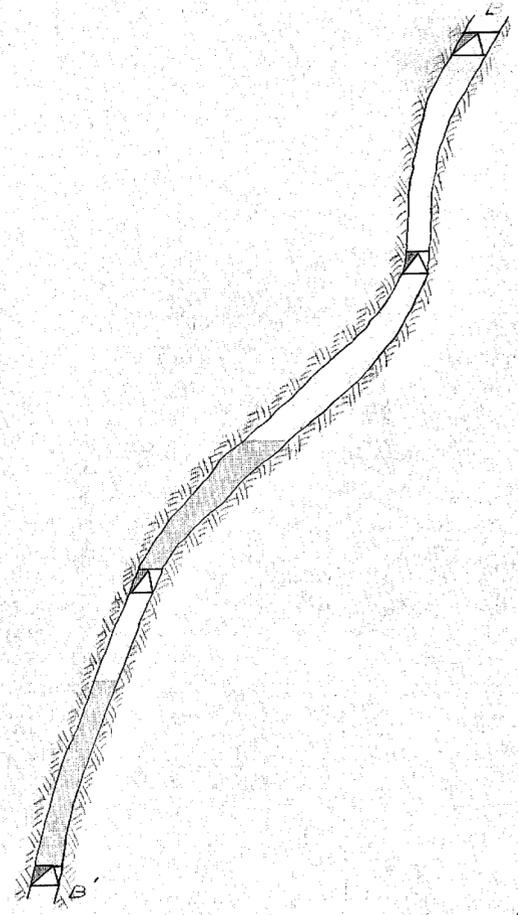

*Robert Ross*  
1/17/25