


59-50

NORTH MT FARRELL
MINE

LONGITUDINAL SECTION

Scale 40 ft = 1 inch

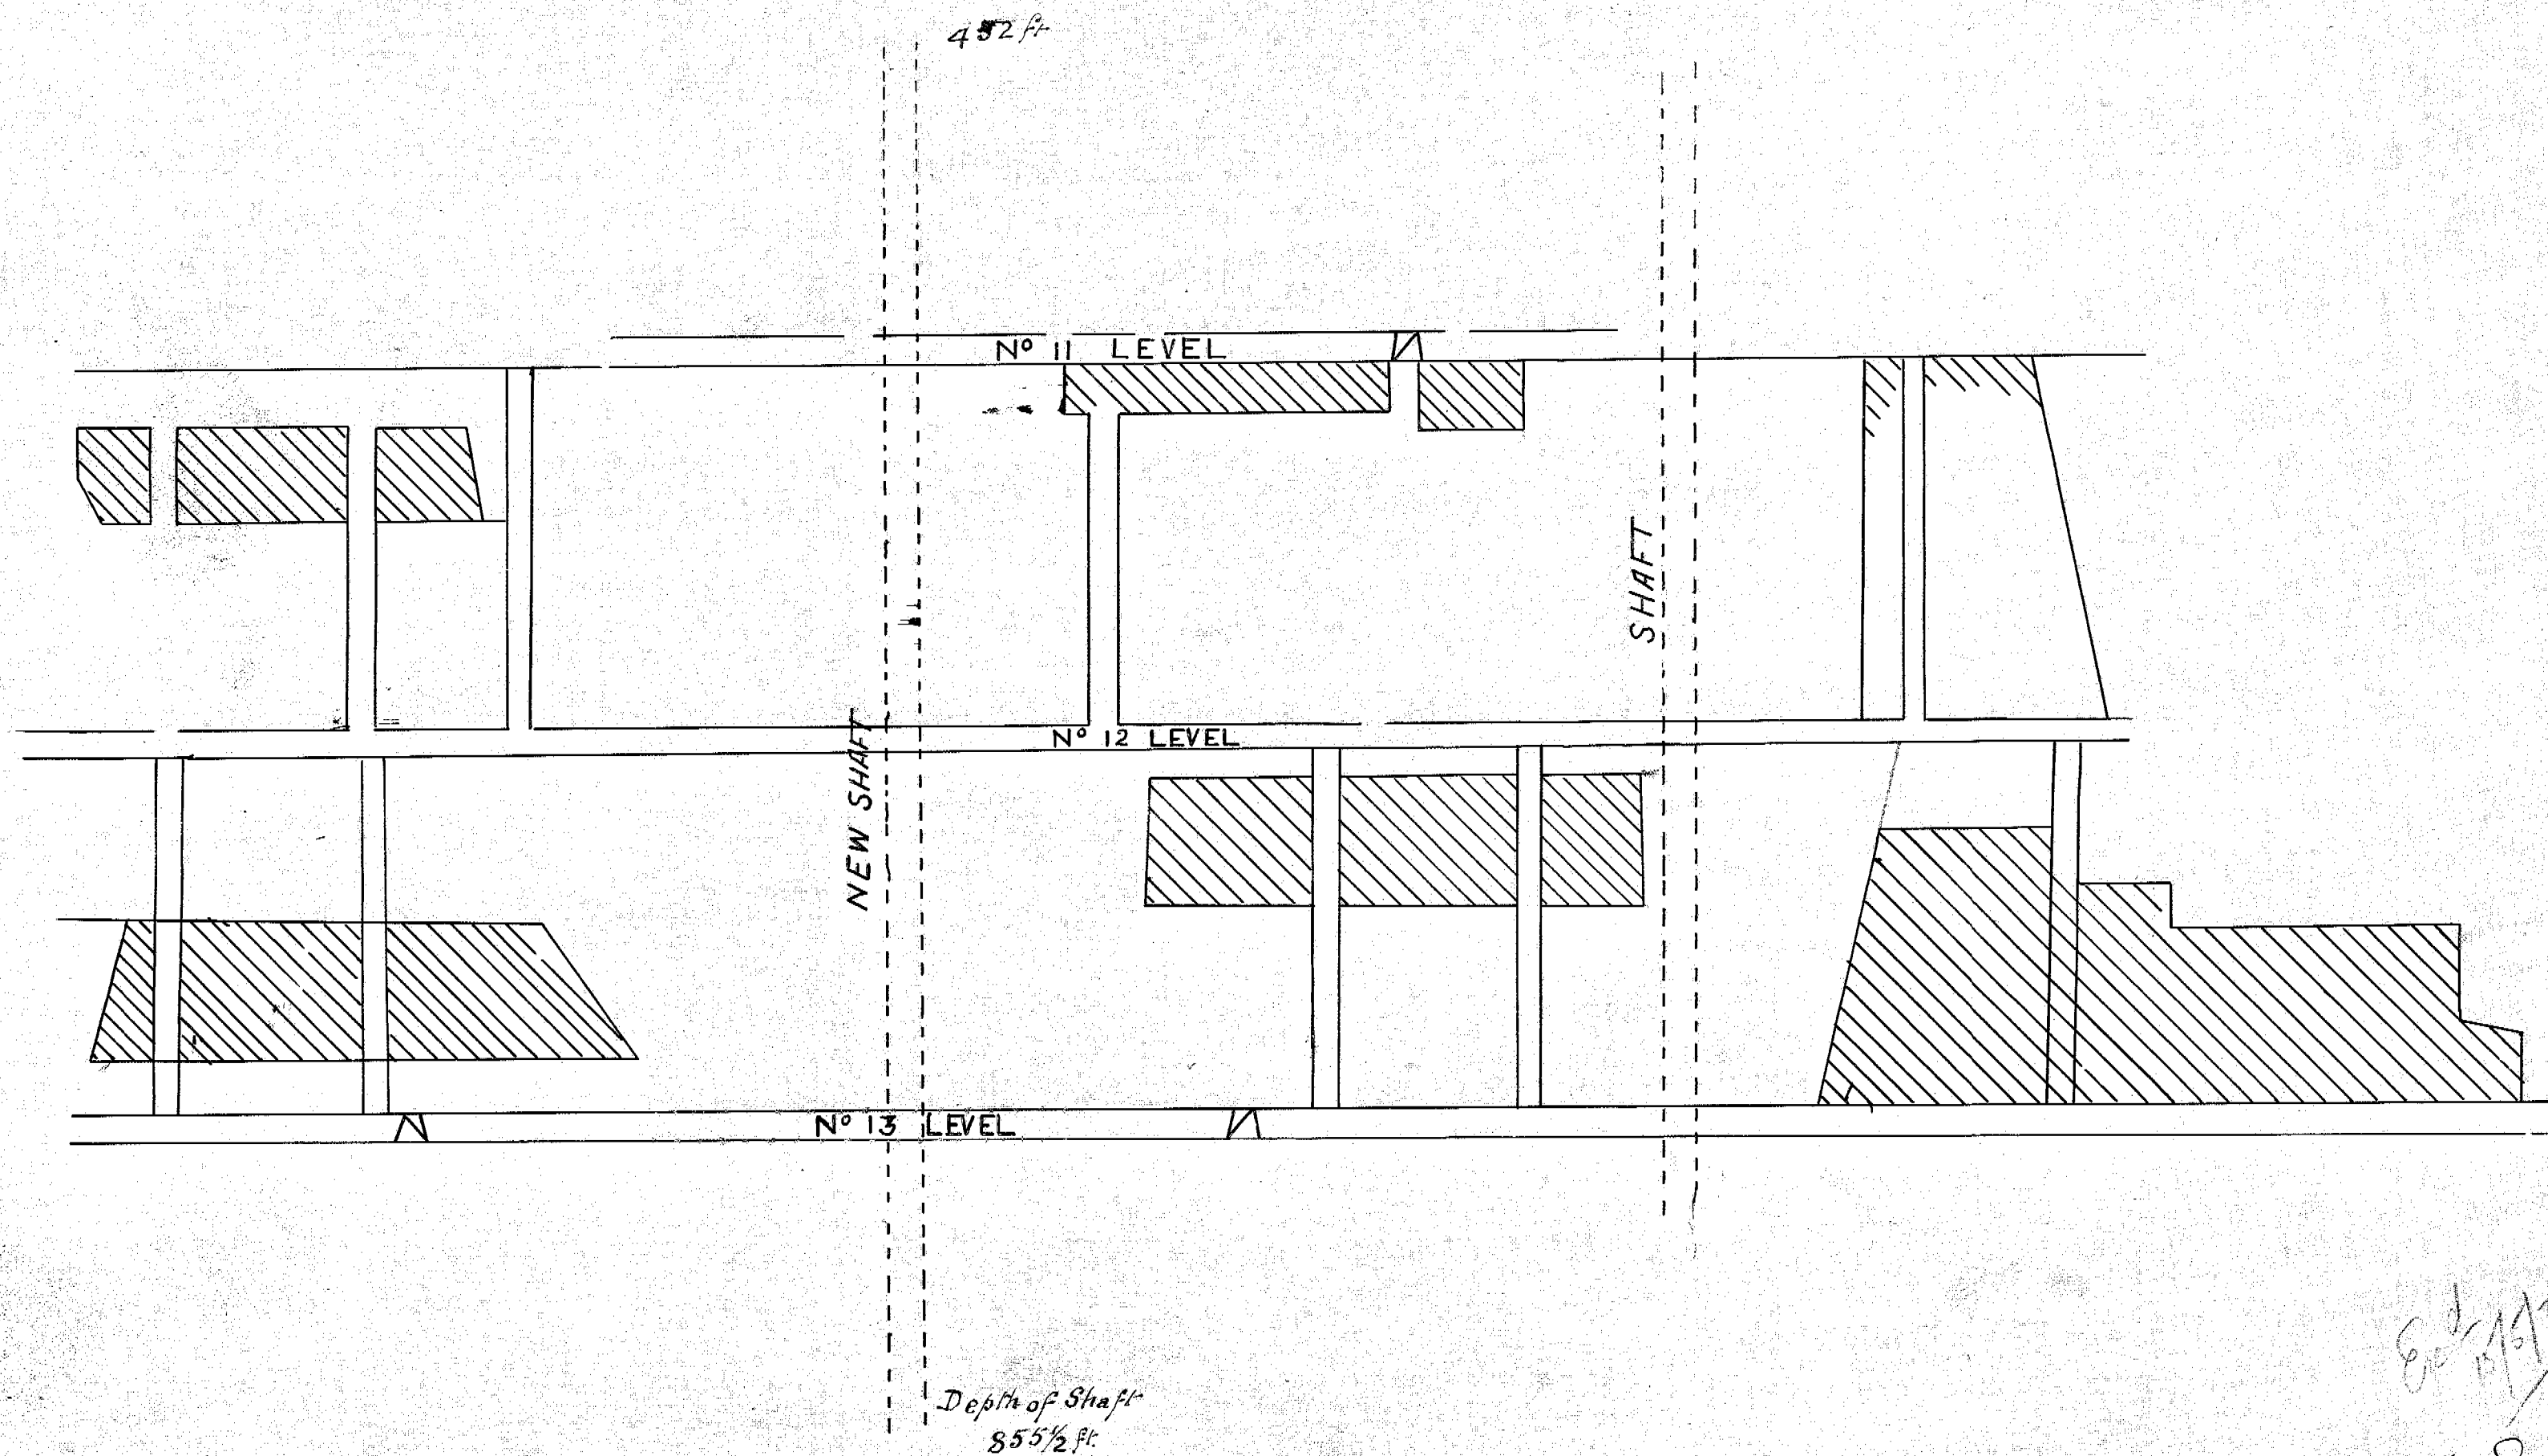

5 cm

Ed
10/15/31
H. J. Dore
May 1931