



NORTH MOUNT FARRELL C^o

LONGITUDINAL SECTION


Scale 40 ft = 1 inch

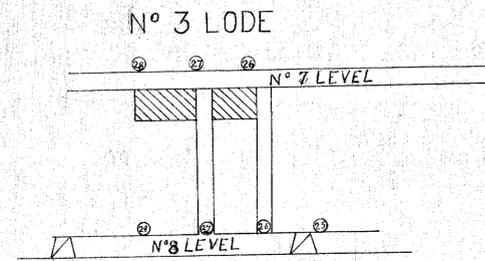

N° 2 LODE

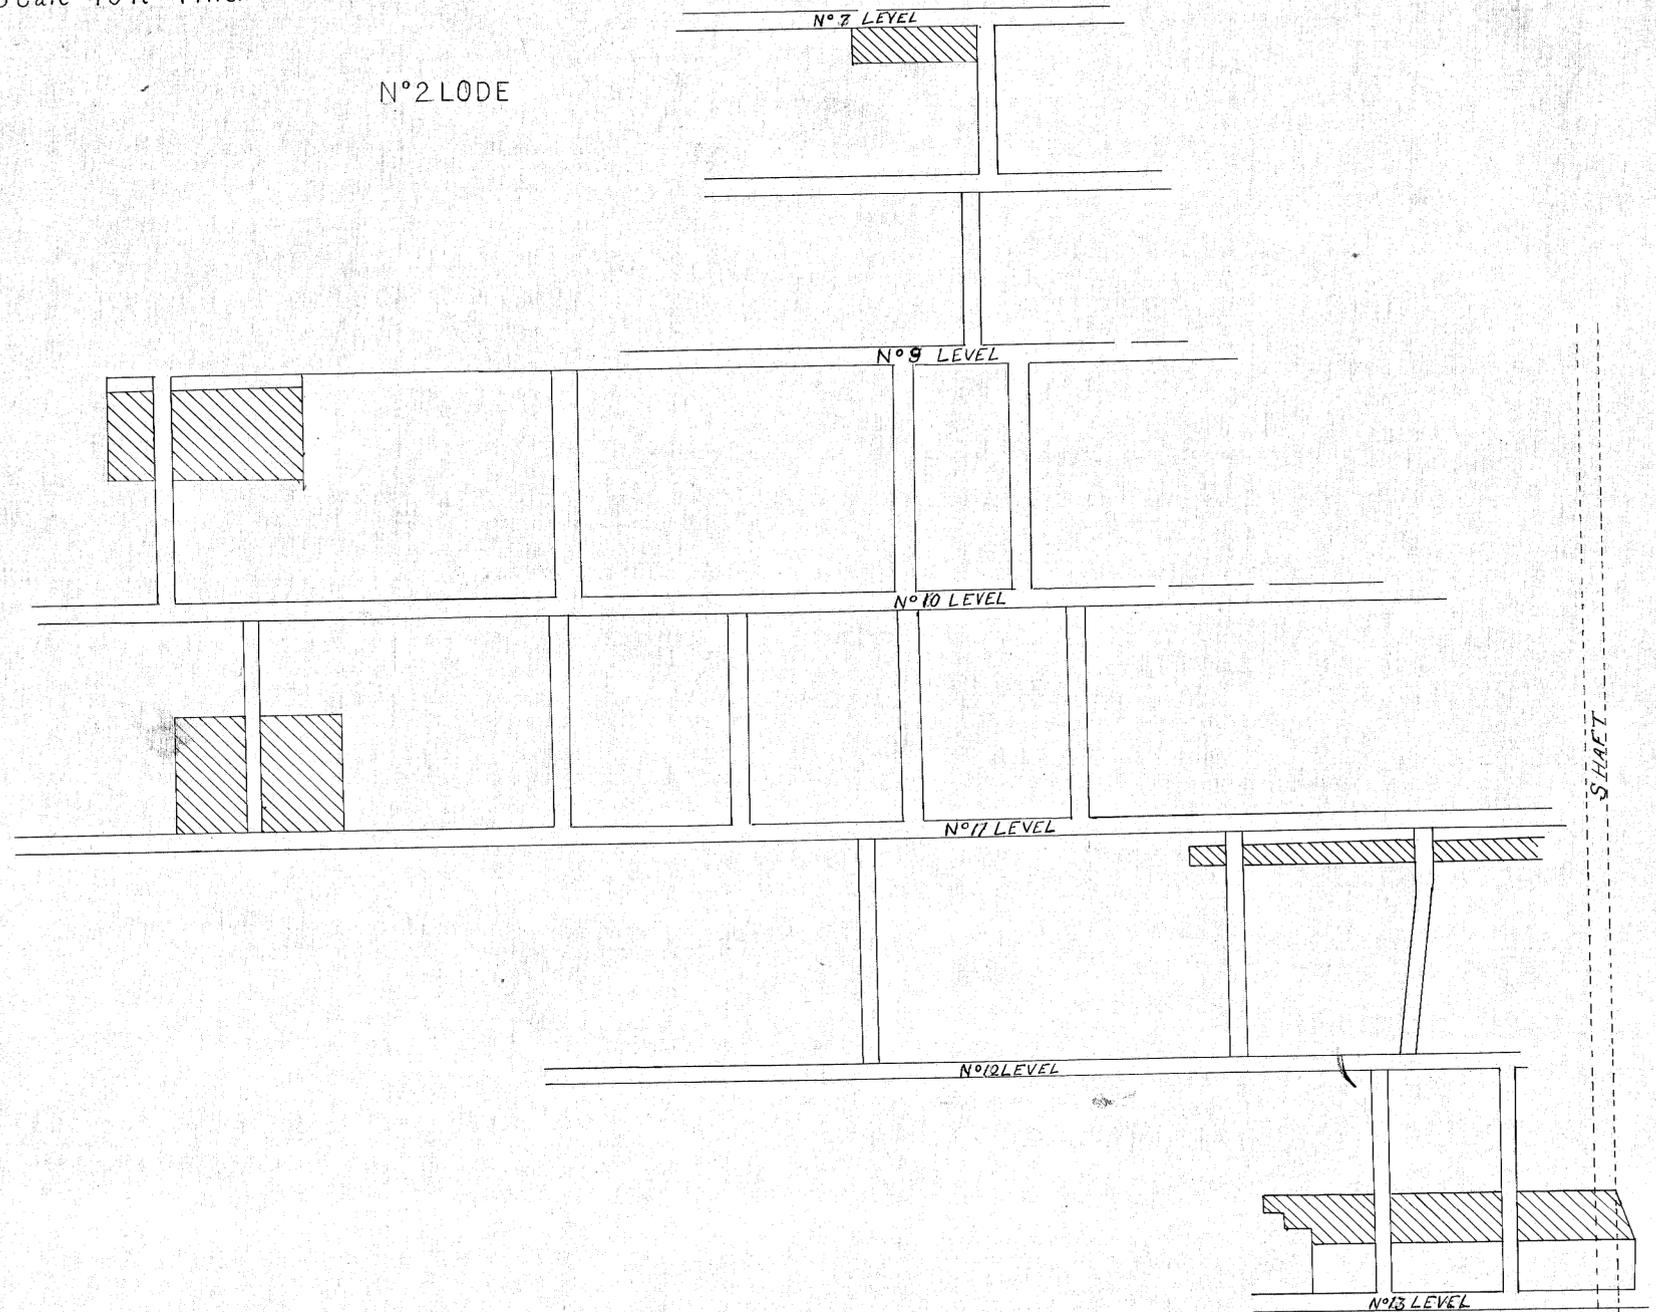

59-51

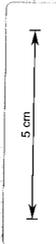

59-51

*W. Doran A.S.M.A.
Mine Surveyor*