



# NORTH MOUNT FARRELL COMPANY, N.L.

## PLAN SHOWING SHAFT LEVELS


— SCALE 40 FEET TO AN INCH —

59-52


59-52

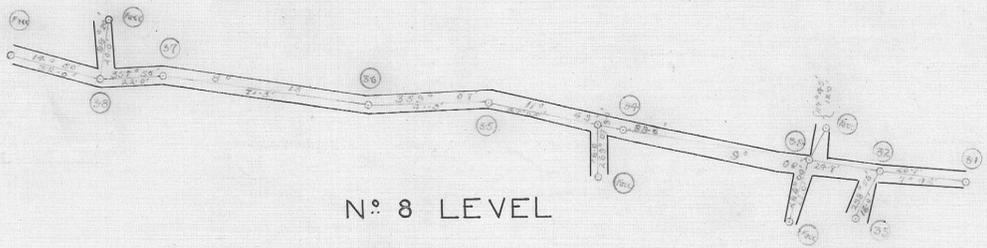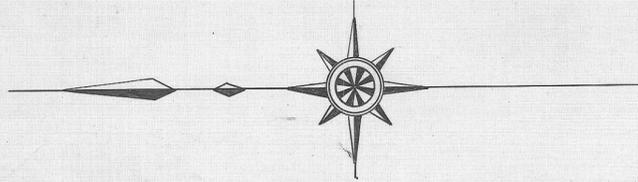


Nº 8 LEVEL

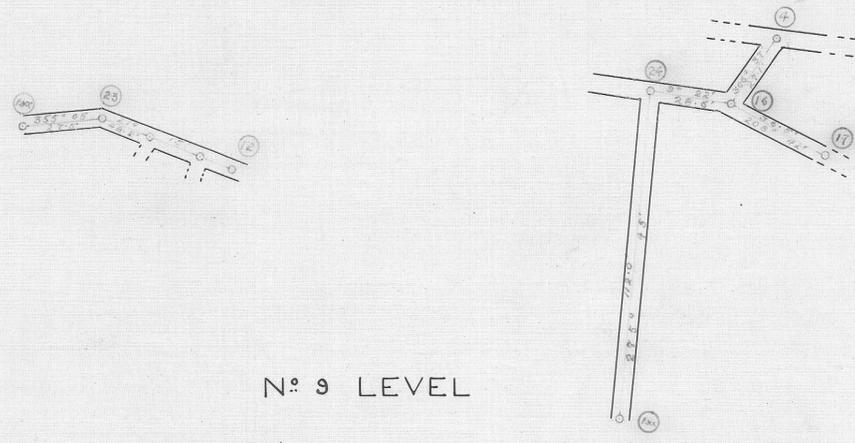

Nº 9 LEVEL

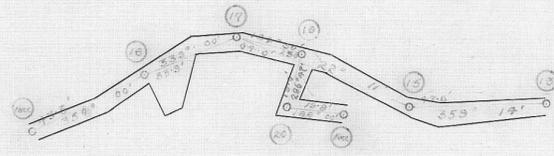

Nº 10 LEVEL

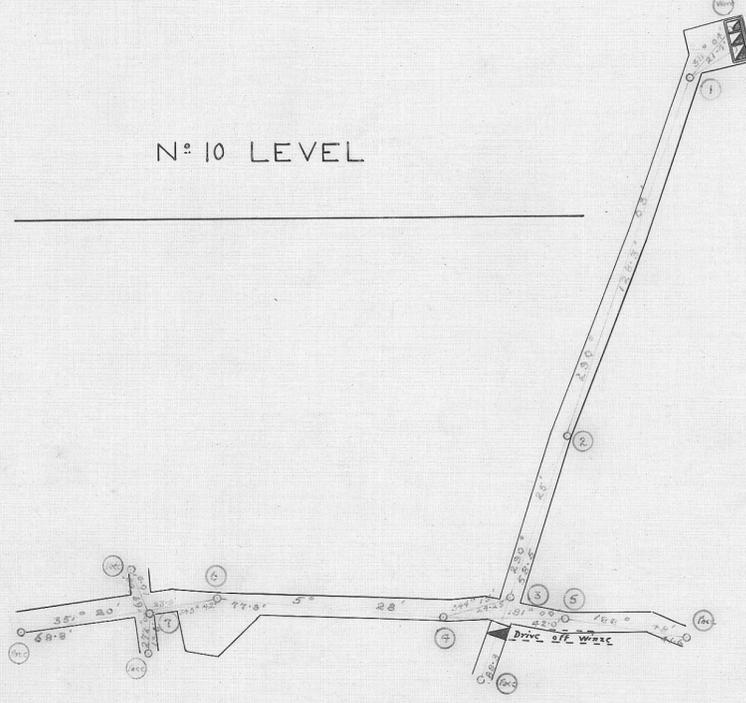

Nº 11 LEVEL

5 cm

note: Traverses run with Meade's  
20' level  
6/24/07