


59-53

# NORTH MOUNT FARRELL C<sup>o</sup>

Scale 40 ft = 1 Inch





SHAFT

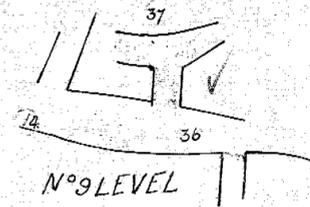

N°12 LEVEL

N°13 LEVEL

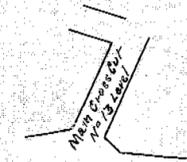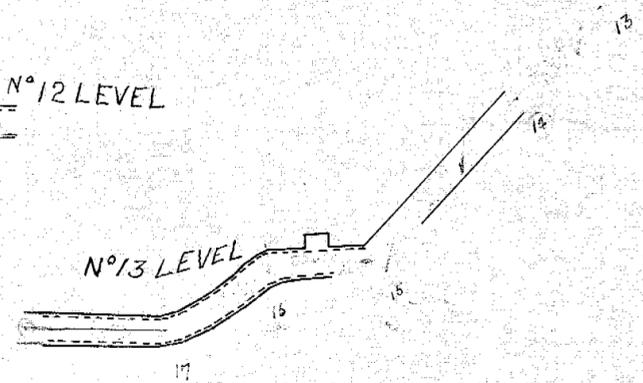

N°12 LEVEL

5 cm

*William A. S.M.M.*  
*Chief Surveyor*

59-53