


59-55


NORTH MOUNT FARRELL COMPANY, N.L.

—WORK DONE FOR 1925—


—Scale 40' = 1" —

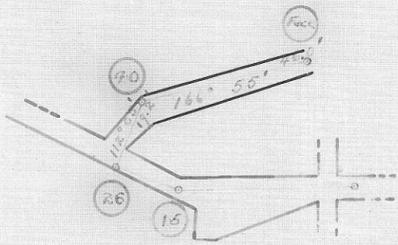


Nº 10 LEVEL

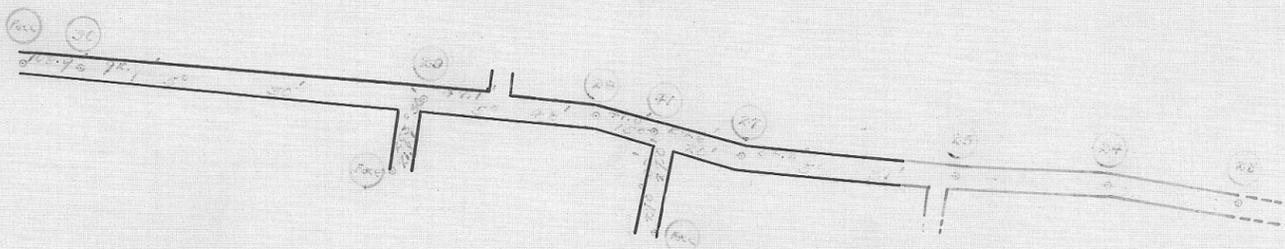

Nº 10 LEVEL

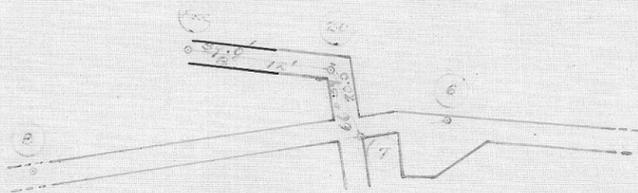

Nº 11 LEVEL

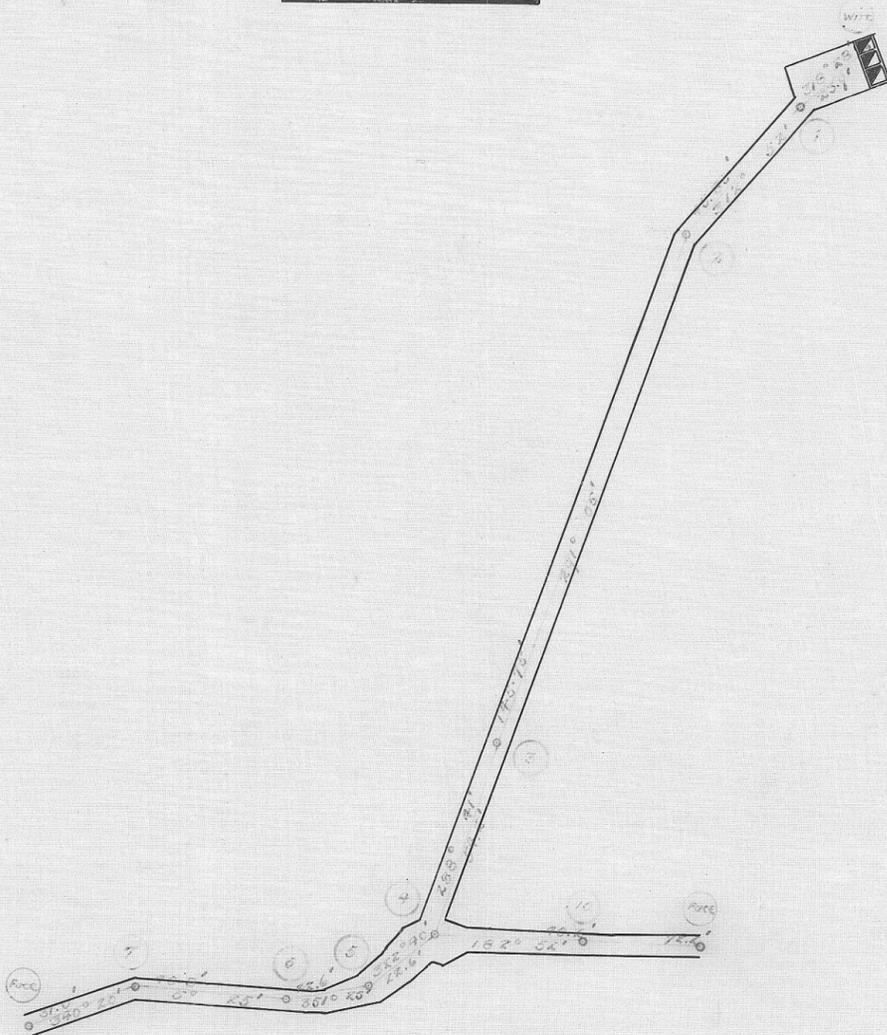

Nº 12 LEVEL

Instrument: — Theodolite
F. B. Baker
SURVEYOR